

Application No. R-76788
Permit No.

MOORE MILL & LBR. CO

Twp. 29s Rge. 13w Sec. 9
Lampa Mainline '92

RECEIVED

DEC 29 1994

WATER RESOURCES DEPT.
SALEM, OREGON

CERTIFICATE NO. 70707


FISHTRAP

RECEIVED

DEC 21 1994

WATER RESOURCES DEPT.
SALEM, OREGON

N
4
1 in. = 1000 ft.

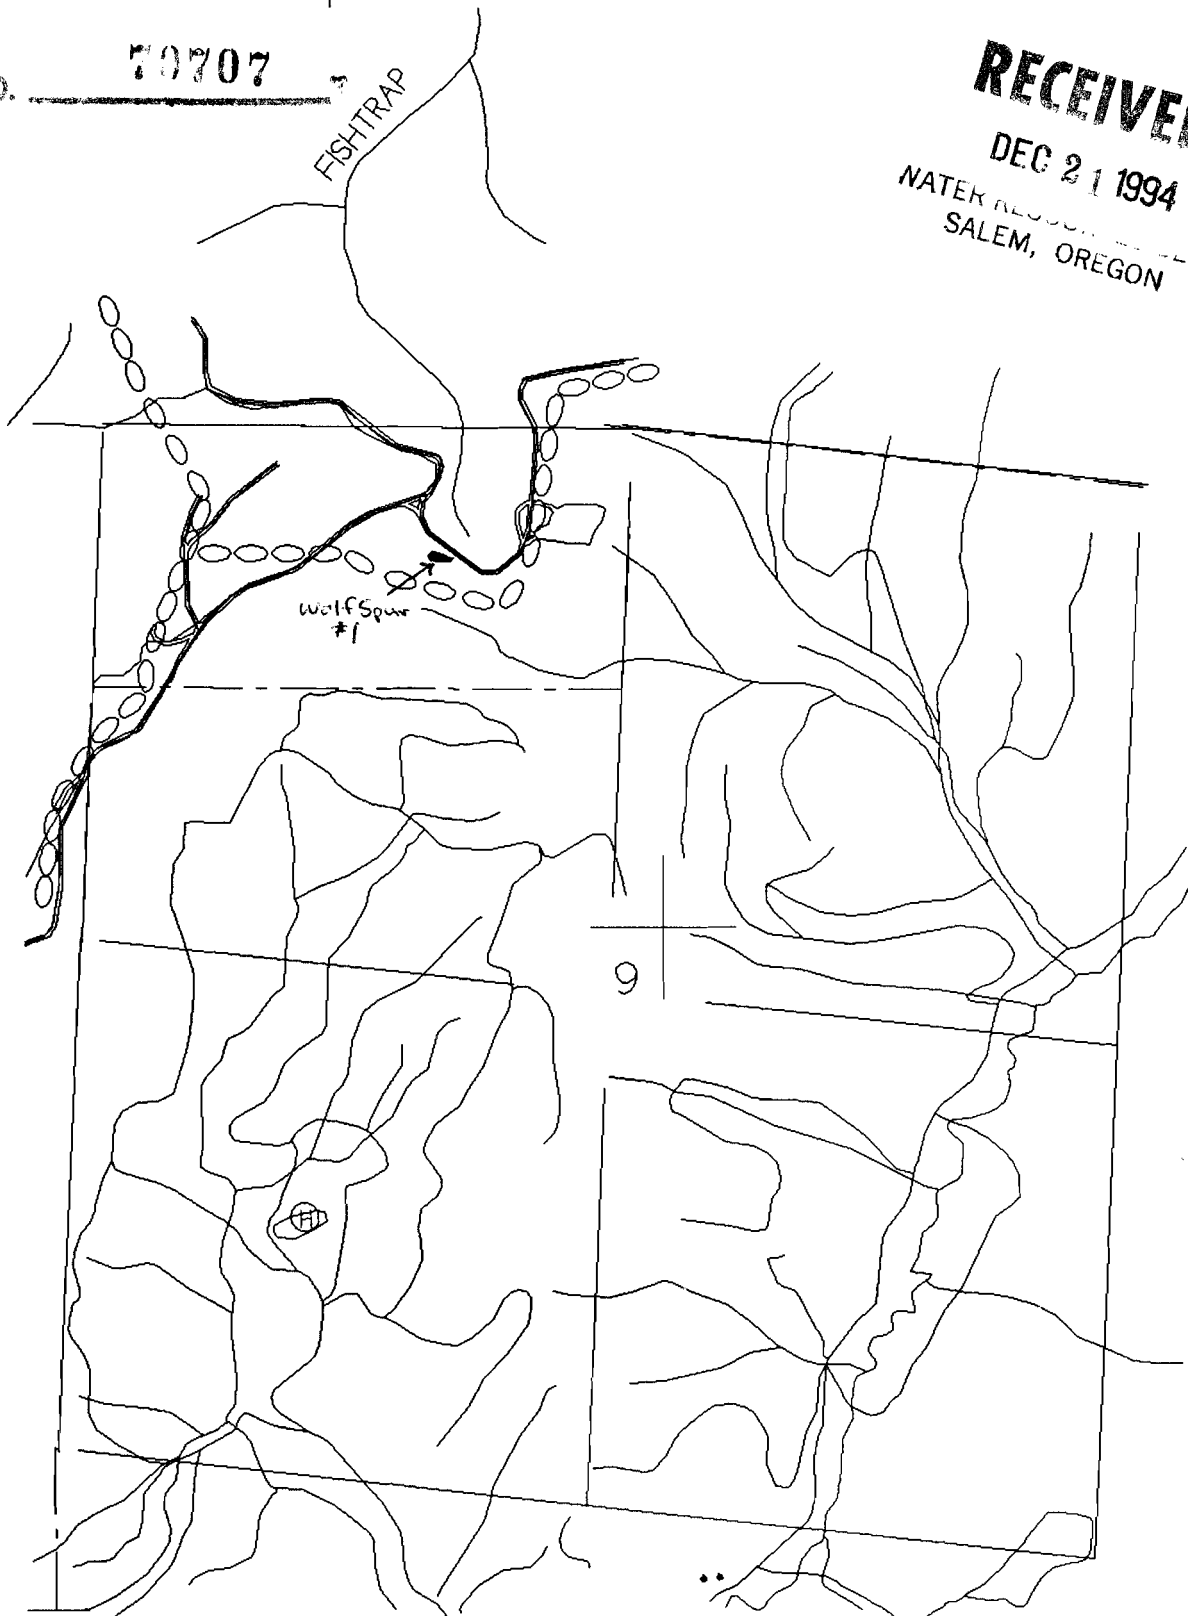

No Final Proof Map available

No Permit Map available