



KEY TITLE COMPANY

THIS COPY OF ASSESSOR'S MAP PROVIDED SOLELY TO ASSIST IN LOCATING SUBJECT PROPERTY. NO LIABILITY IS ASSUMED BY KEY FOR DISCREPANCIES IN THIS MAP AS OUTLINED AND THE ACCOMPANYING LEGAL DESCRIPTION.

1-04

78711


"CERTIFICATE NO.

Application No. *R-76792*
Permit No.

RECEIVED

DEC 29 1994

WATER RESOURCES DEPT.
SALEM, OREGON

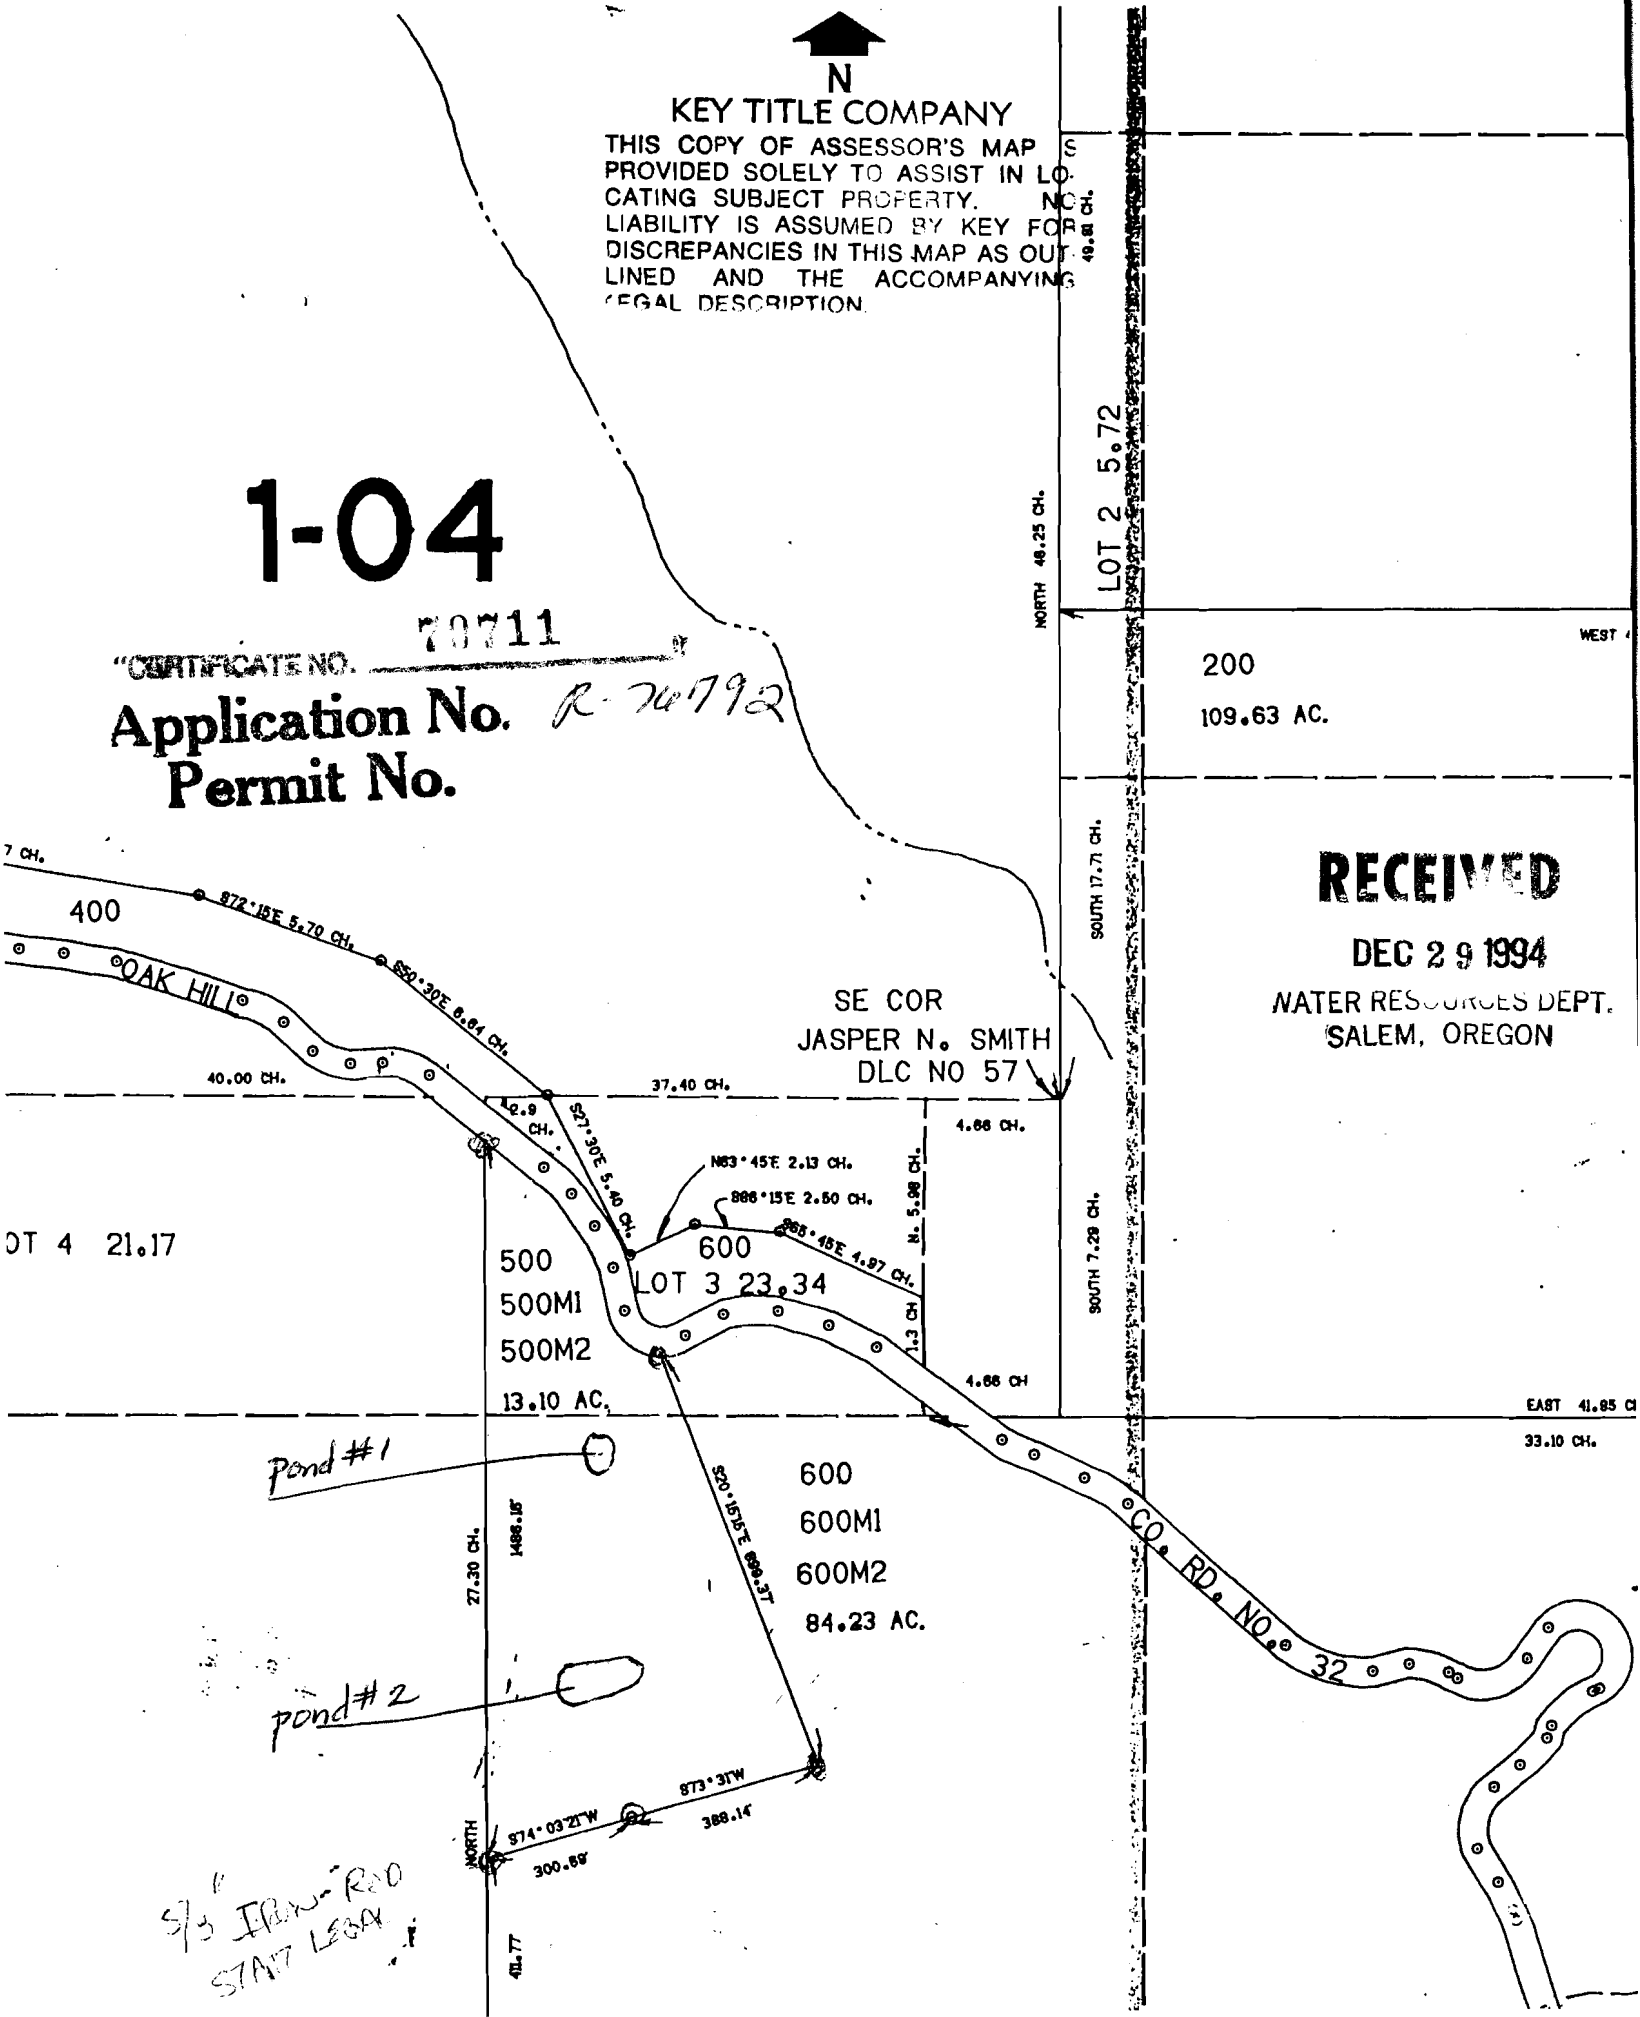

No Final Proof Map available

No Permit Map available