

Application No. R-76799
Permit No.

RECEIVED


CERTIFICATE NO. 70718

DEC 30 1994

WATER RESOURCES DEPT.
SALEM, OREGON

LEGEND

NE 1/4 NW 1/4 SECTION 29 T.22S. R.4W.
Ⓟ = POND LOCATION

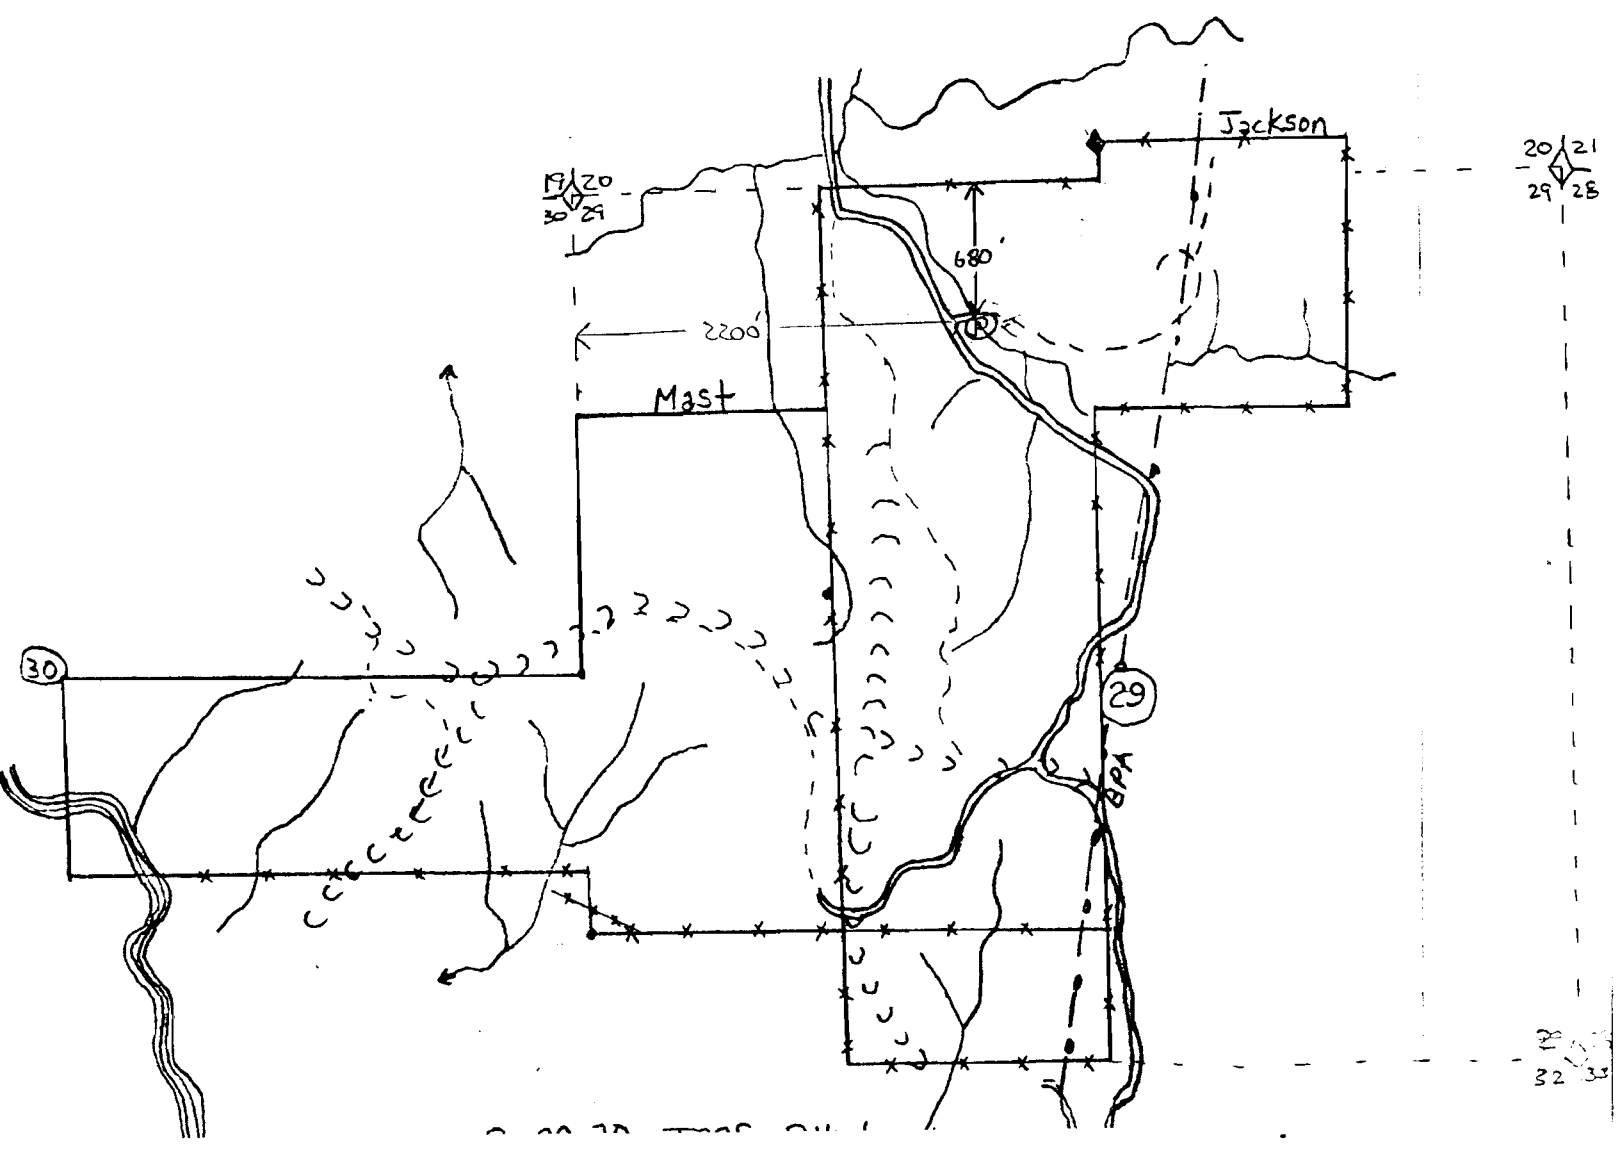

No Final Proof Map available

No Permit Map available