


RECEIVED

DEC 5 9 1934

HOLM & HOLM
652 AC
SALMON, OREGON

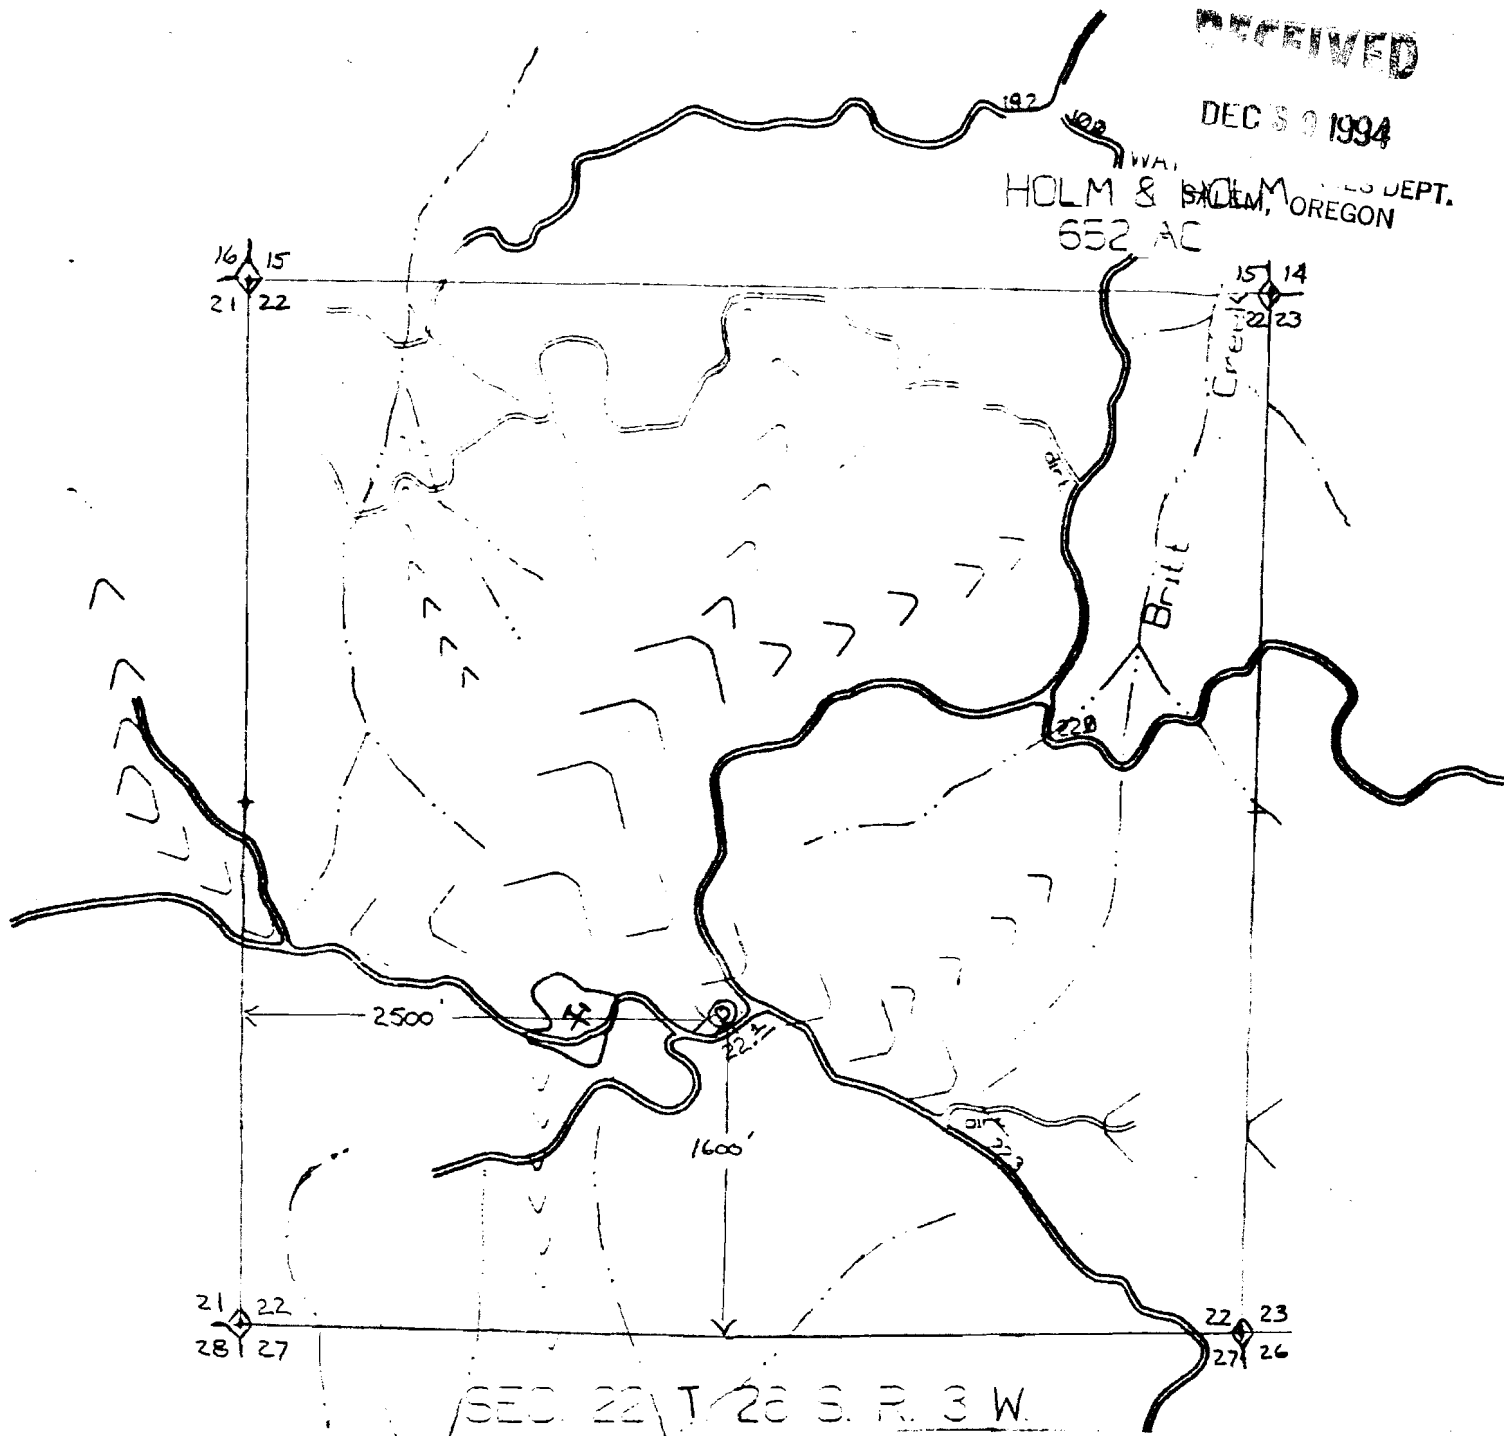

LEGEND

NE 1/4 SW 1/4 SECTION 22 T. 26 S. R. 3 W.

⊙ = POND LOCATION

Application No. R-76800
Permit No.

CERTIFICATE NO. 70719