


T 13 S, R 44 E, W. M., ORE.

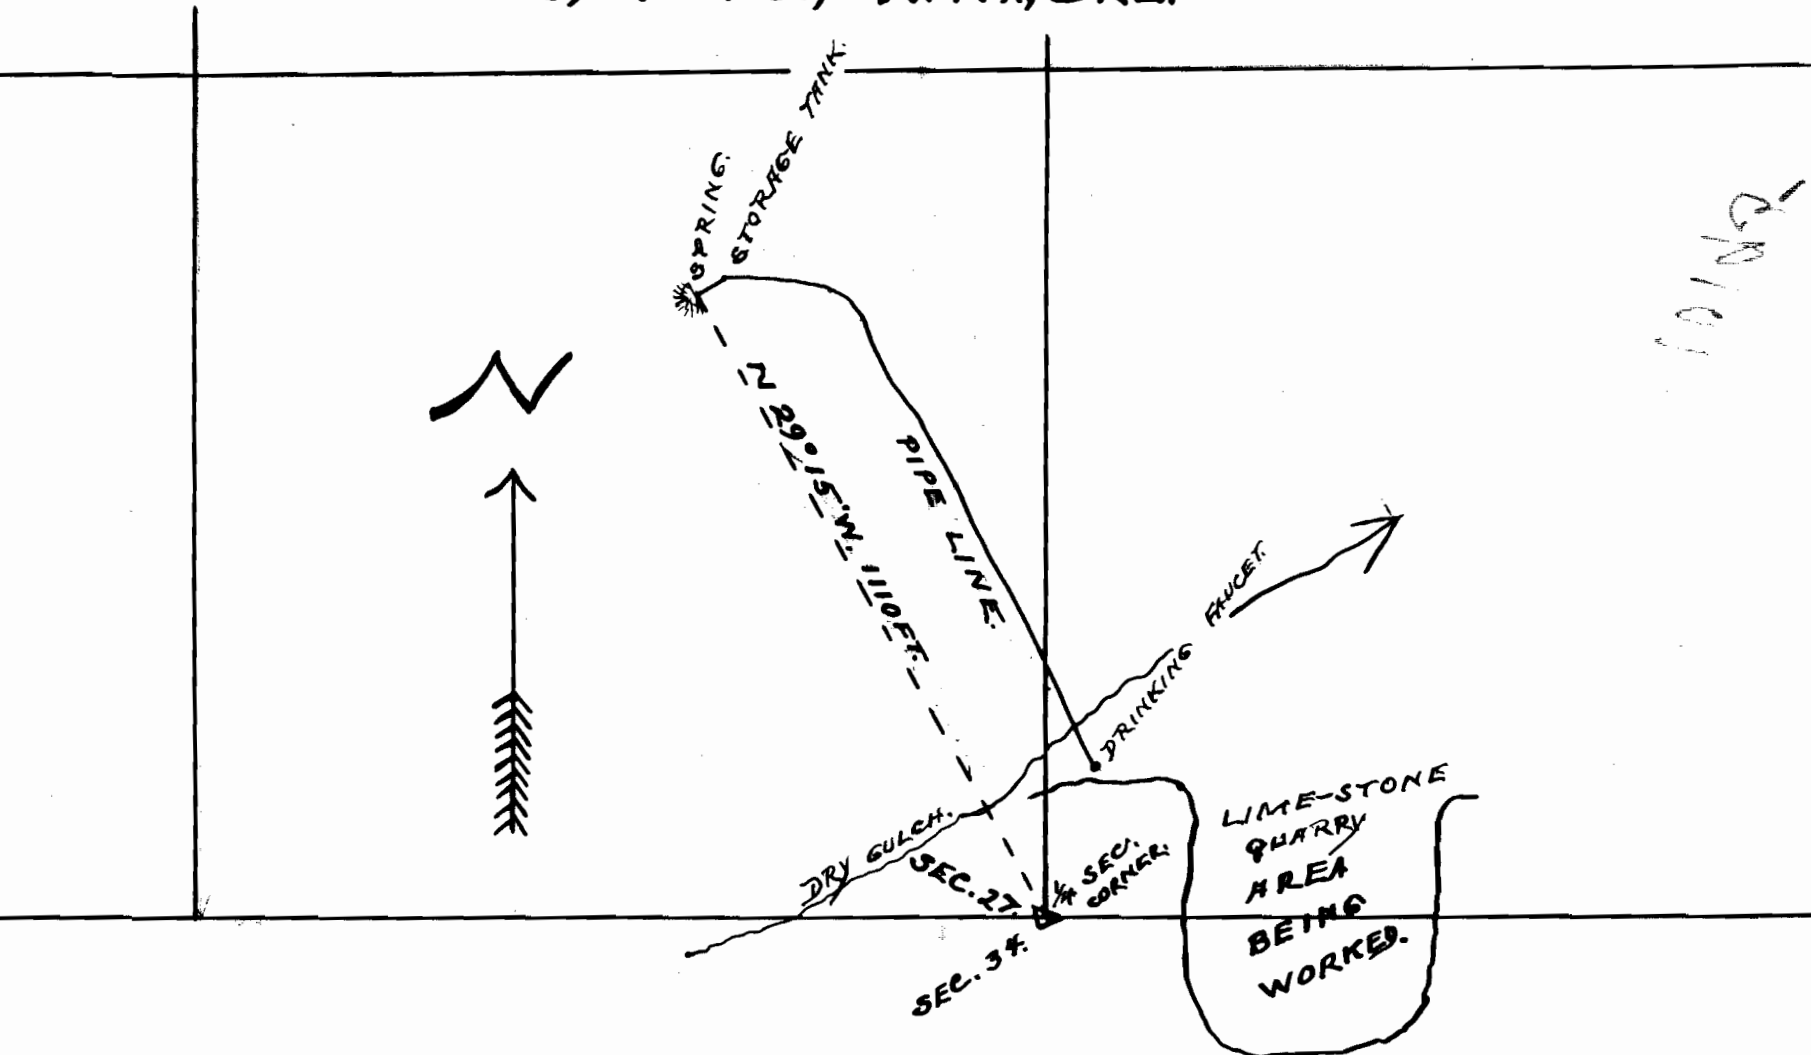

SKETCH

SHOWING

THE LOCATION OF THE SOURCE
USAGE POINT OF CERTAIN WATER
DEVELOPED + LOCATED BY THE SUN
PORTLAND CEMENT CO. IN SEC. 27,
T 13 S. R 44 E, W. M. BAKER, ORE.

SCALE, ONE INCH = 300 FT.
SURVEYED MAY 13, 1925

Ira L. Hoffman
County Surveyor.

CERTIFICATE OF SURVEYOR.

I, IRA L. HOFFMAN OF BAKER, ORE.,
DO HEREBY CERTIFY THAT THIS MAP
WAS MADE FROM NOTES TAKEN DUR-
ING AN ACTUAL SURVEY MADE BY ME
ON MAY 13, 1925 & THAT IT CORRECT-
LY REPRESENTS THE DATA SHOWN
THEREON.

Ira L. Hoffman.



STATE ENGINEER
RECEIVED

MAY 24 1925

SALEW, OREGON

Application No. 10195
Permit No. 6921.