


RECEIVED

DEC 30 1994

WATER RESOURCES DEPT.
SALEM, OREGON

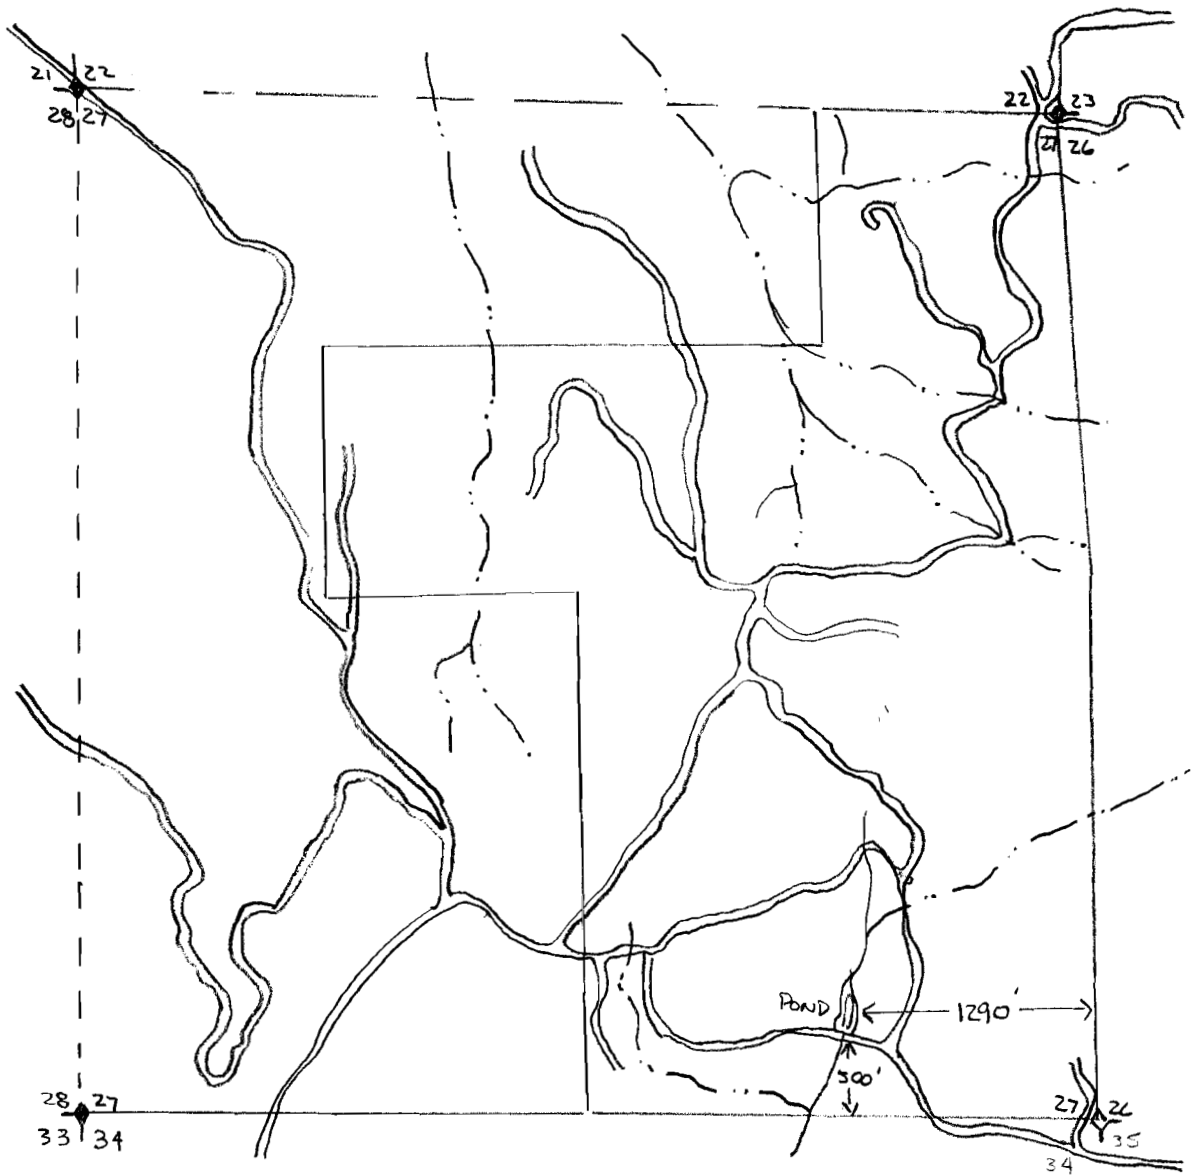

LEGEND

① POND SE 1/4 SE 1/4 SE 1/4 SECTION 27 T.26S. R.8W.

Application No. R-76801
Permit No.

CERTIFICATE NO. 70720

No Final Proof Map available

No Permit Map available