

30, 28-3


Umpqua #5

slide Creek

RECEIVED

DEC 30 1994

WATER RES.
SALEM, OREGON

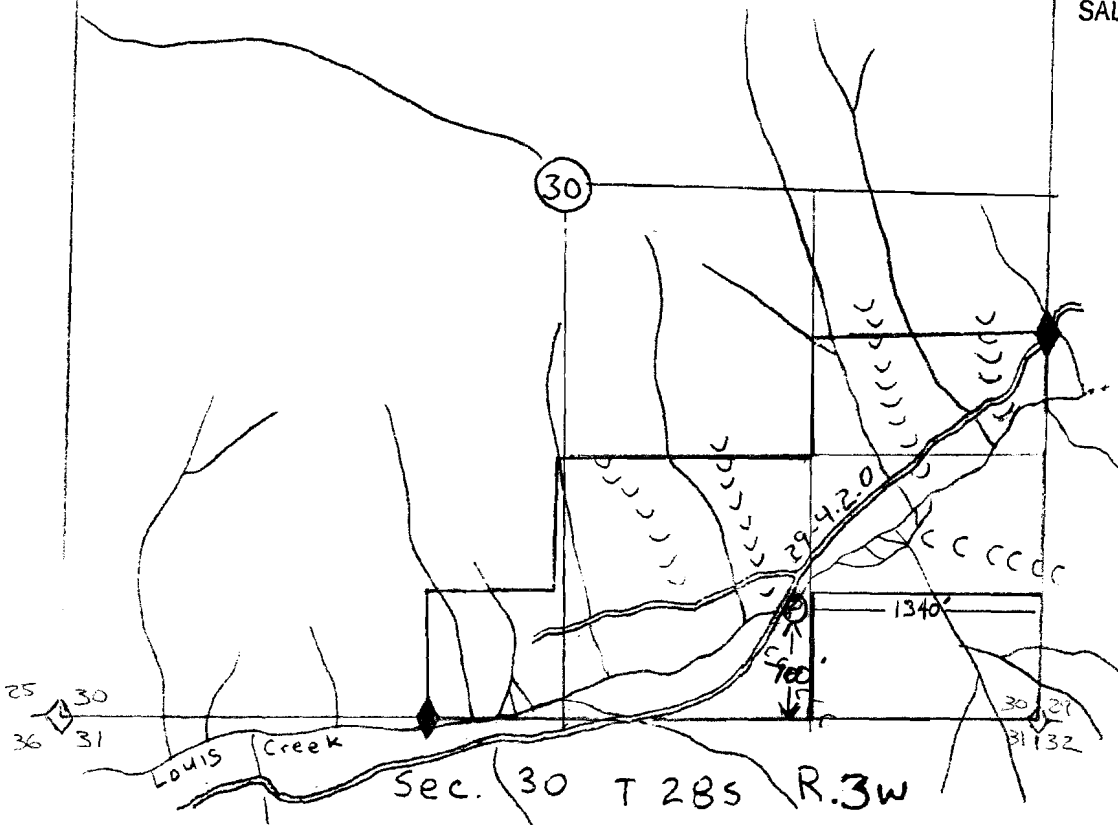

LEGEND

SW 1/4 SE 1/4 SECTION 30 T.28 S R3 W

(P) = POND LOCATION

Application No. R-76802
Permit No.

"CERTIFICATE NO. 70721"

No Final Proof Map available

No Permit Map available