


BMH 7208

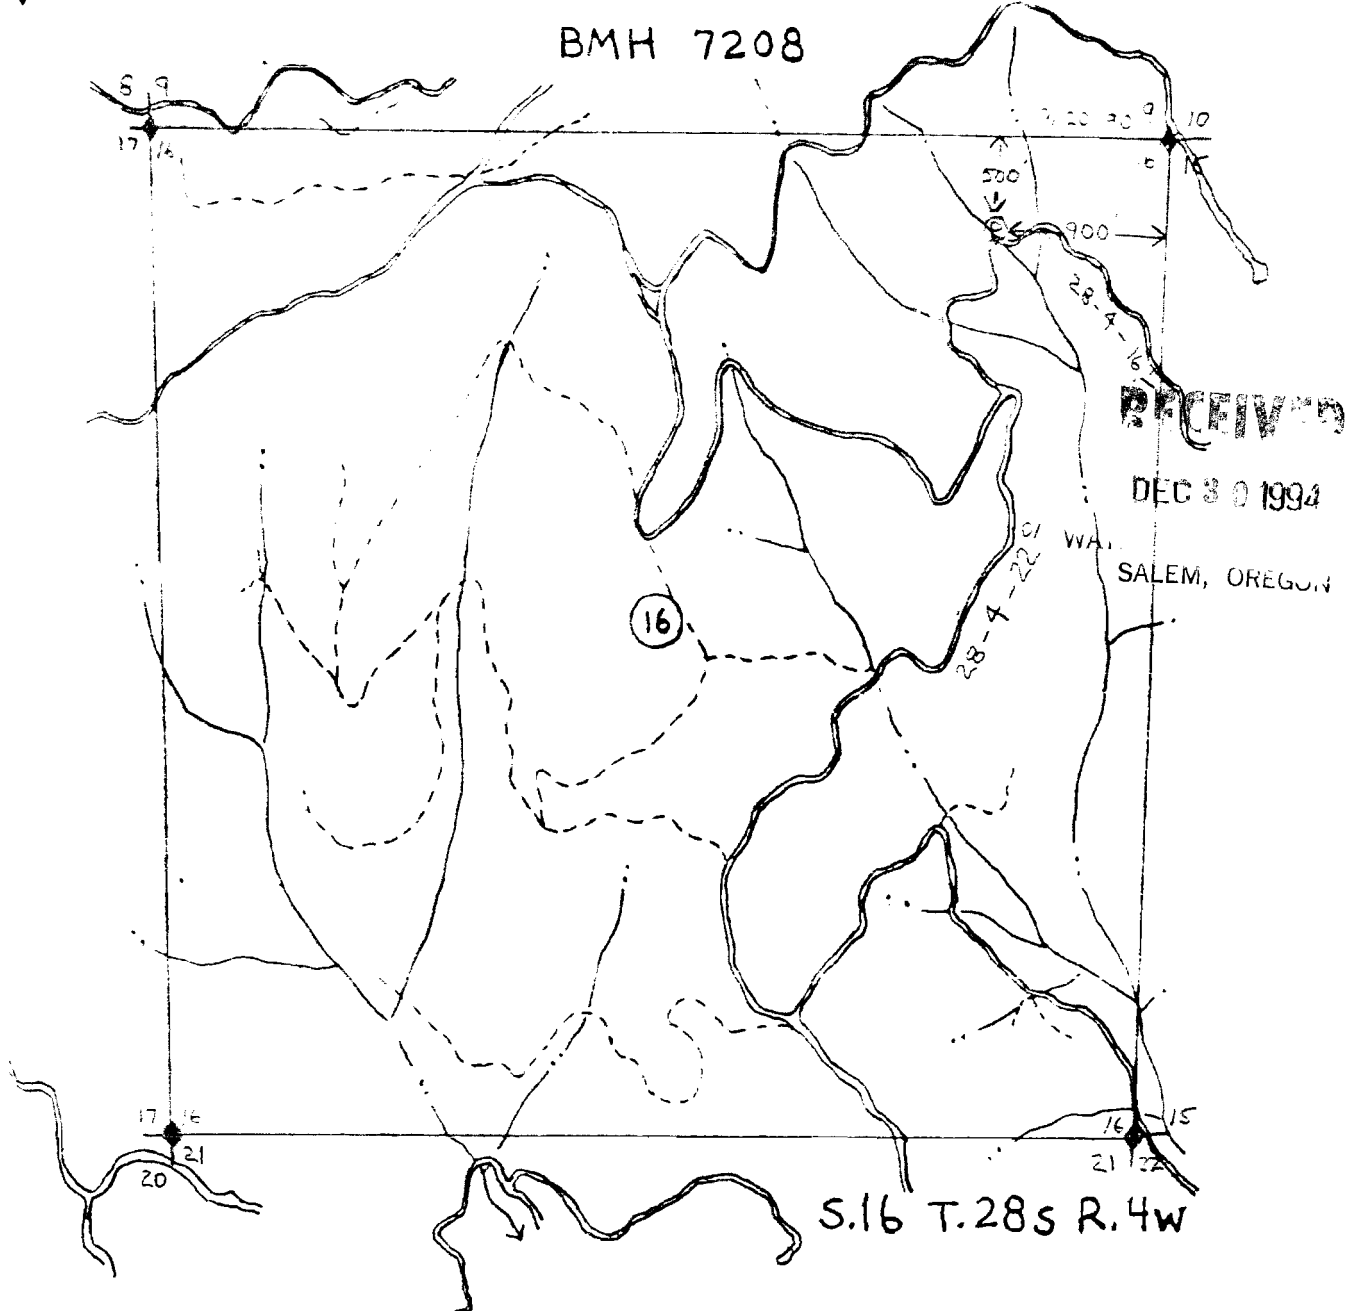

LEGEND

N.E. 1/4 N.E. 1/4 SECTION 16 T.28S. R.4W.

Ⓟ = POND LOCATION

Application No. R-76803  
Permit No.

CERTIFICATE NO. 70722

No Final Proof Map available

No Permit Map available