


Application No. R-70805  
Permit No.

DEC 3 1994

WATER DIVISION  
SALEM, OREGON

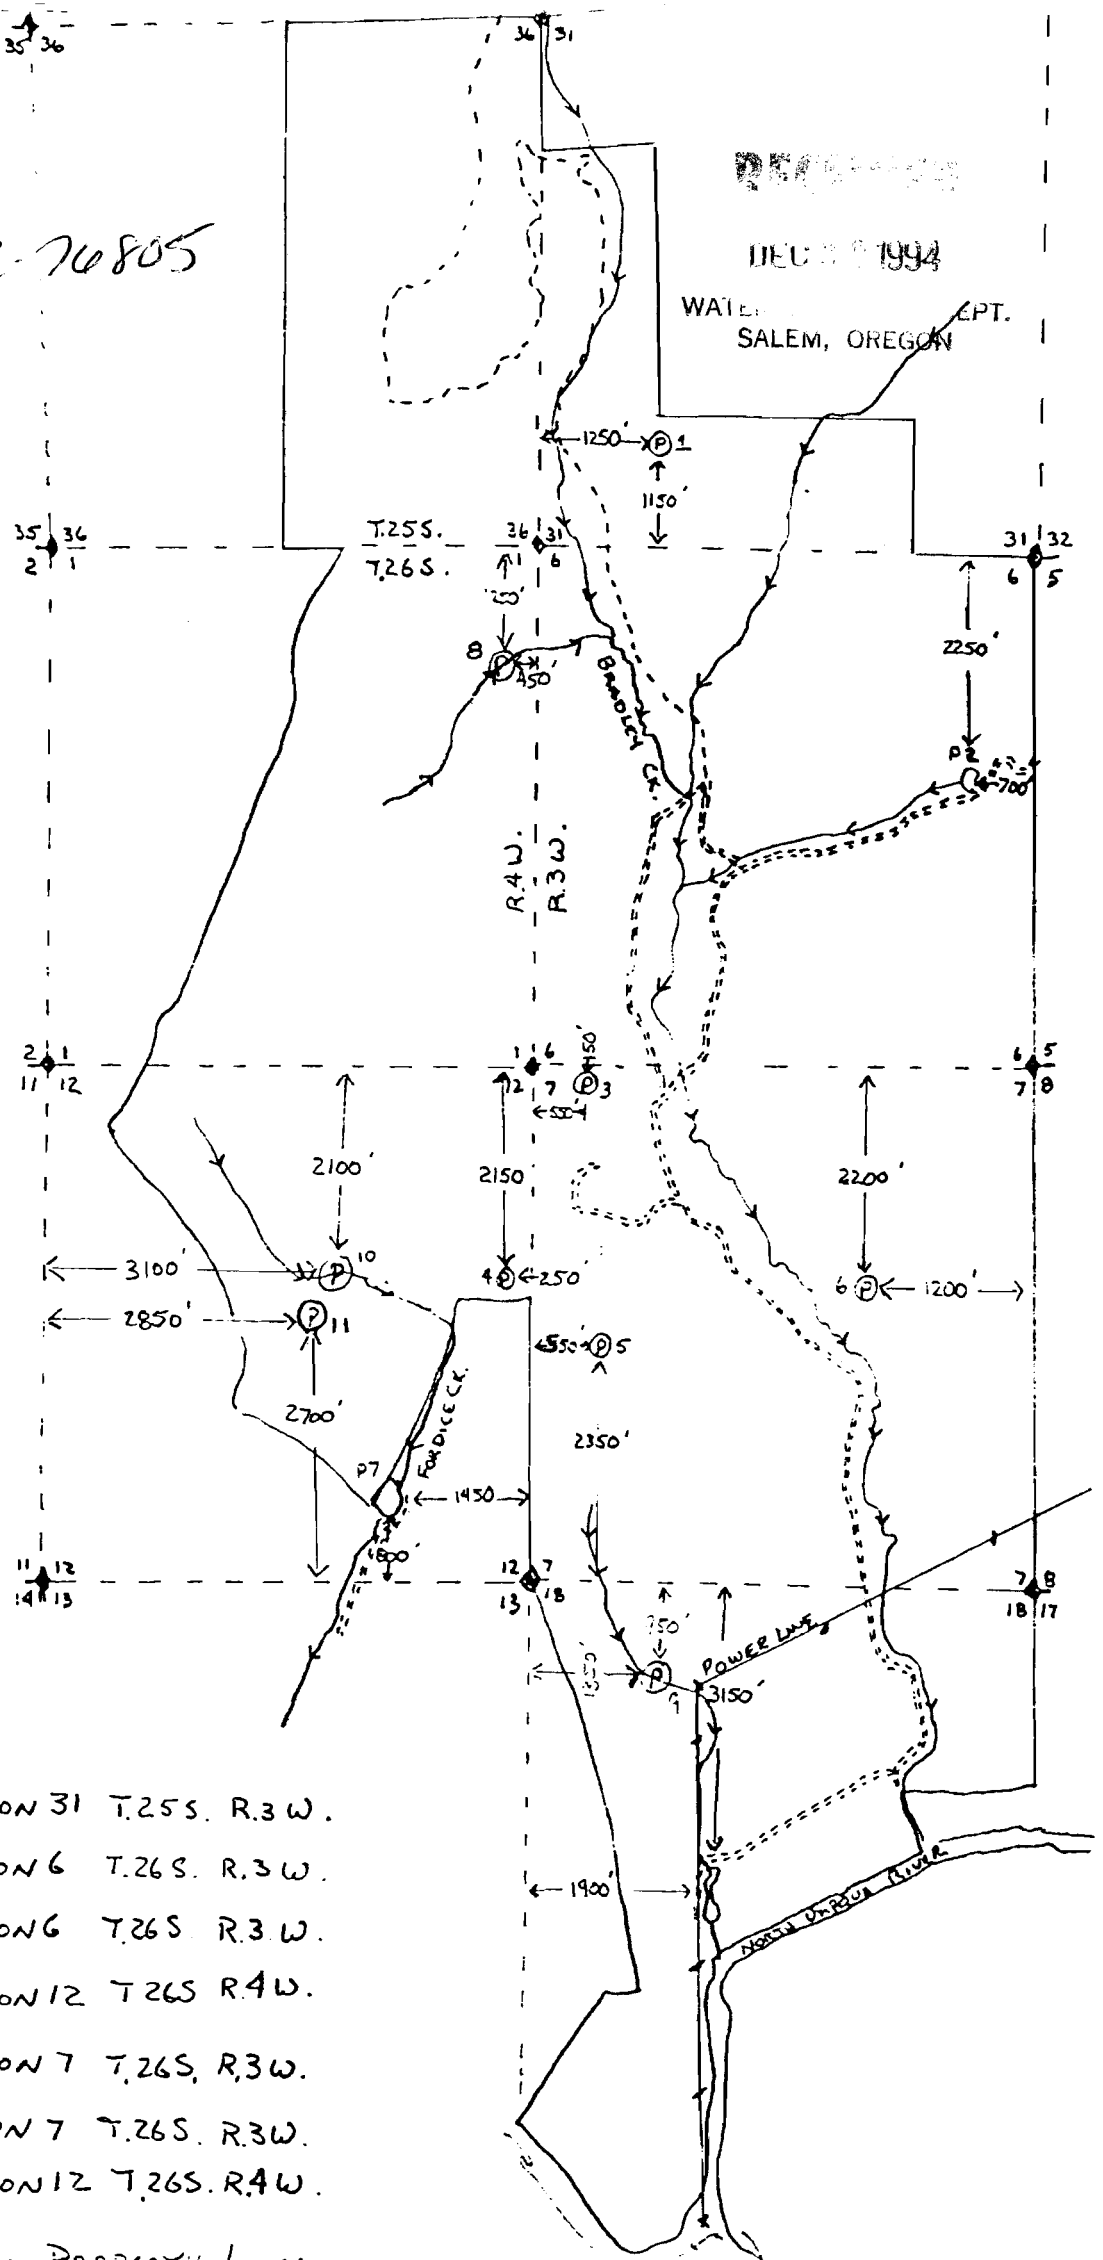

### LEGEND

Ⓟ1 SW 1/4 SW 1/4 SECTION 31 T.25S. R.3W.

P2 SE 1/4 NE 1/4 SECTION 6 T.26S. R.3W.

Ⓟ3 NW 1/4 NW 1/4 SECTION 6 T.26S. R.3W.

Ⓟ4 SE 1/4 NE 1/4 SECTION 12 T.26S. R.4W.

Ⓟ5 NW 1/4 SW 1/4 SECTION 7 T.26S. R.3W.

Ⓟ6 SE 1/4 NE 1/4 SECTION 7 T.26S. R.3W.

P7 SW 1/4 SE 1/4 SECTION 12 T.26S. R.4W.

— LONE ROCK TIMBER PROPERTY LINES

--- SECTION LINES

P8 NE 1/4 NE 1/4 SECTION 1 T.26S. R.4W.

P9 NE 1/4 NW 1/4 SECTION 18 T.26S. R.3W.

P10 SW 1/4 NE 1/4 SECTION 12 T.26S. R.4W.

P11 SW 1/4 NE 1/4 SECTION 12 T.26S. R.4W.

CERTIFICATE NO. 70724

PONDS 8 THRU 11 ARE NEW PONDS CONSTRUCTED IN 1994

No Final Proof Map available

No Permit Map available