

T.26 S. R.3 W. SECTION 18

RECEIVED

DEC 30 1994


WATER RESOURCES DEPT.  
SALEM, OREGON

LEGEND

P8 NE<sup>1</sup>/<sub>4</sub> SW<sup>1</sup>/<sub>4</sub> SECTION 18 T.26 S. R.3 W.

THIS POND IS SHOWN ON USGS. 7.5 MIN QUAD  
MAP COMPILED FROM AERIAL PHOTO'S TAKEN IN 1982

"OPTIONAL" NO. 70729

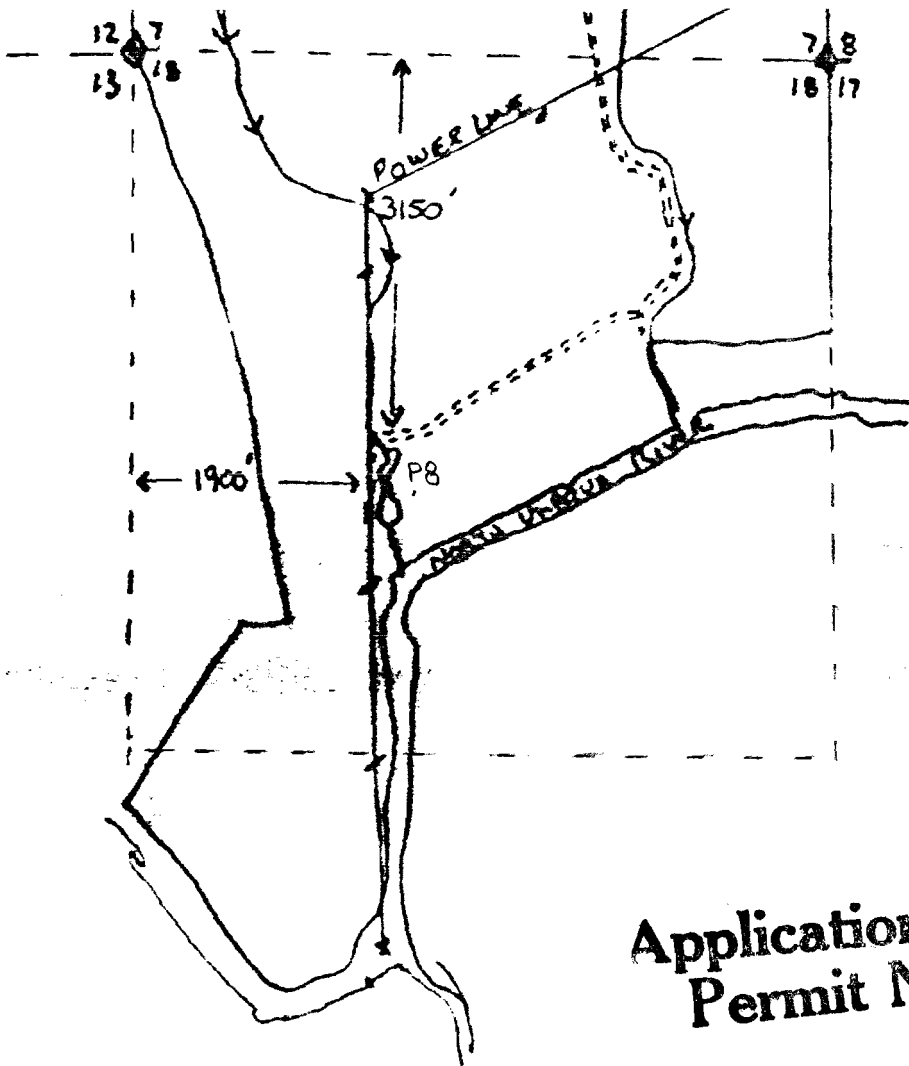

Application No. R-76810  
Permit No.

No Final Proof Map available

No Permit Map available