


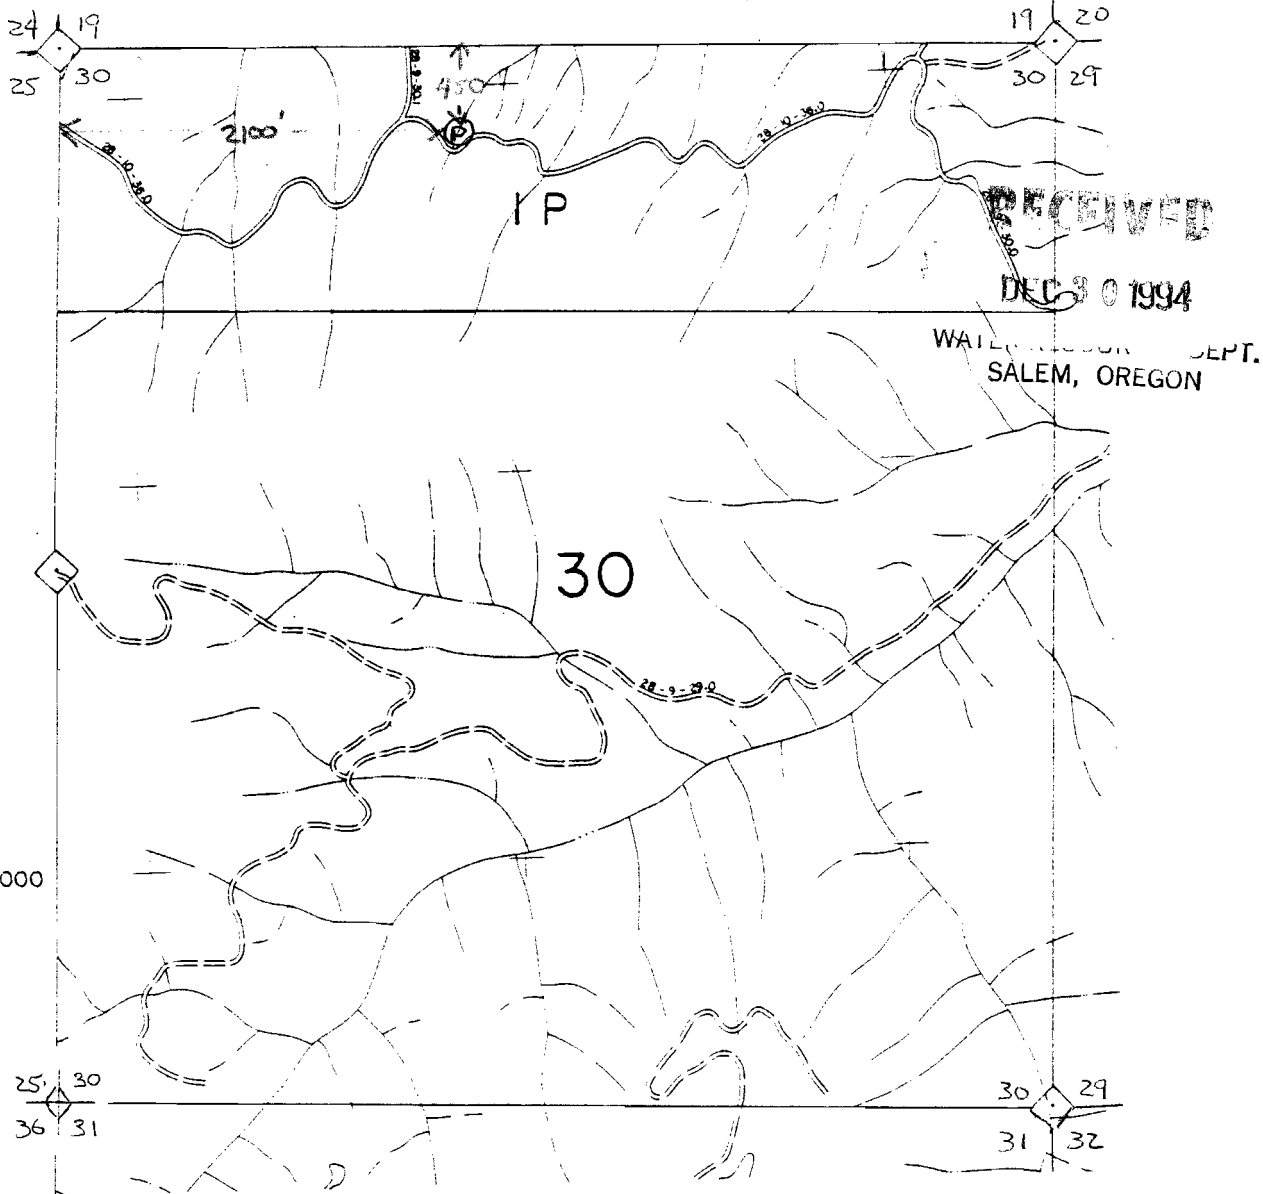


LEGEND

NE 1/4 NW 1/4 SECTION 30 T.28 S. R.9 W.

⊙ = POND LOCATION

Application No. R-76811
Permit No.

"CERTIFICATE NO. 70730"

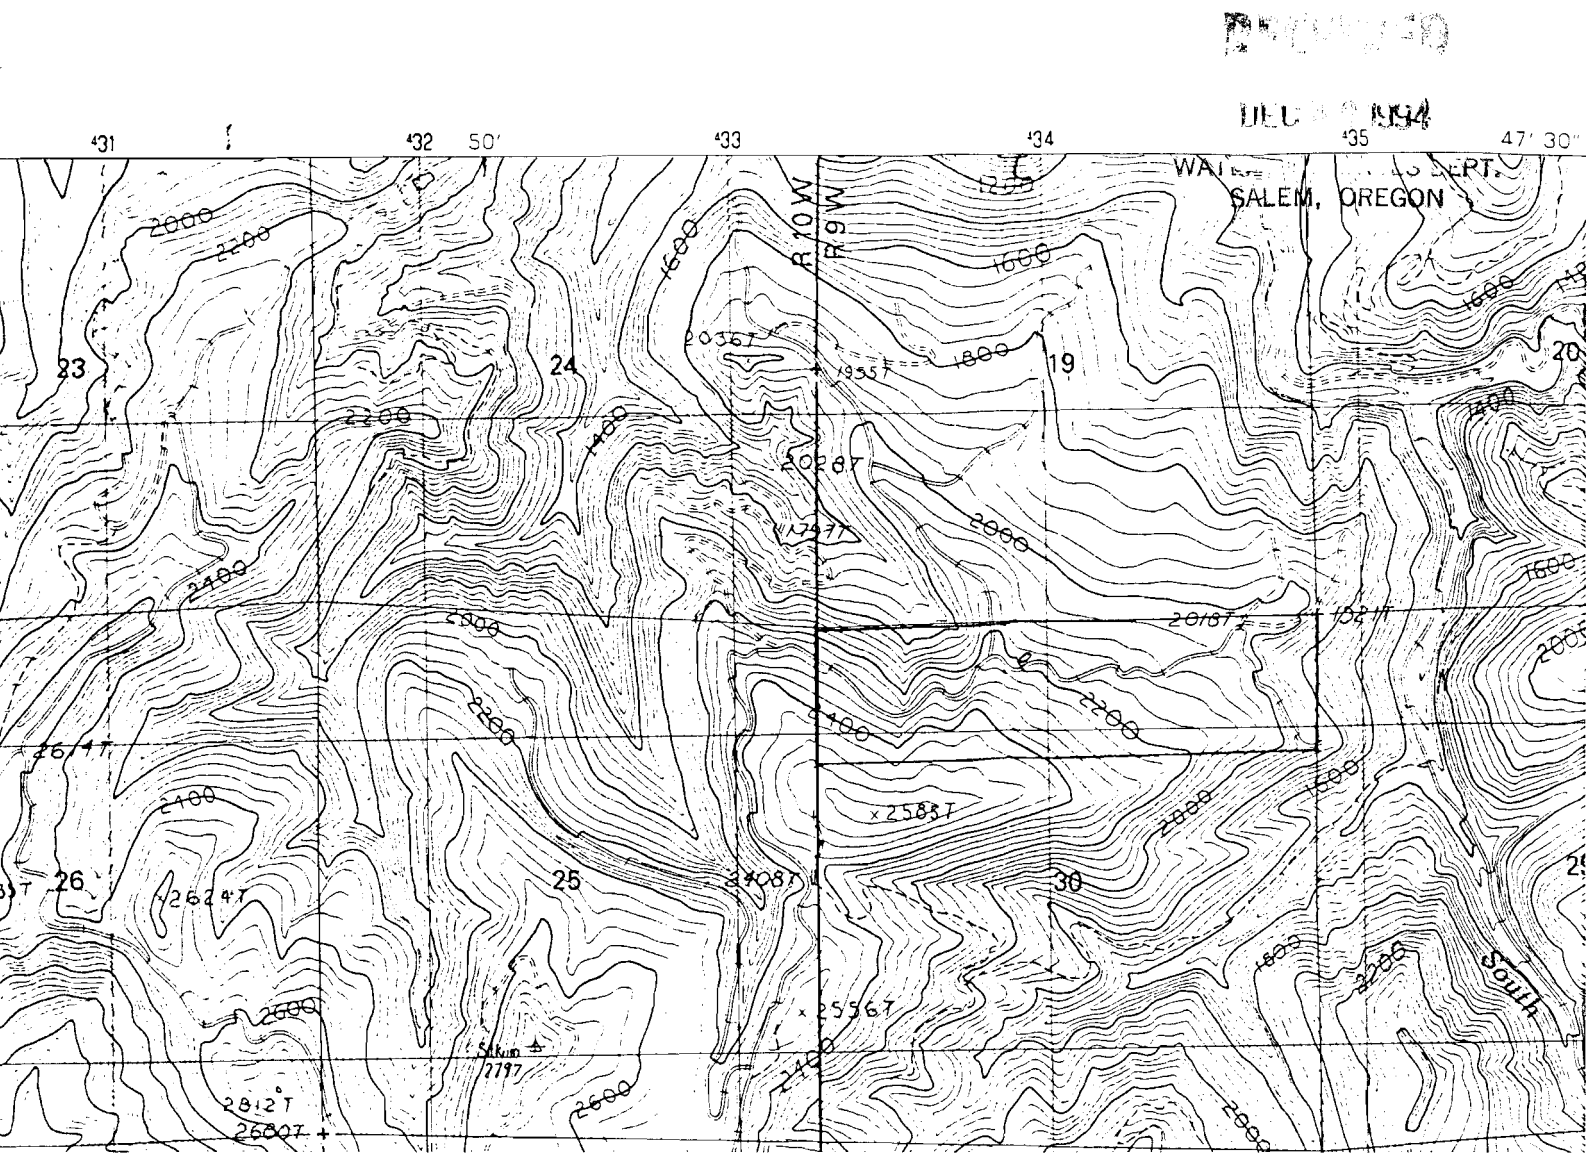

Application No. R-76811
Permit No.

LEGEND

NE 1/4 NW 1/4 SECTION 30 T 28 S. R. 9. W.

c = POND LOCATION

THIS IS A COPY OF A USGS TOPOG MAP THAT SHOWS THIS
 POND. THE MAP WAS COMPILED FROM AERIAL PHOTOGRAPHS
 TAKEN IN 1984

70730

No Final Proof Map available

No Permit Map available