

Application No. R-76814
Permit No.

CERTIFICATE NO. 70733


RECEIVED

DEC 30 1994

WATER RESOURCES DEPT.
SALEM, OREGON

LEGEND

NE 1/4 SW 1/4 SECTION 14
T.23S. R.12W.

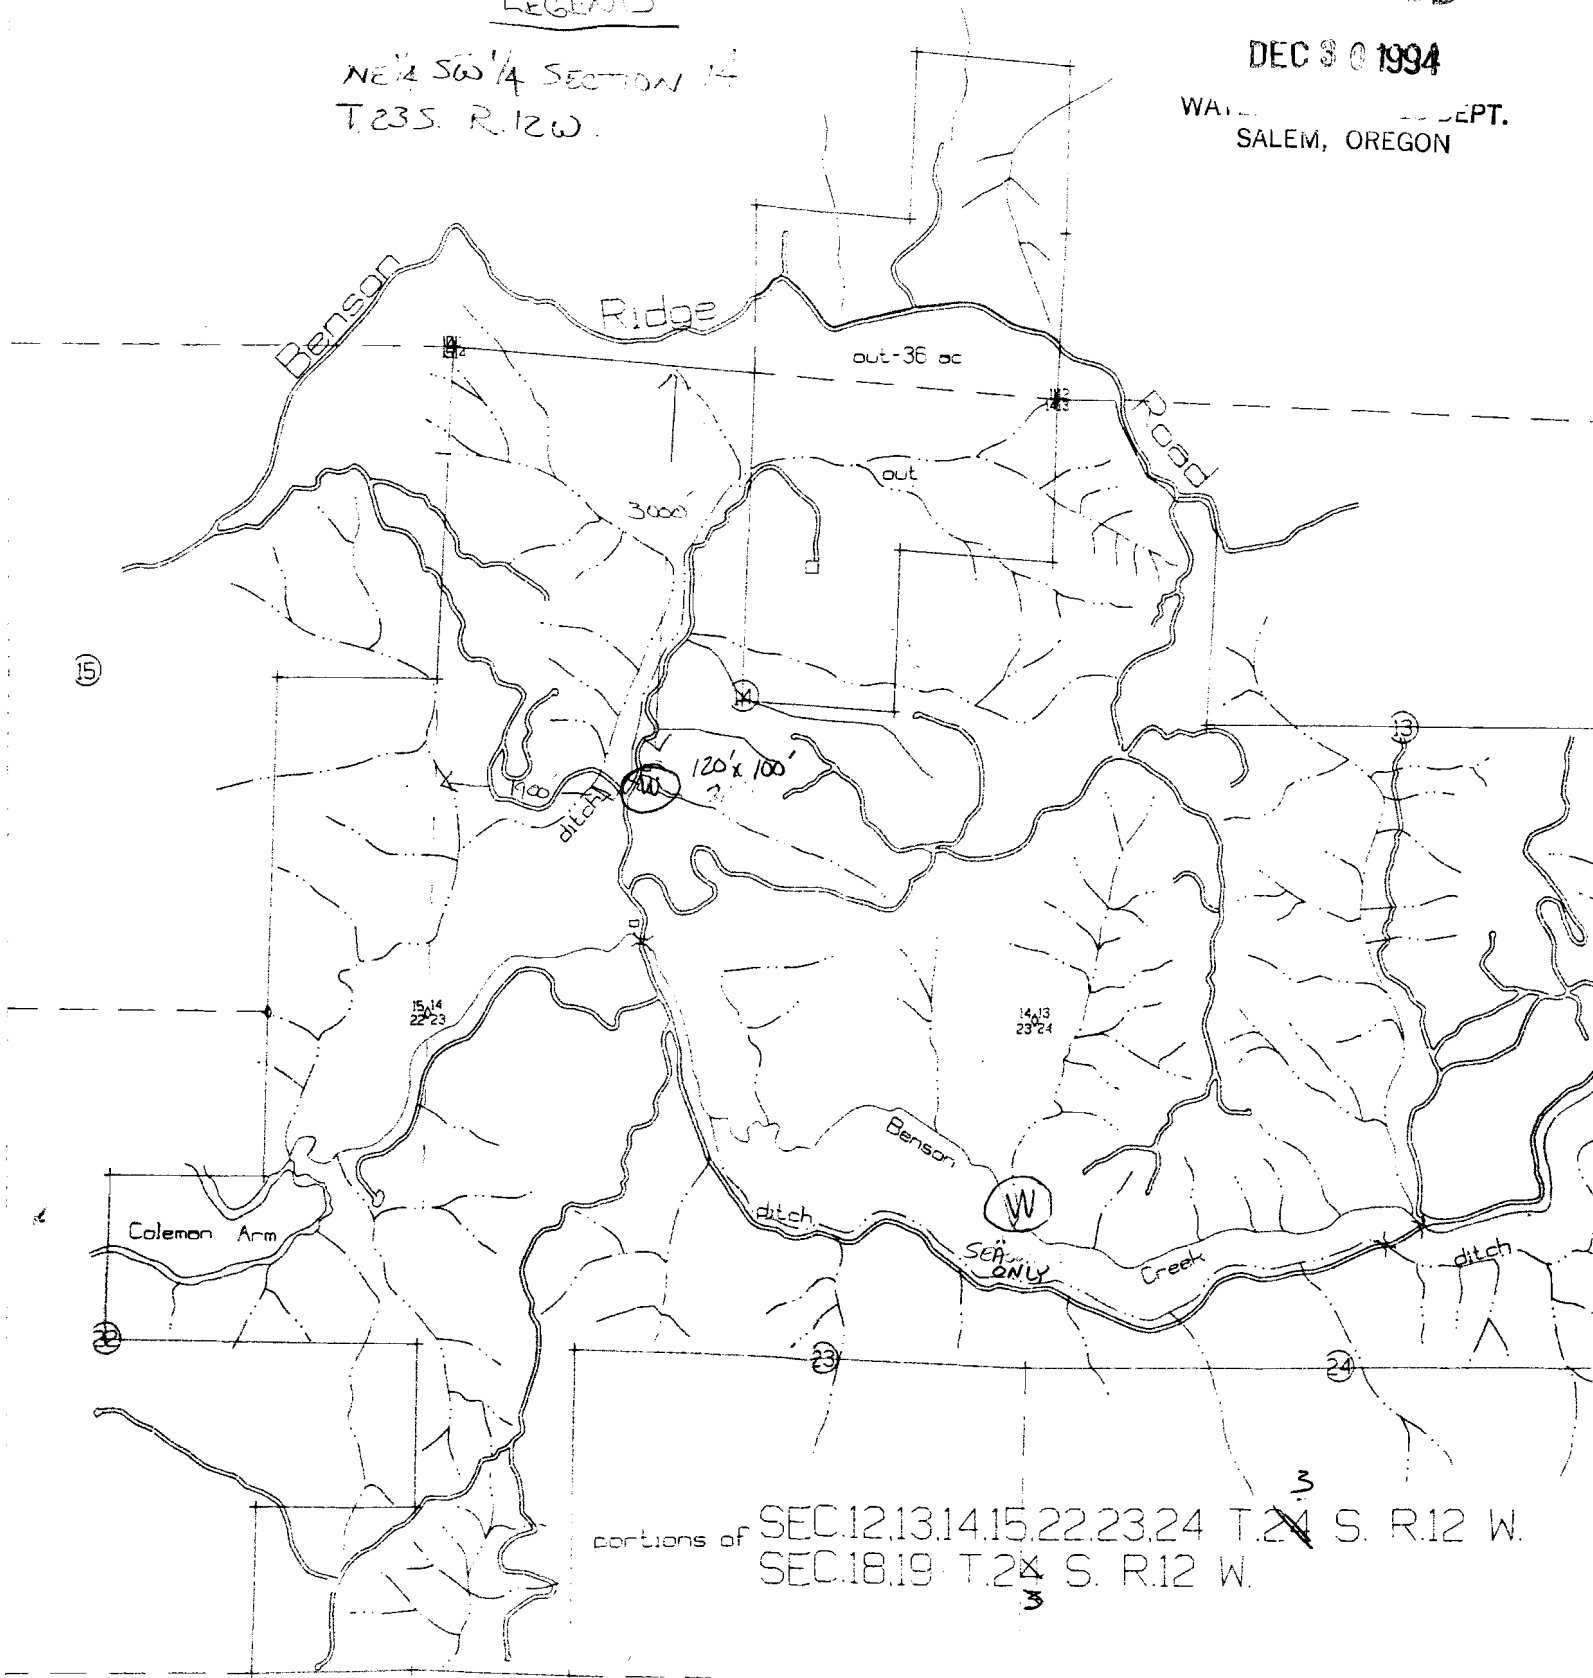

portions of SEC.12,13,14,15,22,23,24 T.23 S. R.12 W.
SEC.18,19 T.24 S. R.12 W.

No Final Proof Map available

No Permit Map available