


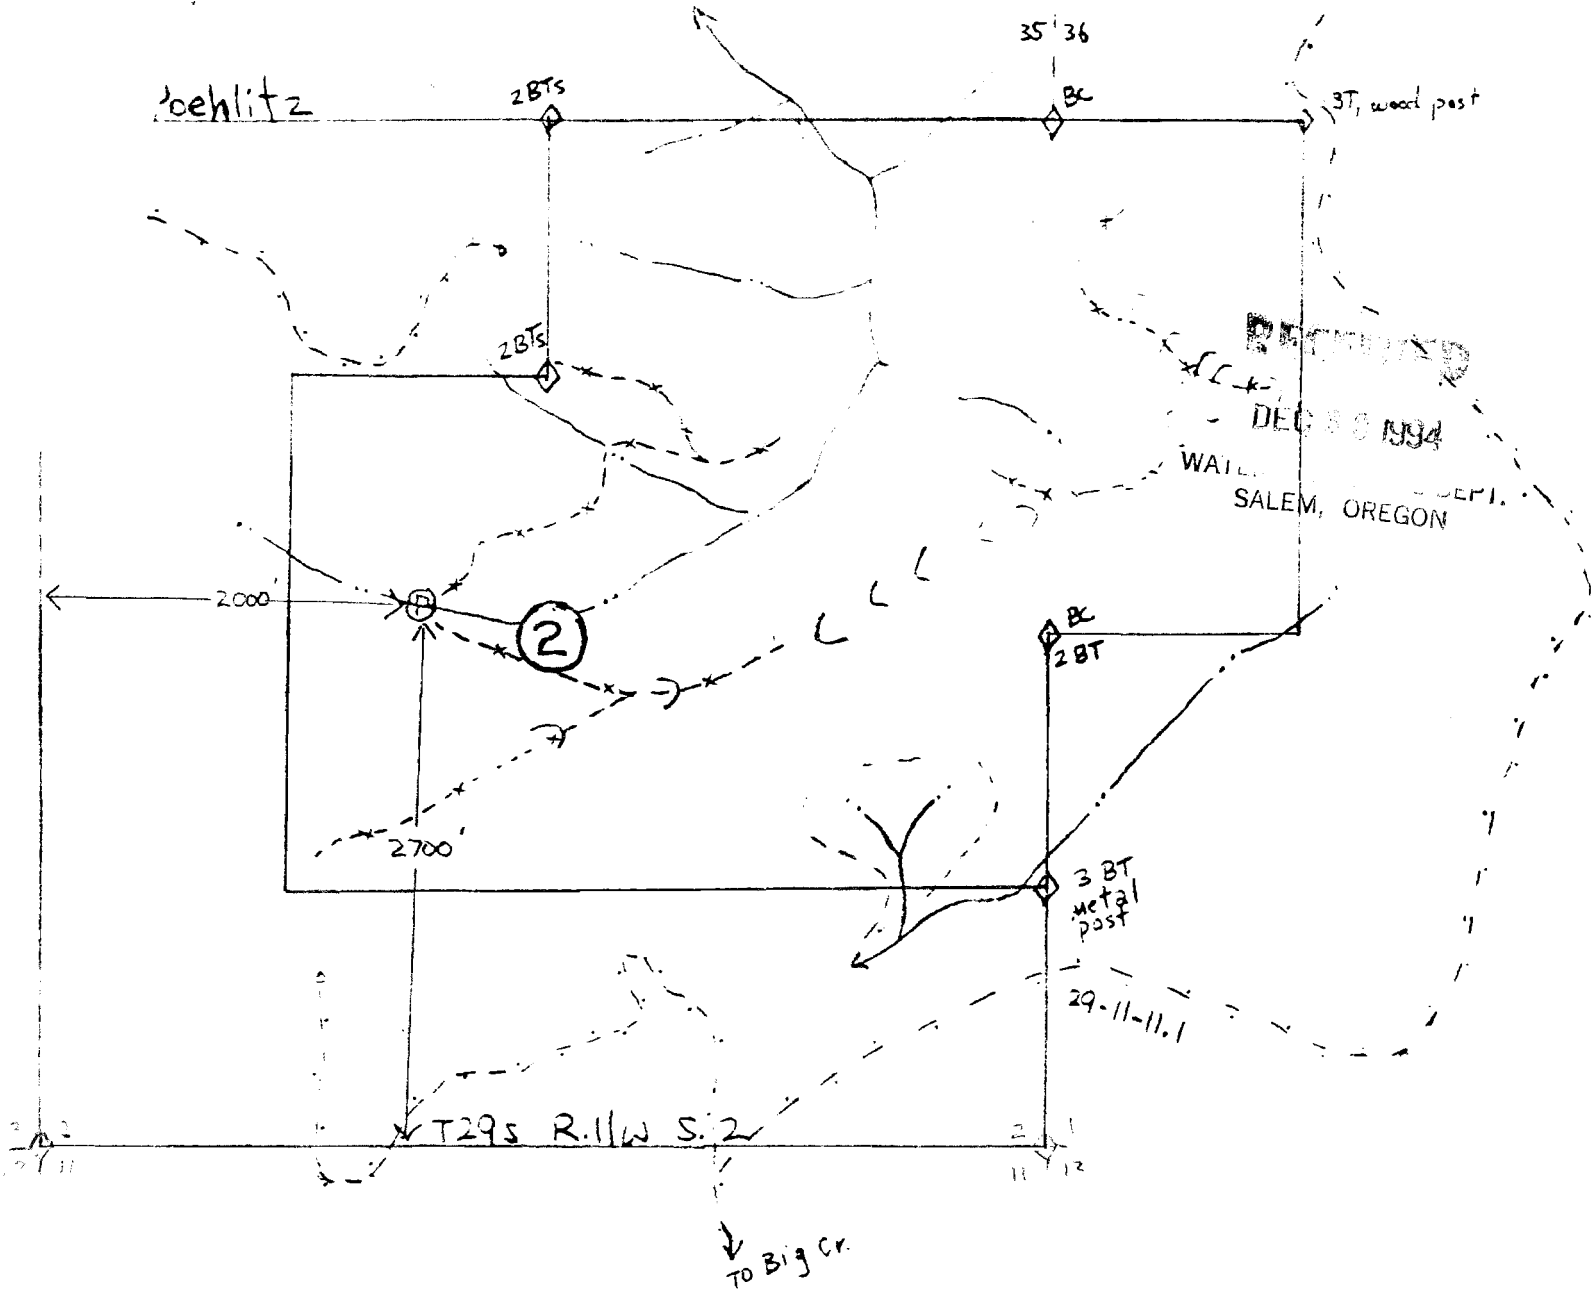

LEGEND

"CONFIDENTIAL" 70736

SE 1/4 NW 1/4 SECTION 2 T.29 S. R. 11 W.

⊙ = POND LOCATION

Application No R-74817
Permit No.

No Final Proof Map available

No Permit Map available