


SEC. 10 T 23 S - R 6 W

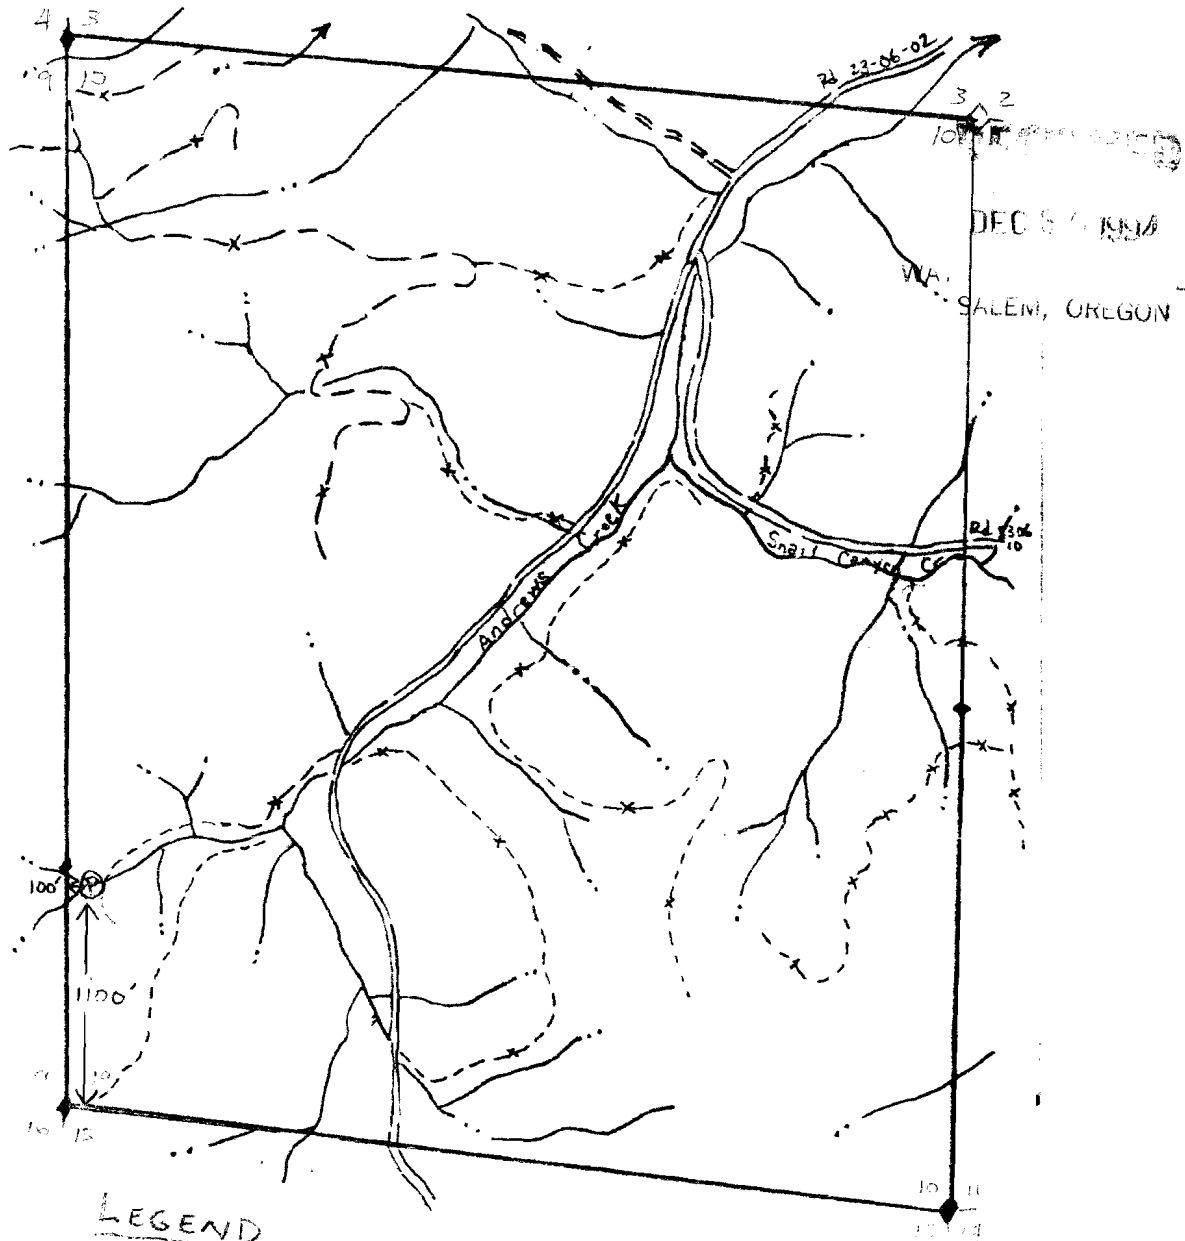

Application No. R-76821
Permit No.

No Final Proof Map available

No Permit Map available