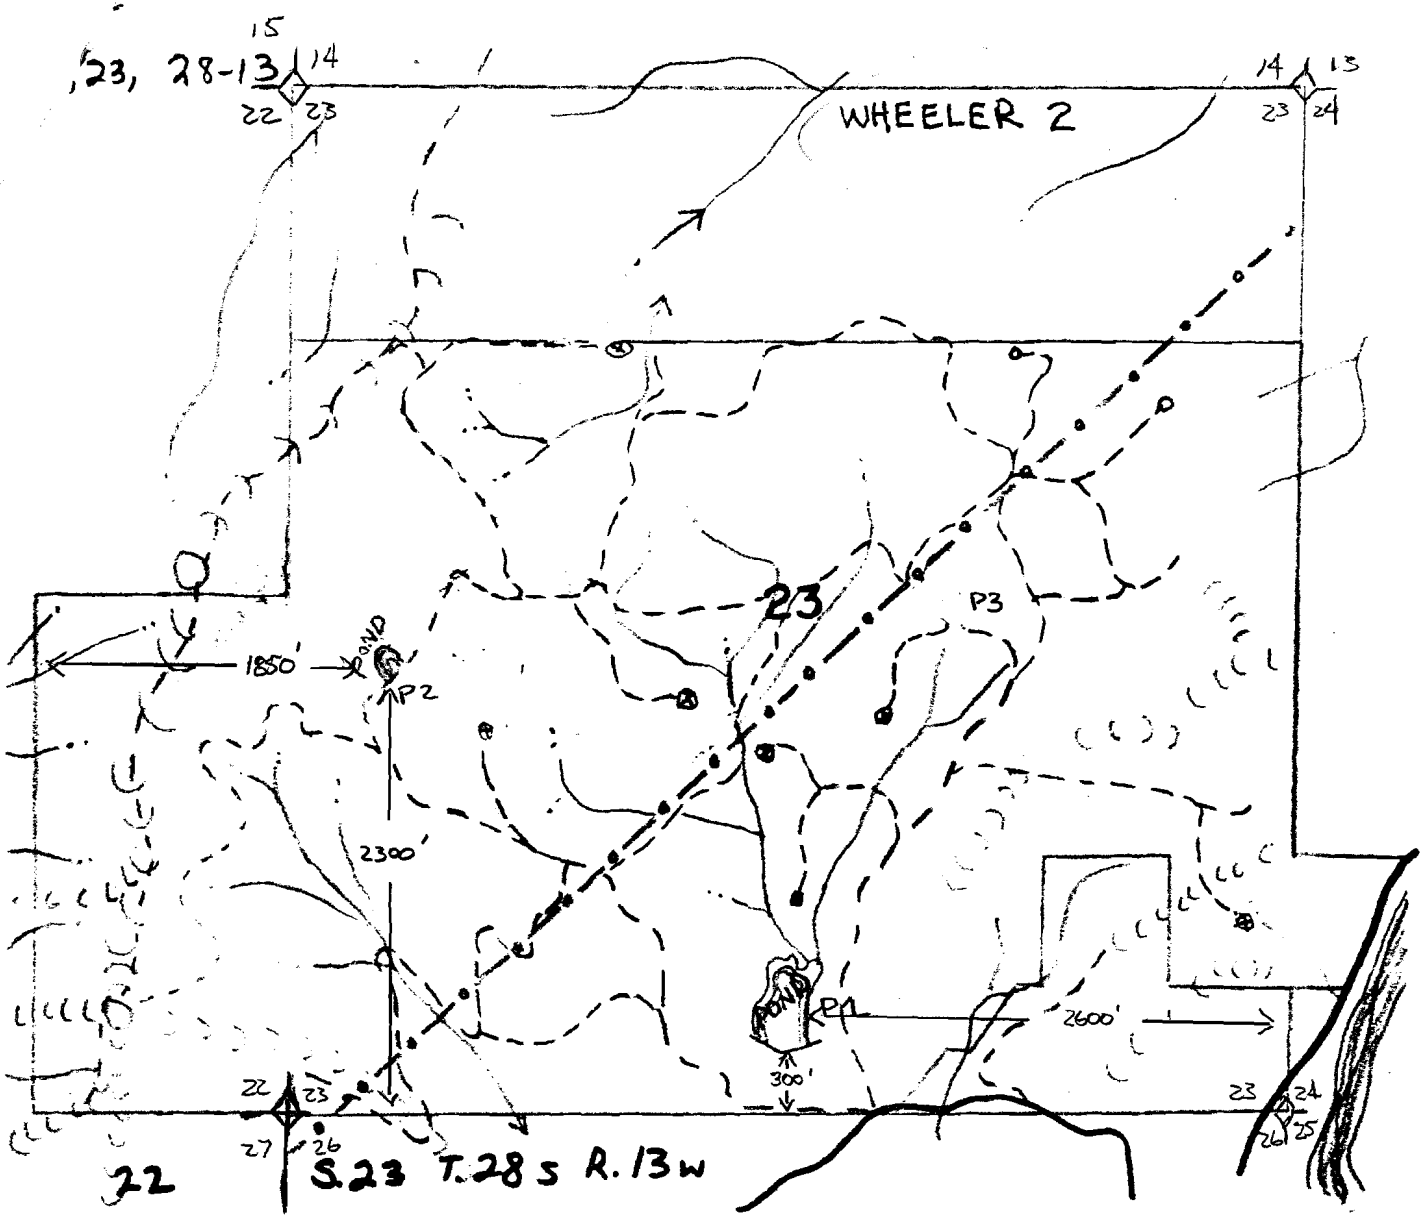

LEGEND

P 1 SW 1/4 SE 1/4 SECTION 23 T. 28 S. R.13 W

P 2 NE 1/4 SW 1/4 SECTION 23 T. 28 S. R.13 W.

RECEIVED
DEC 30 1994
WATER RESOURCES DEPT.
SALEM, OREGON

CERTIFICATE NO. 70742

Application No. R-76823
Permit No.

No Final Proof Map available

No Permit Map available