


Kastor # 2
E

Kastor # 5

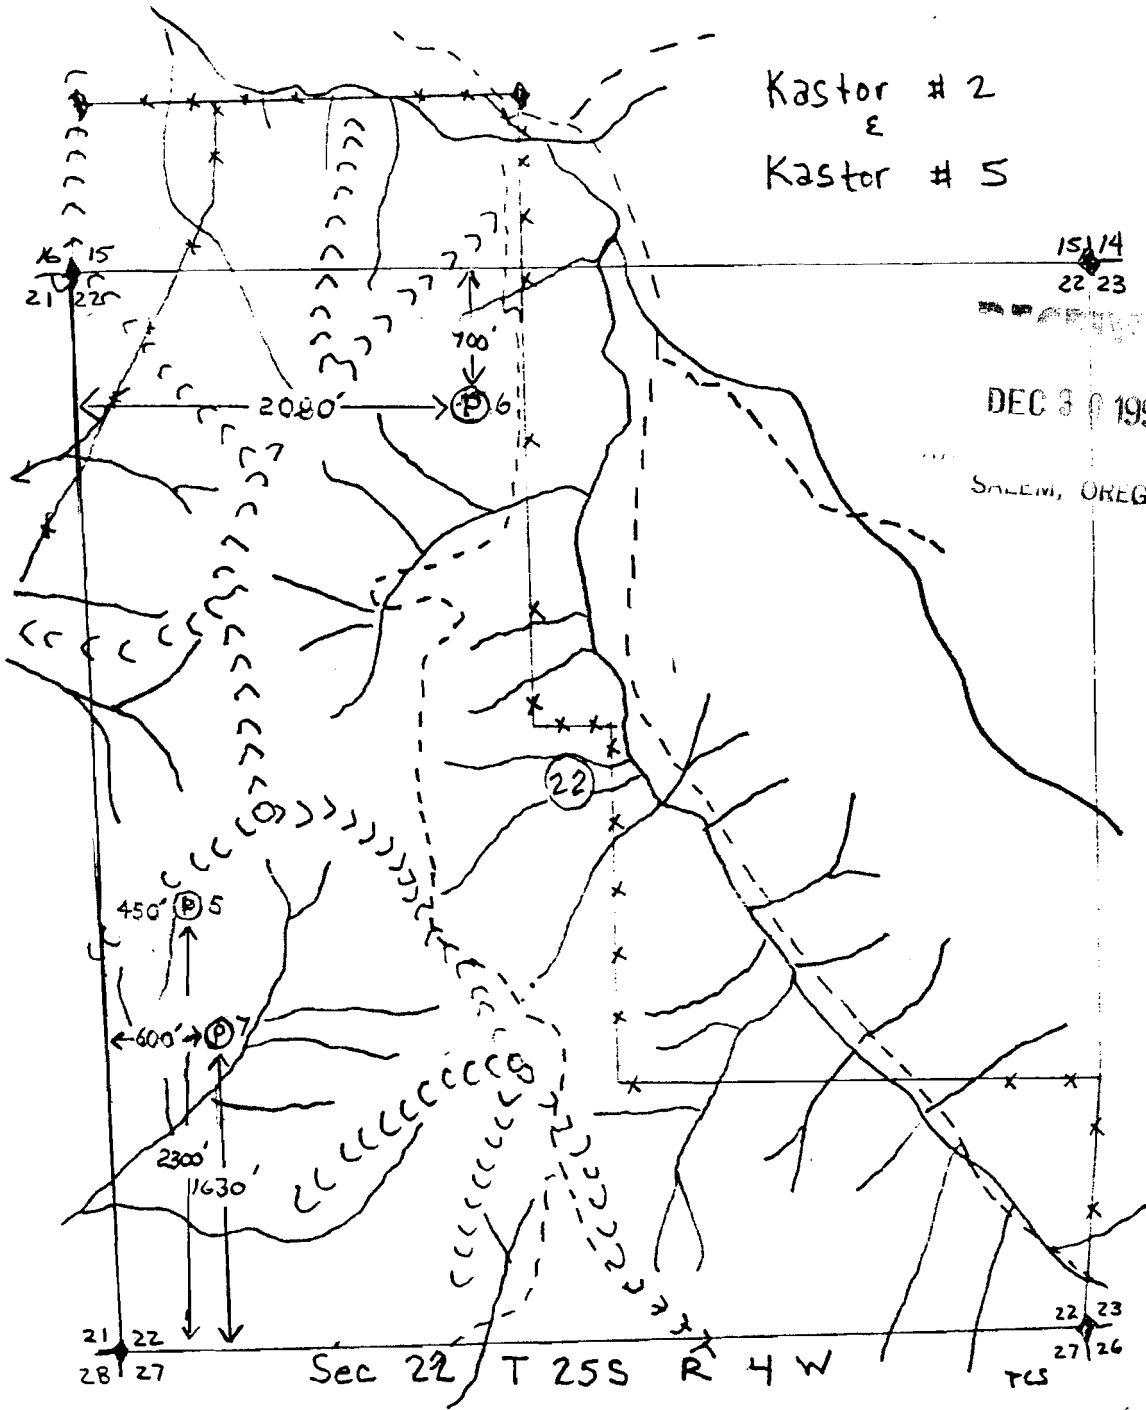

Application No. R-76826
Permit No.

LEGEND

- Ⓟ 5 NW 1/4 SW 1/4 SECTION 22 T.25S. R.4W.
- Ⓟ 6 NE 1/4 NW 1/4 SECTION 22 T.25S. R.4W.
- Ⓟ 7 NE 1/4 NE 1/4 SECTION 22 T.25S. R.4W.

"CERTIFICATE NO. 70745"

No Final Proof Map available

No Permit Map available