

Kastor # 2

E


Kastor # 5

15/14
22 23

RECEIVED

DEC 30 1994

WATER RESOURCES DEPT.
SALEM, OREGON

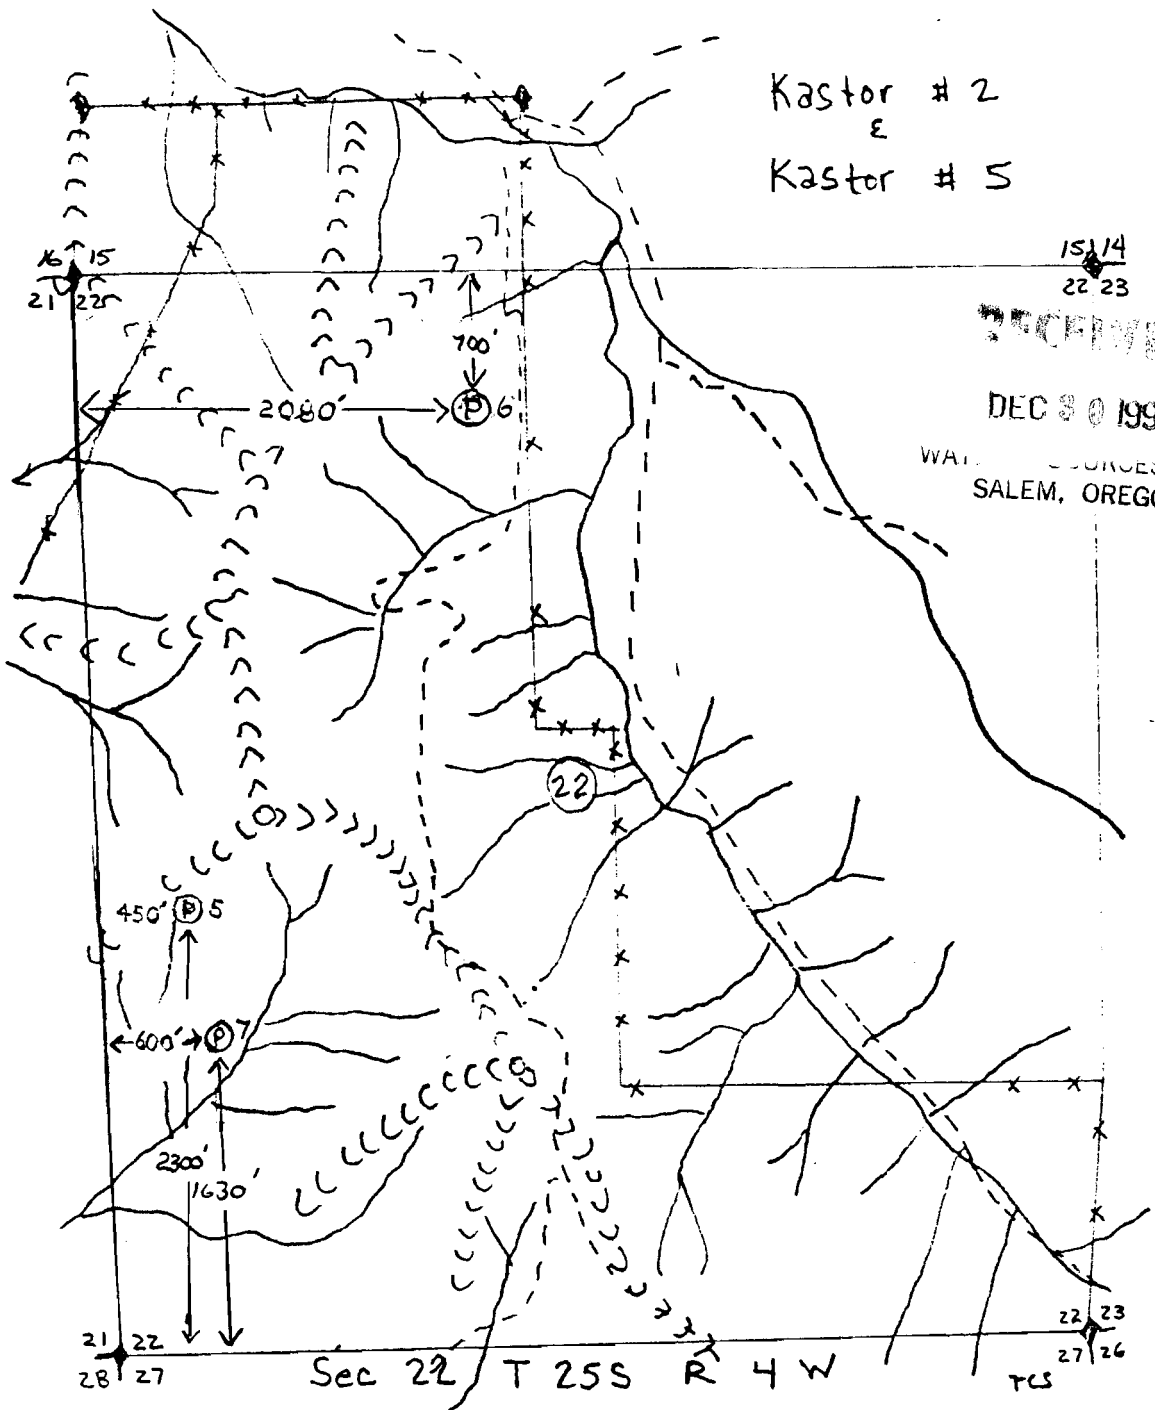

Application No. R-76827
Permit No.

LEGEND

Ⓟ 5 NW 1/4 SW 1/4 SECTION 22 T.25S. R.4W.

Ⓟ 6 NE 1/4 NW 1/4 SECTION 22 T.25S. R.4W.

Ⓟ 7 NE 1/4 NE 1/4 SECTION 22 T.25S. R.4W.

CERTIFICATE NO. 70746

No Final Proof Map available

No Permit Map available