


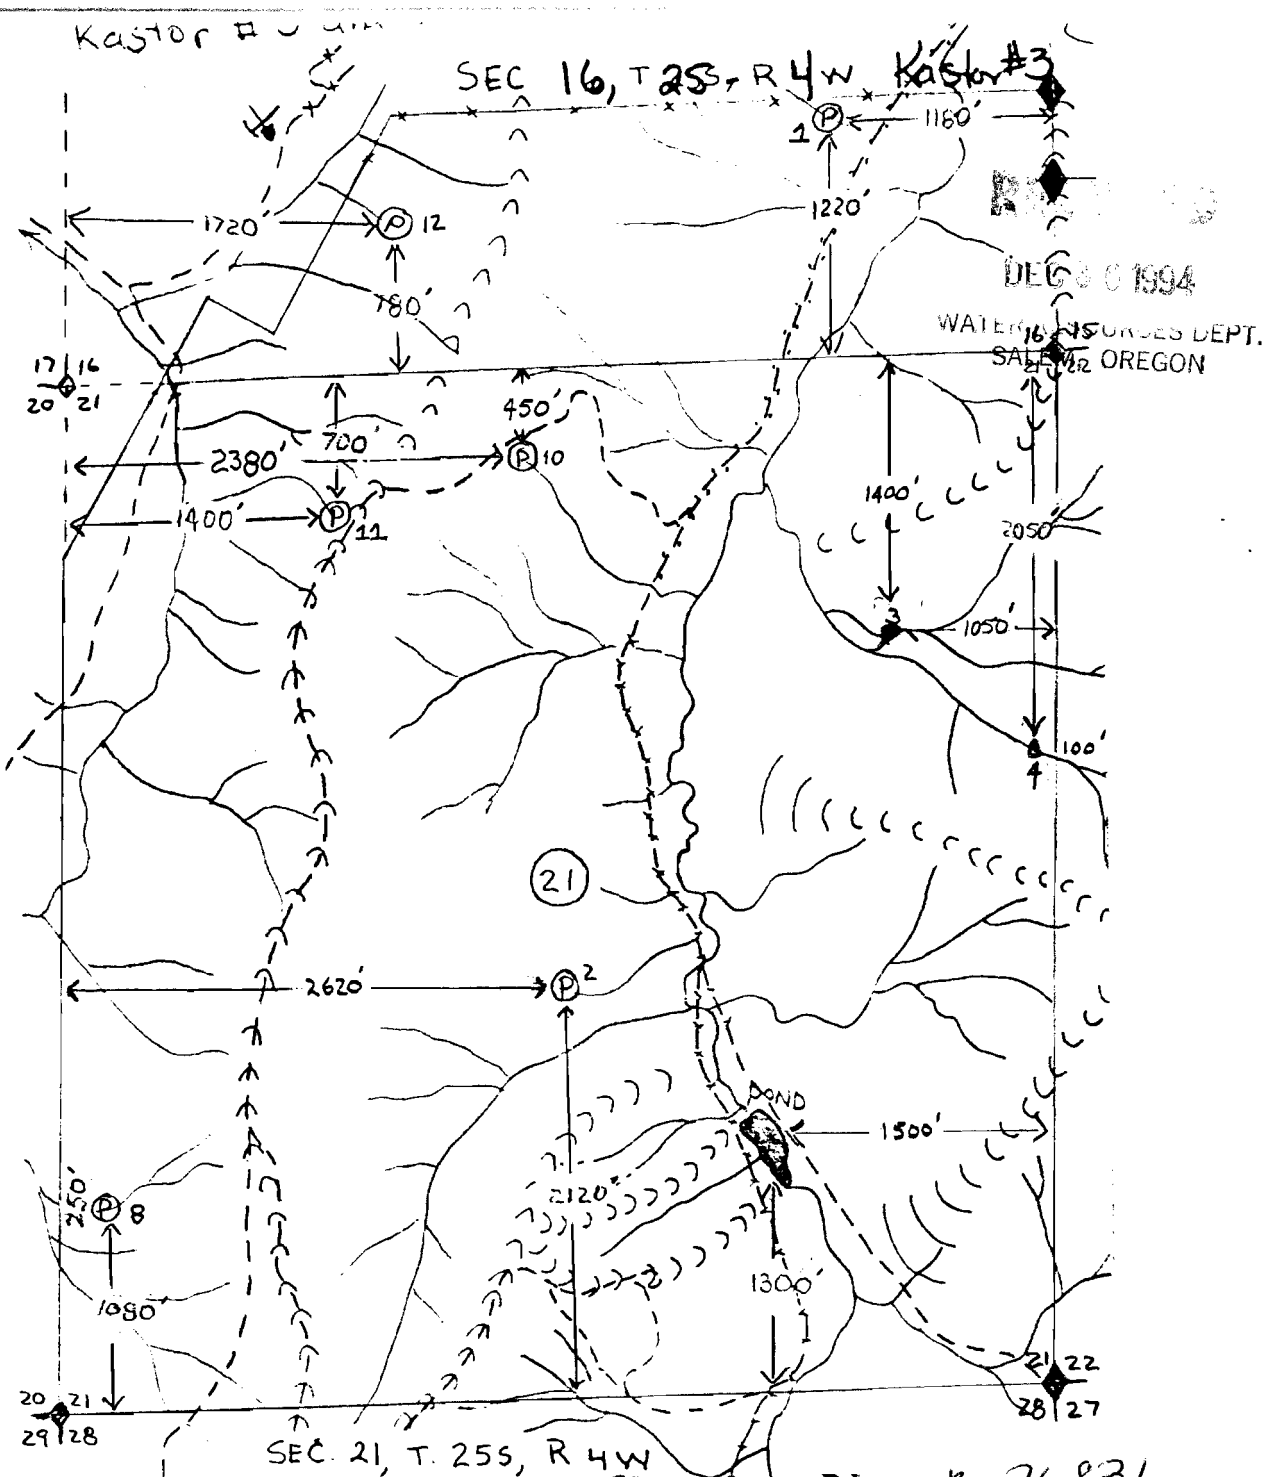

# LEGEND

- ⊙ 1 SE 1/4 SE 1/4 SECTION 16 T.25S. R.4W.
- ⊙ 2 NE 1/4 SW 1/4 SECTION 21 T.25S. R.4W.
- ⊙ 3 SE 1/4 NE 1/4 SECTION 21 T.25S. R.4W.
- ⊙ 4 SE 1/4 NE 1/4 SECTION 21 T.25S. R.4W.
- ⊙ 8 SW 1/4 SW 1/4 SECTION 21 T.25S. R.4W.
- ⊙ 10 NE 1/4 NW 1/4 SECTION 21 T.25S. R.4W.
- ⊙ 11 NE 1/4 NW 1/4 SECTION 21 T.25S. R.4W.
- ⊙ 12 SE 1/4 SW 1/4 SECTION 16 T.25S. R.4W.
- POND SW 1/4 SE 1/4 SECTION 21 T.25S. R.4W.

**Application No**  
**Permit No.**

R-76831

CERTIFICATE NO.

70750

No Final Proof Map available

No Permit Map available