


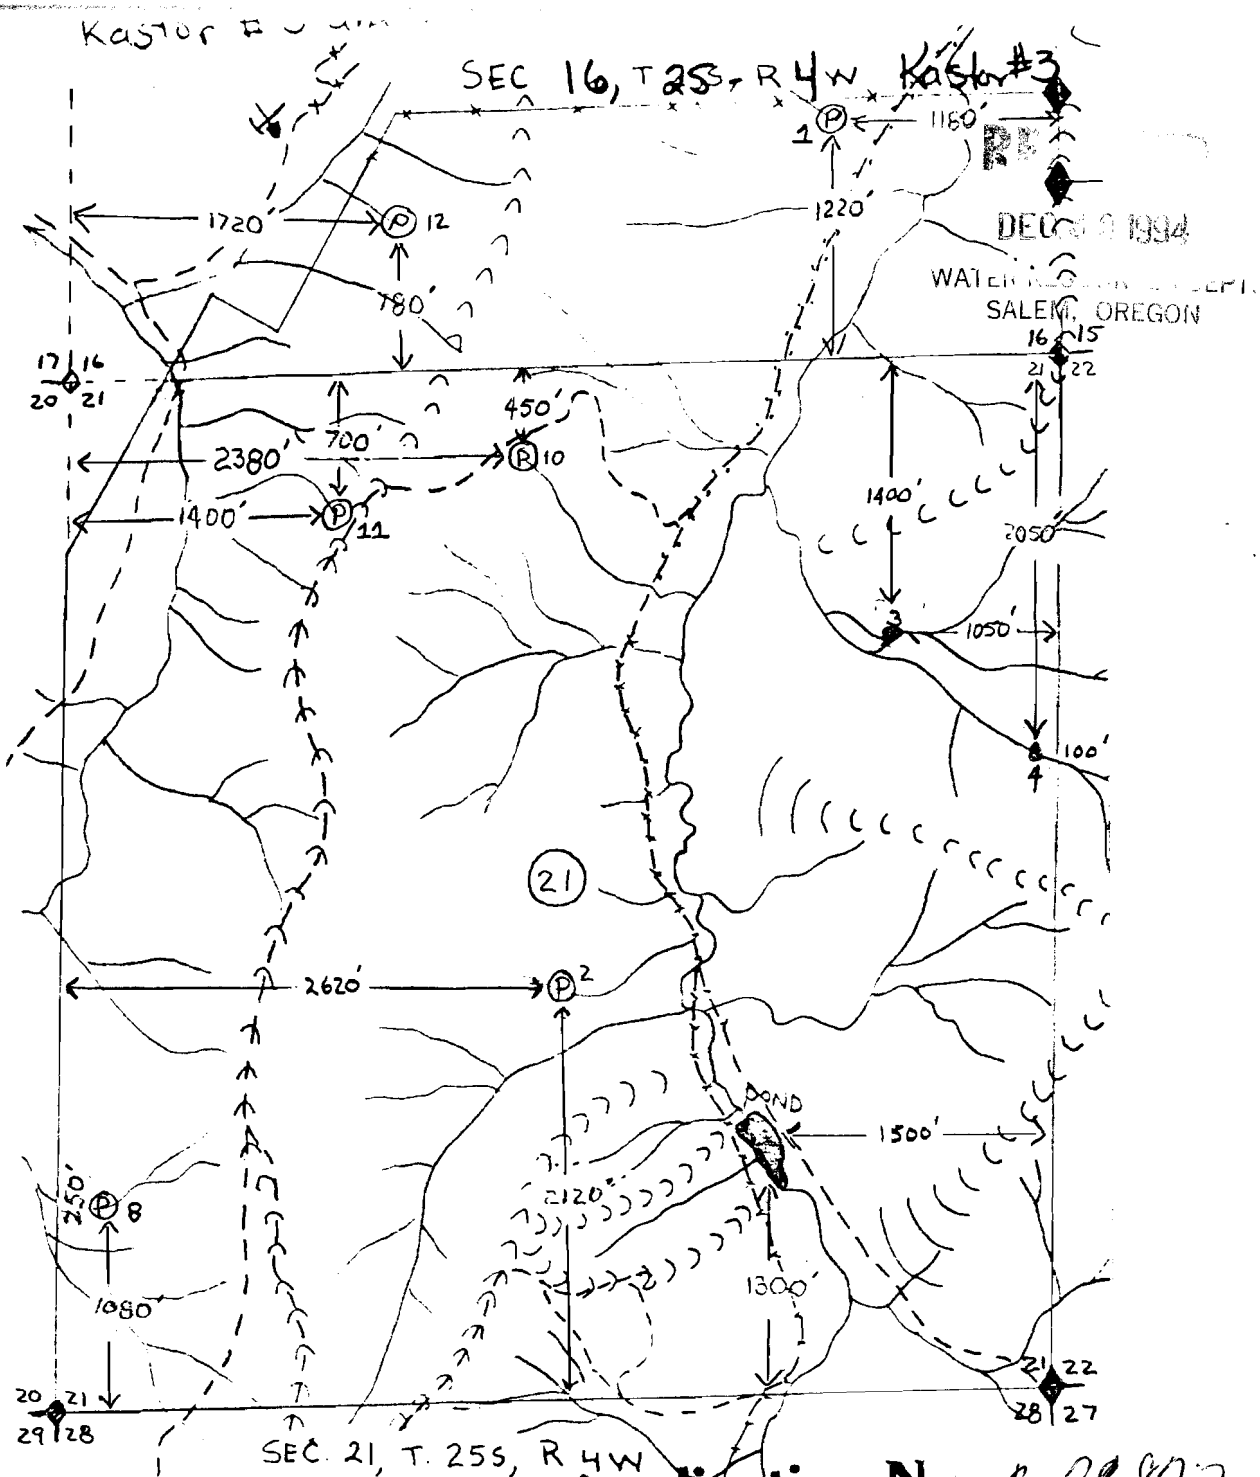

Application No. R-76832

Permit No.

LEGEND

- Ⓟ 1 SE 1/4 SE 1/4 SECTION 16 T.25S. R.4W.
- Ⓟ 2 NE 1/4 SW 1/4 SECTION 21 T.25S. R.4W.
- Ⓟ 3 SE 1/4 NE 1/4 SECTION 21 T.25S. R.4W.
- Ⓟ 4 SE 1/4 NE 1/4 SECTION 21 T.25S. R.4W.
- Ⓟ 8 SW 1/4 SW 1/4 SECTION 21 T.25S. R.4W.
- Ⓟ 10 NE 1/4 NW 1/4 SECTION 21 T.25S. R.4W.
- Ⓟ 11 NE 1/4 NW 1/4 SECTION 21 T.25S. R.4W.
- Ⓟ 12 SE 1/4 SW 1/4 SECTION 16 T.25S. R.4W.
- POND SW 1/4 SE 1/4 SECTION 21 T.25S. R.4W.

CERTIFICATE NO.

72751

No Final Proof Map available

No Permit Map available