

RECEIVED


Application No. 12-16833

Partial No.

DEC 30 1994

1:250,000

1:250,000

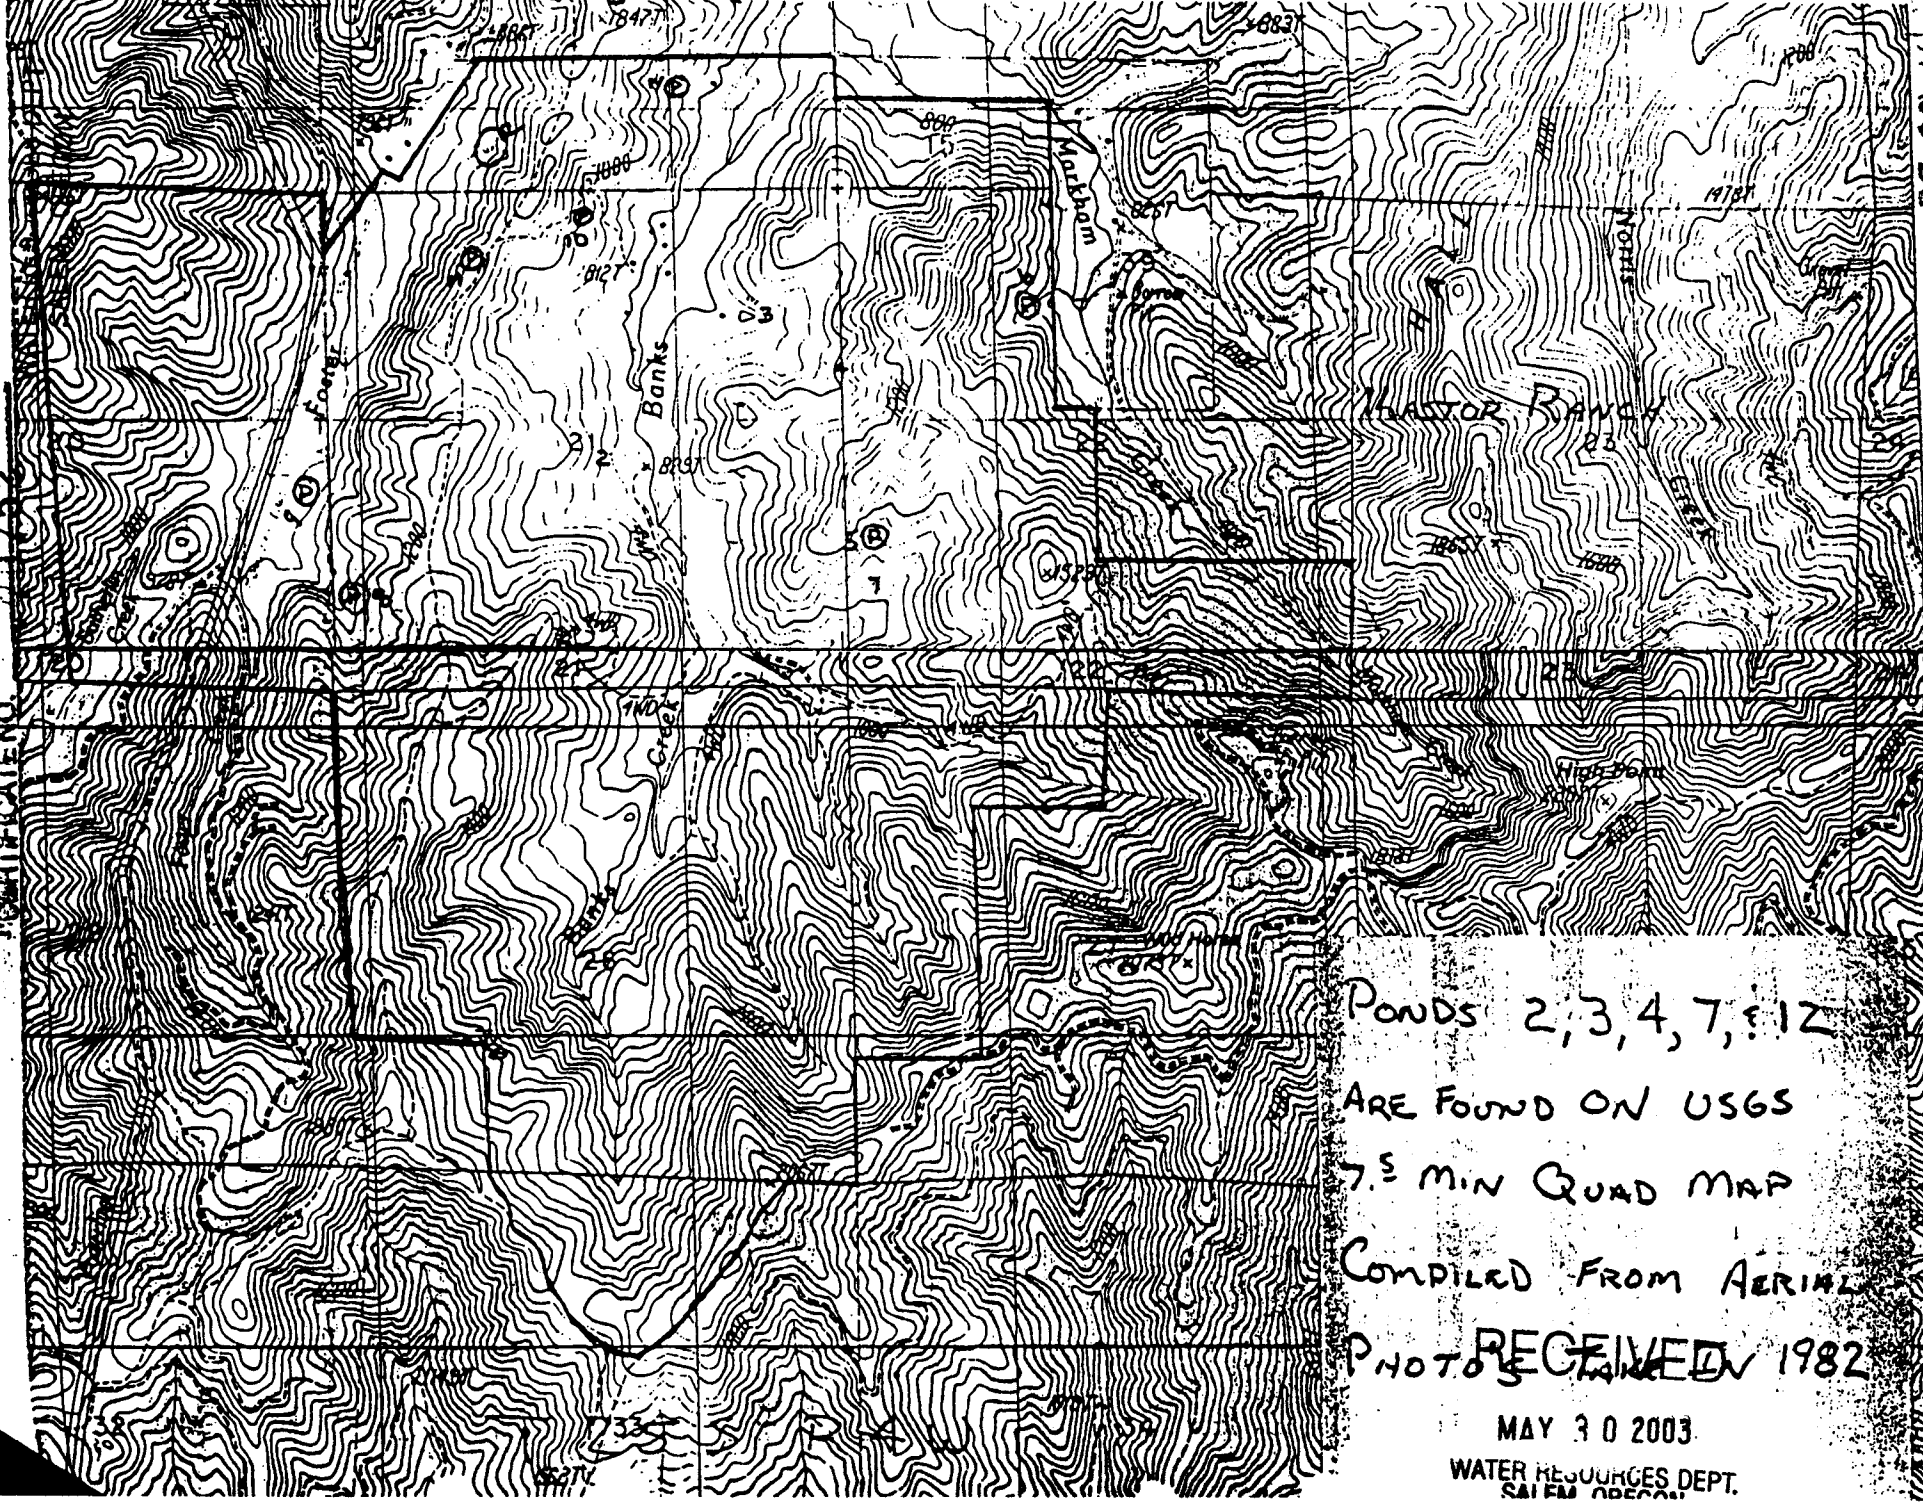

Ponds 2, 3, 4, 7, & 12

ARE FOUND ON USGS

7.5 MIN QUAD MAP

COMPILED FROM AERIAL

PHOTOGRAPH

RECEIVED 1982

MAY 30 2003  
WATER RESOURCES DEPT.  
