


Application No. K-70835
Permit No.

CERTIFICATE NO.

70754

SOURCES DEPT.
DALEM, OREGON

DEC 30 1994

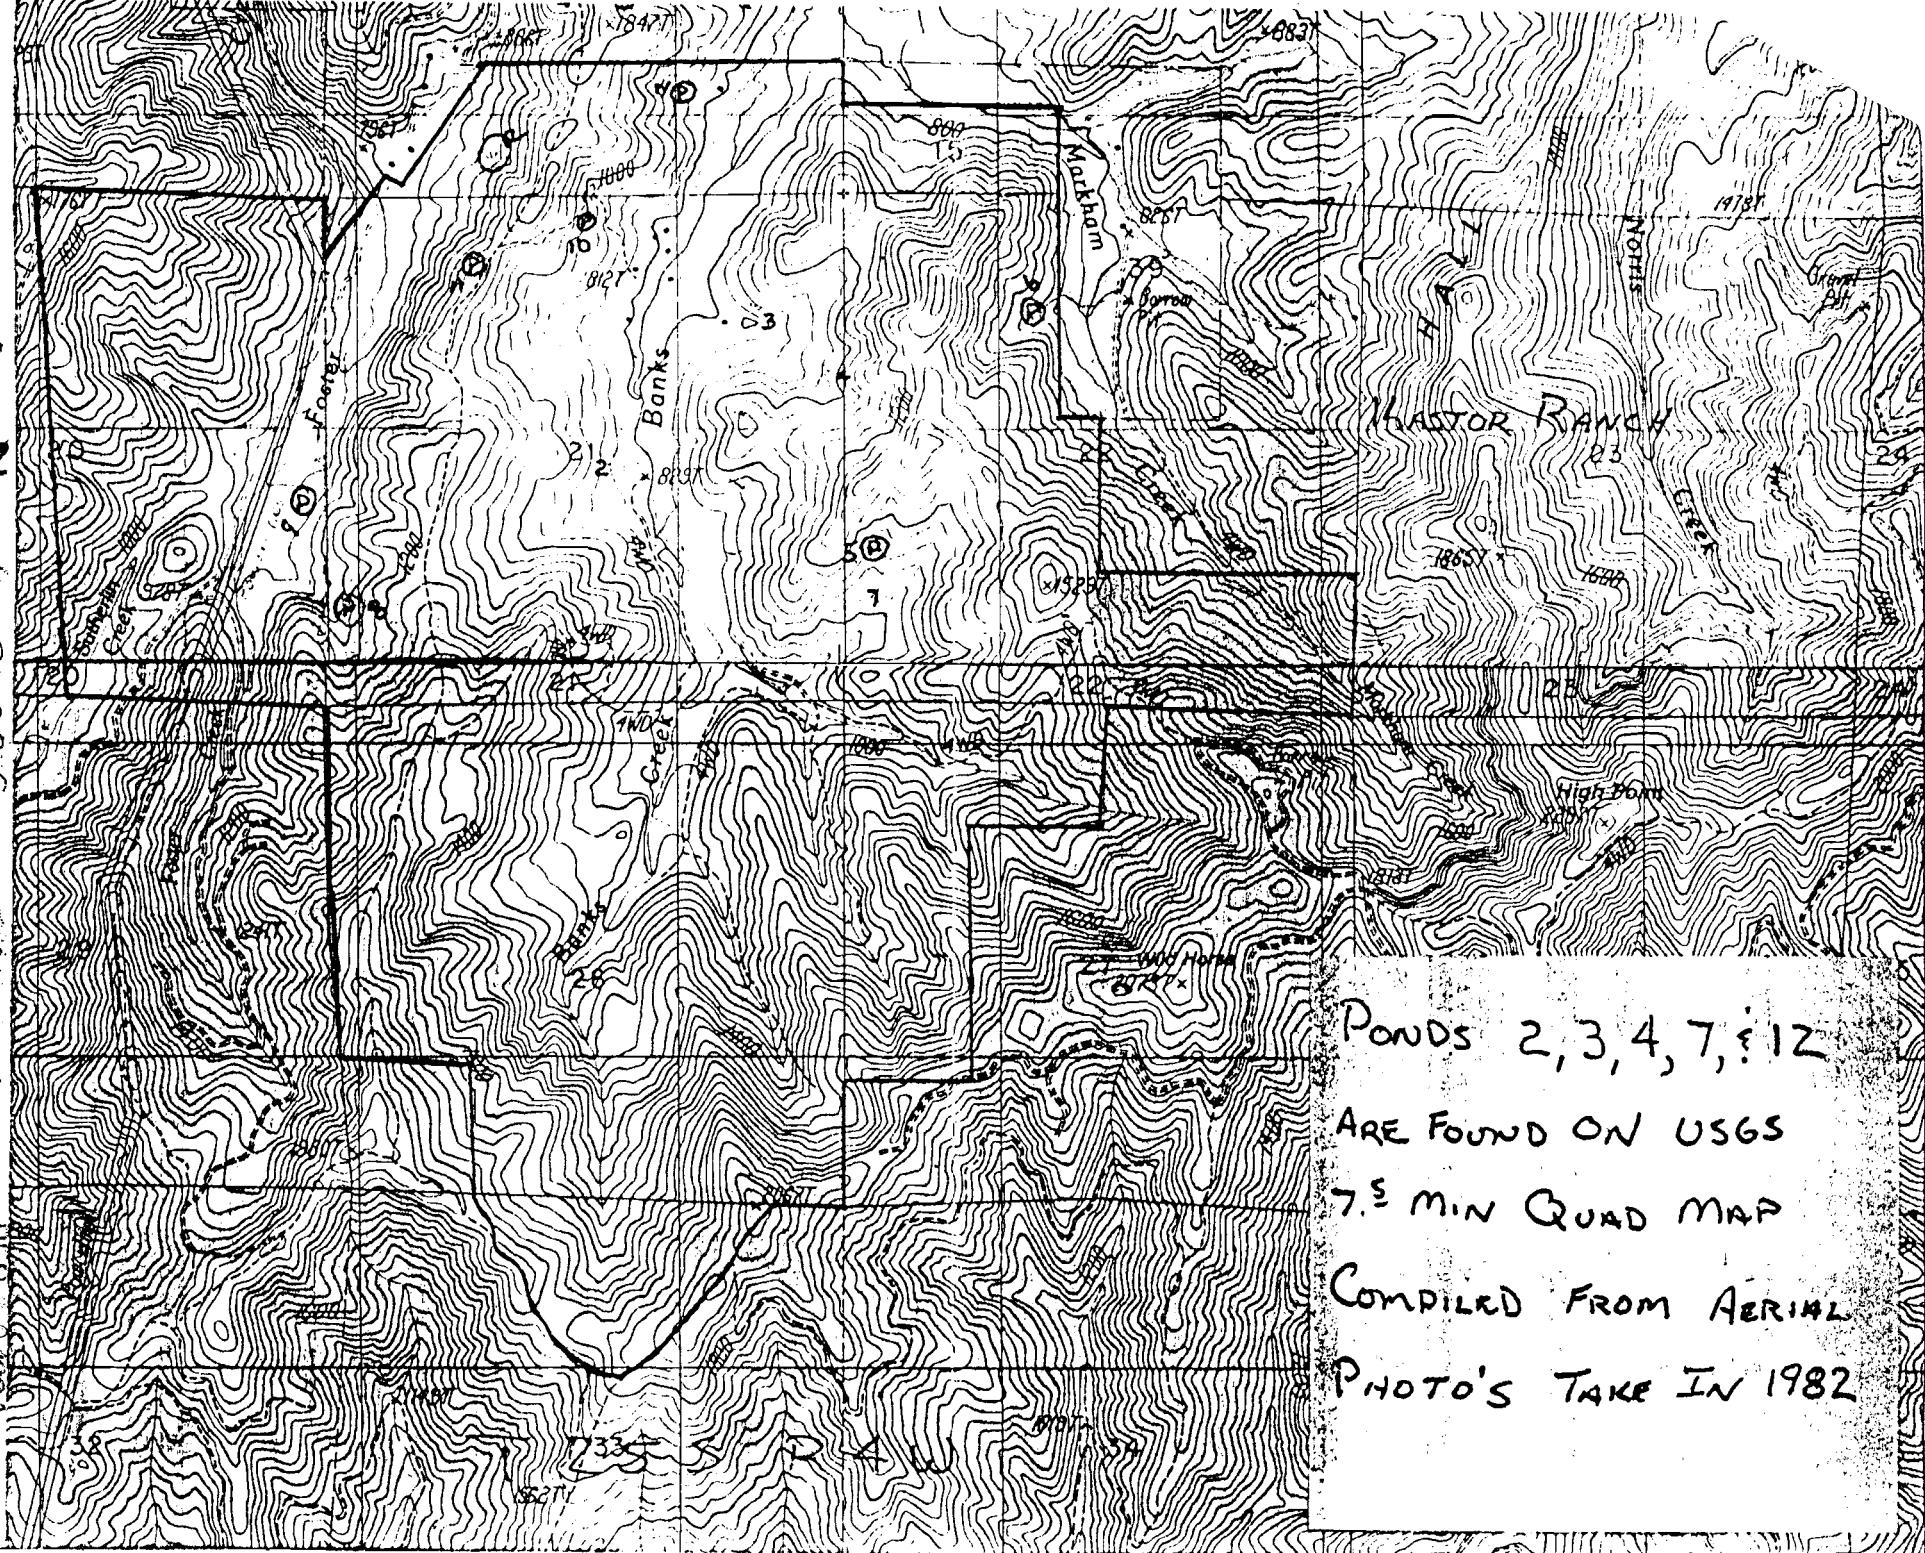

No Final Proof Map available

No Permit Map available