

2220536  
282 AC

RECEIVED


DEC 8 9 1994

RESOURCES DEPT.  
SALEM, OREGON

Dudley Walton  
673-4451

Bob Allen  
849-2221

Mike Allen  
849-2223

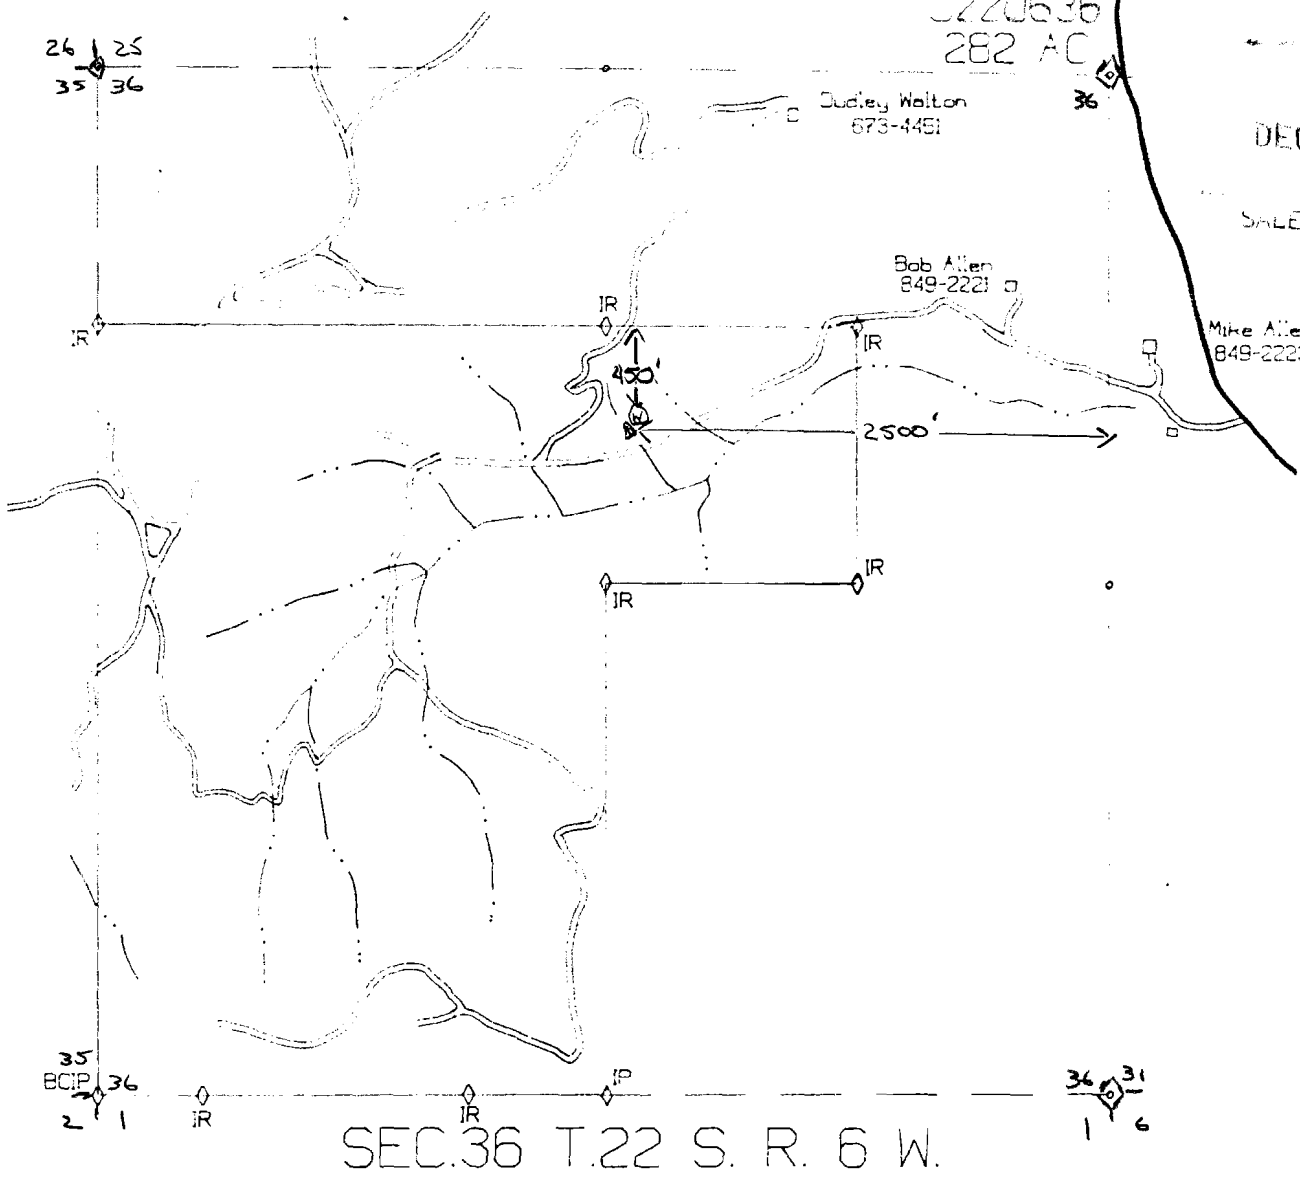

SEC. 36 T. 22 S. R. 6 W.

LEGEND

SW 1/4 NE 1/4 SECTION 36 T. 22 S. R. 6 W.

⊗ = POND LOCATION

**Application No. R-76838**  
**Permit No.**

DATE NO. 7075

No Final Proof Map available

No Permit Map available