

Application No. R-76839
Permit No.

RECEIVED


DEC 30 1994

WATER...
SALEM, OREGON

70758

COMMUNICATION NO.

UNITED STATES
DEPARTMENT OF THE INTERIOR
GEOLOGICAL SURVEY

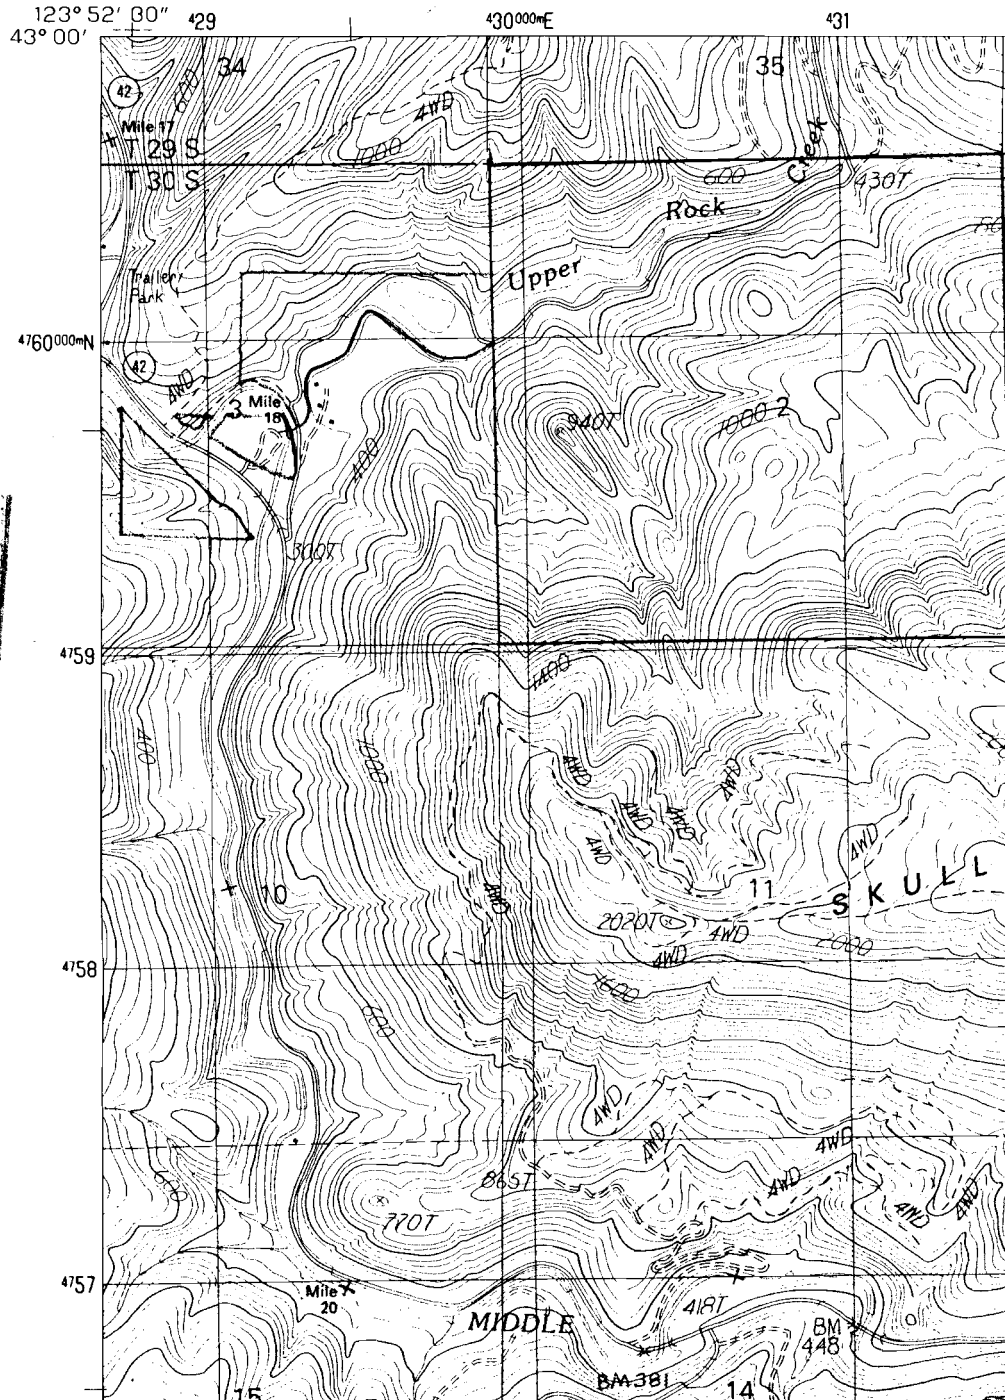

LEGEND

SE 1/4 NE 1/4 SECTION 3
T.30 S. R. 10 W.

THIS IS A COPY OF A
USGS QUAD MAP COMPILED
FROM AERIAL PHOTOGRAPHS TAKEN
IN 1984 THAT SHOWS POND
AND ITS LOCATION

No Final Proof Map available

No Permit Map available