


2, 23, 28-13, 14

WHEELER 2

DEC 8 1994

STATE OF OREGON

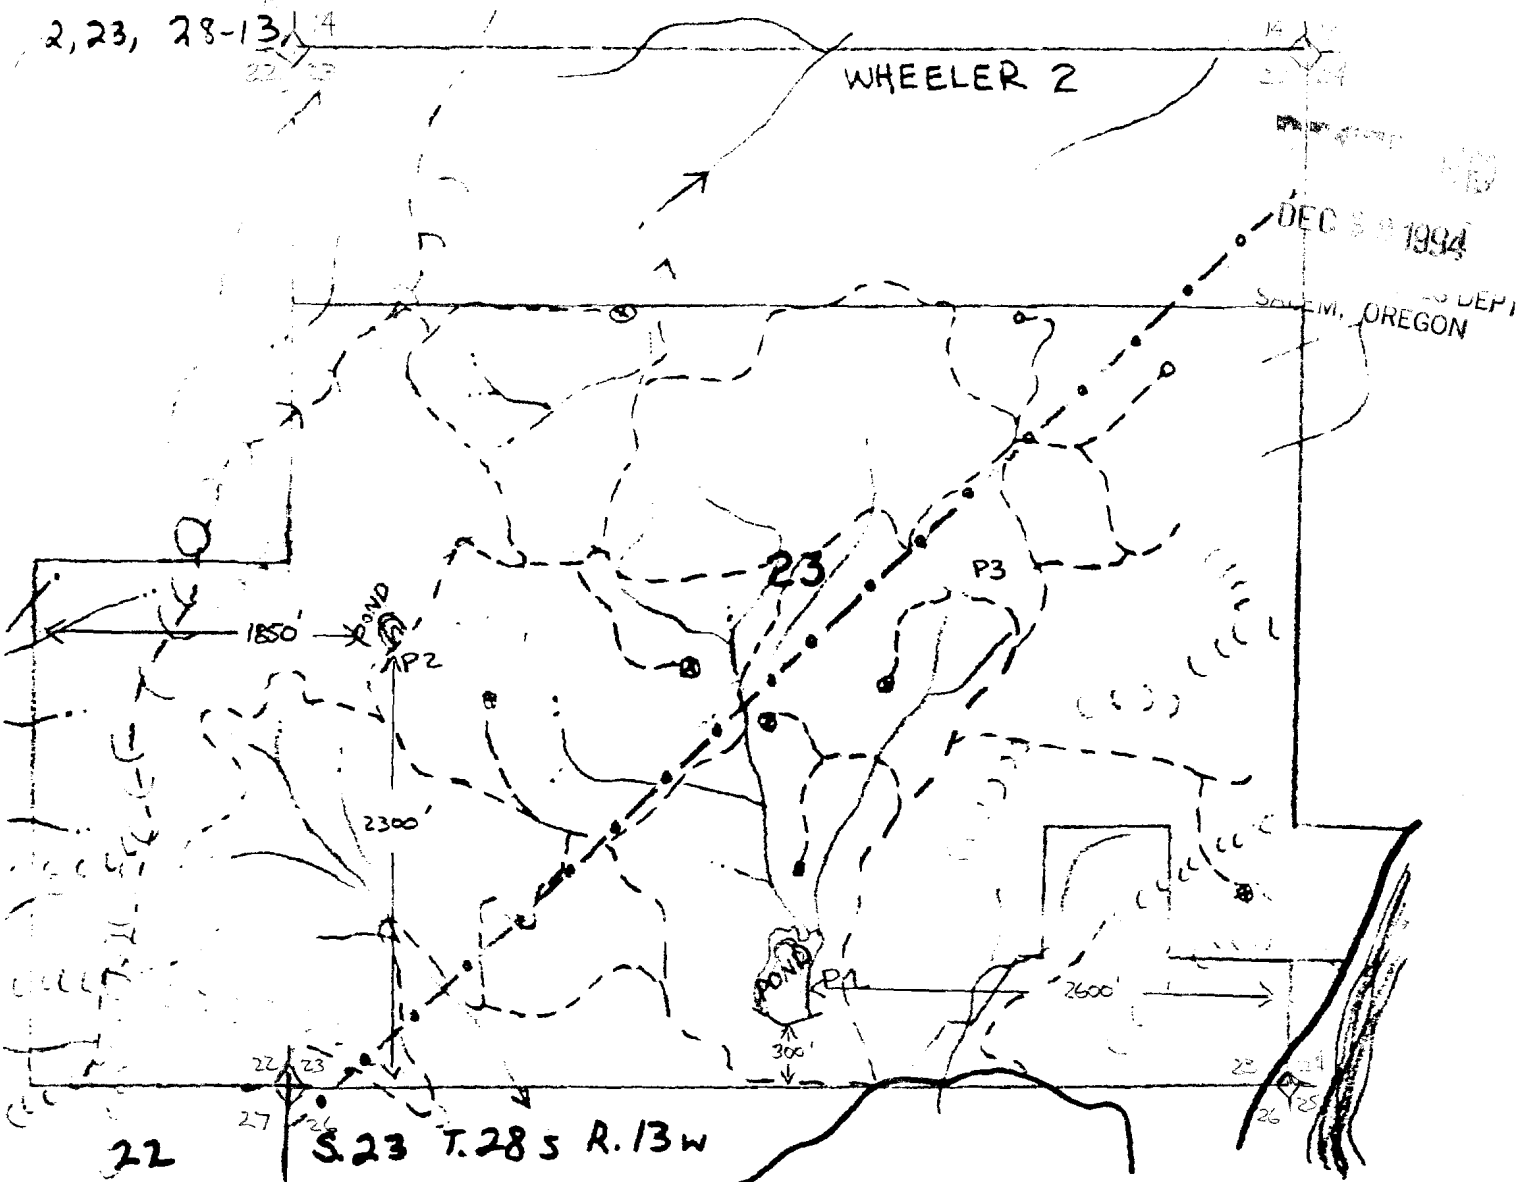

LEGEND

P1 SW 1/4 SE 1/4 SECTION 23 T 28 S. R.13W

P2 NE 1/4 SW 1/4 SECTION 23 T.28S. R.13W.

Application No

R-7684

73760

Permit No.

COMMUNICATE NO.

No Final Proof Map available

No Permit Map available