


Application No. 8-76872
Permit No.

CONTINGENCY

70761

DEC 1982

WATER RESOURCES DEPT.
SALEM, OREGON

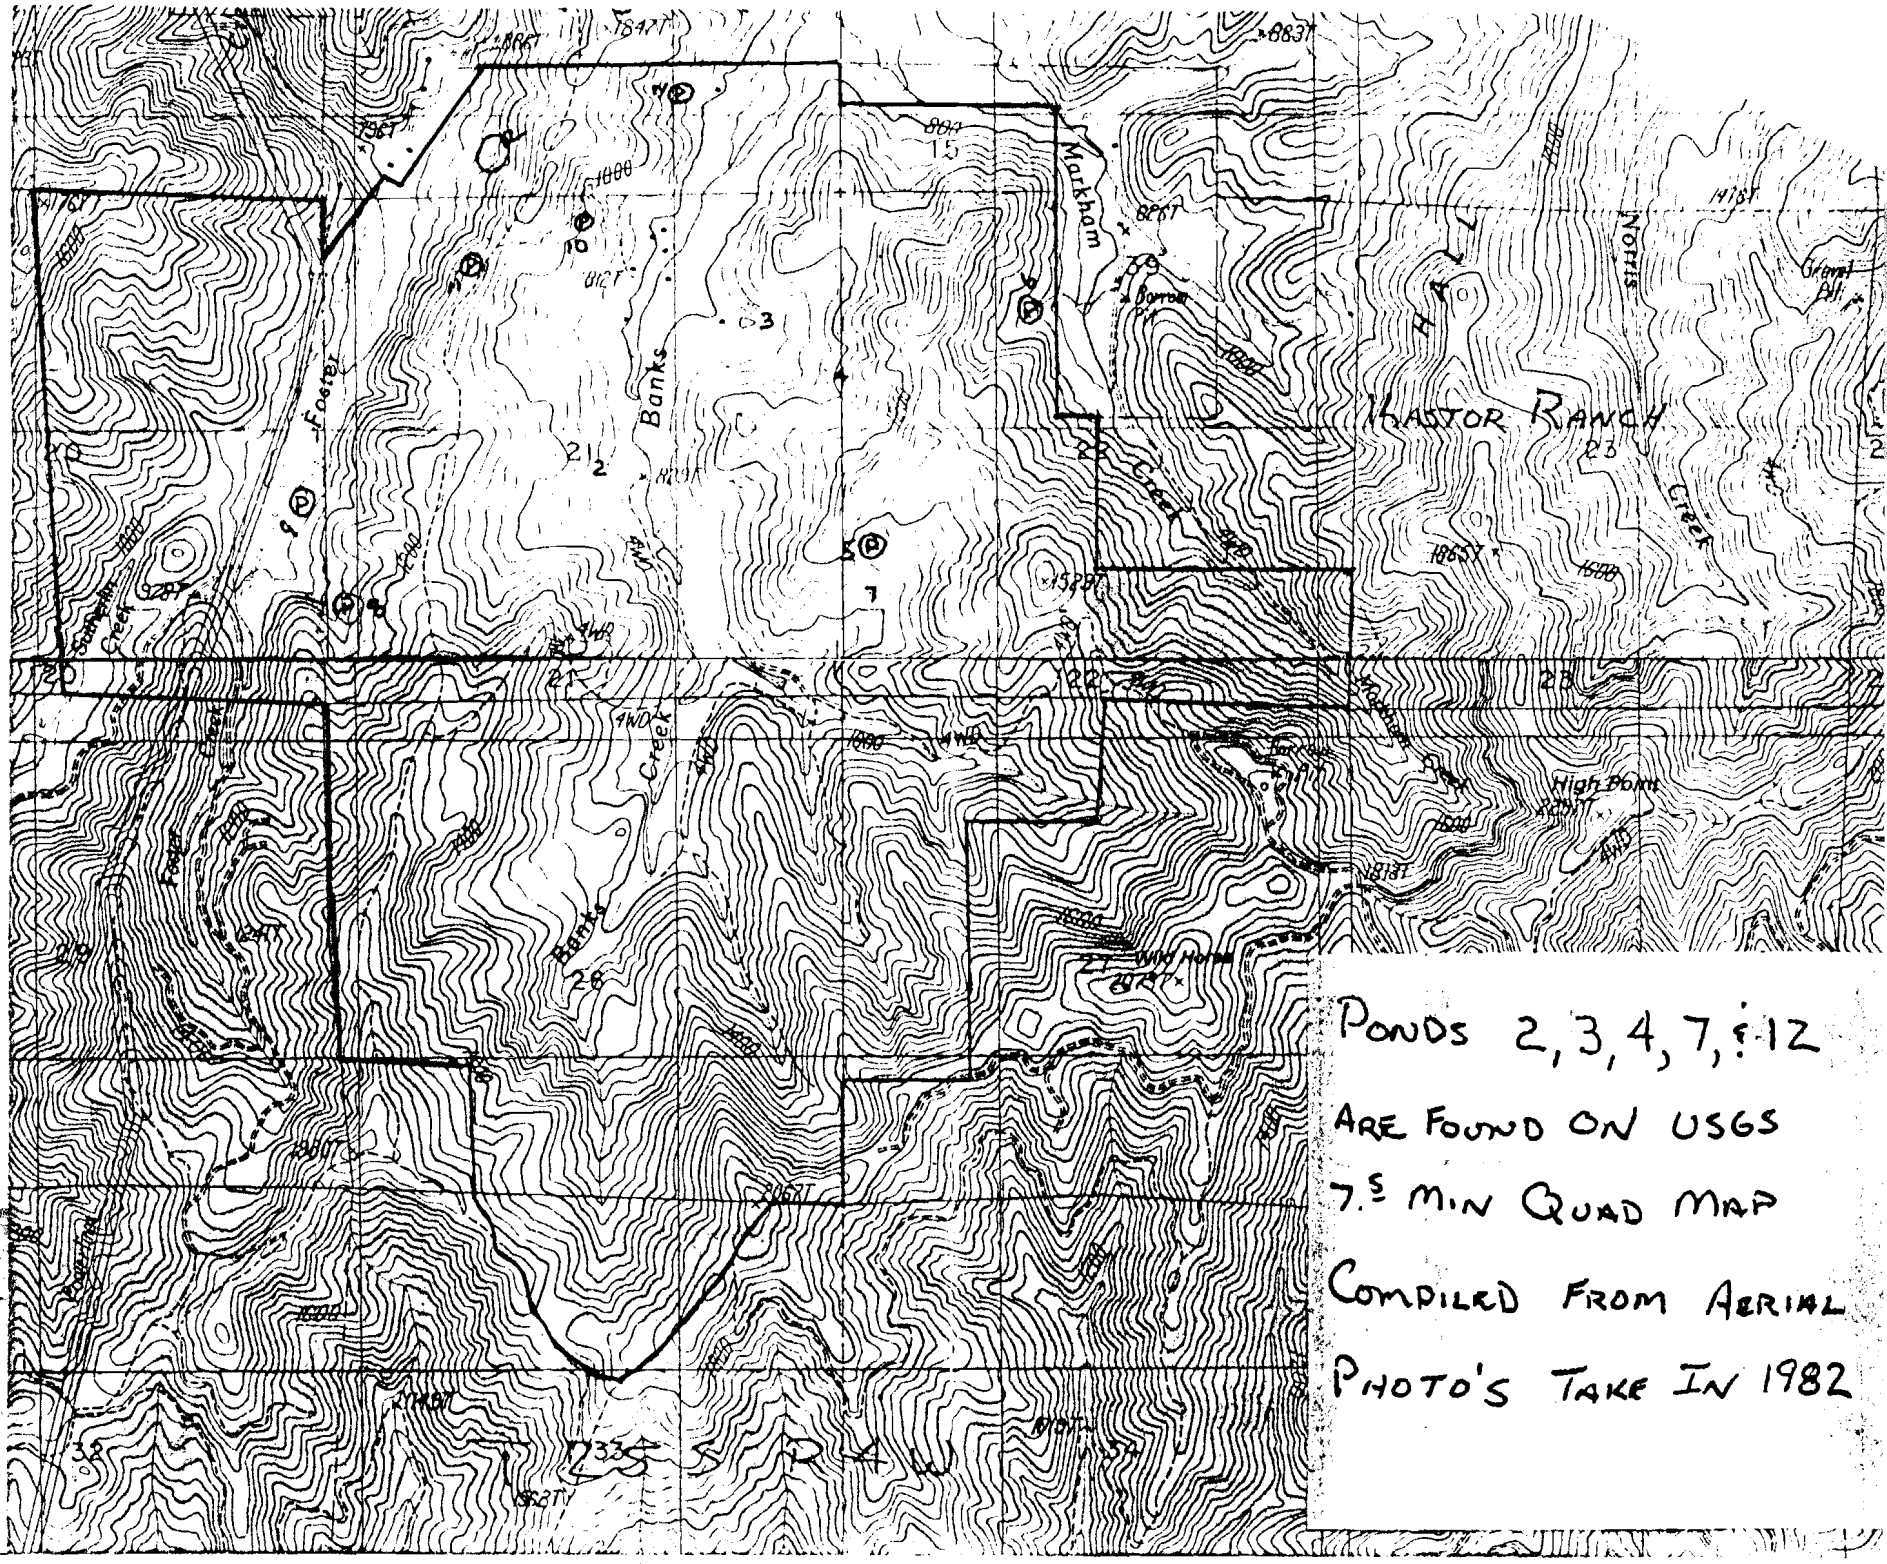

PONDS 2, 3, 4, 7, & 12
ARE FOUND ON USGS
7.5 MIN QUAD MAP
COMPILED FROM AERIAL
PHOTO'S TAKE IN 1982

No Final Proof Map available

No Permit Map available