


Application No R-76847
Permit No.

CERTIFICATE NO. 70766

SEE MAP 26 5 36

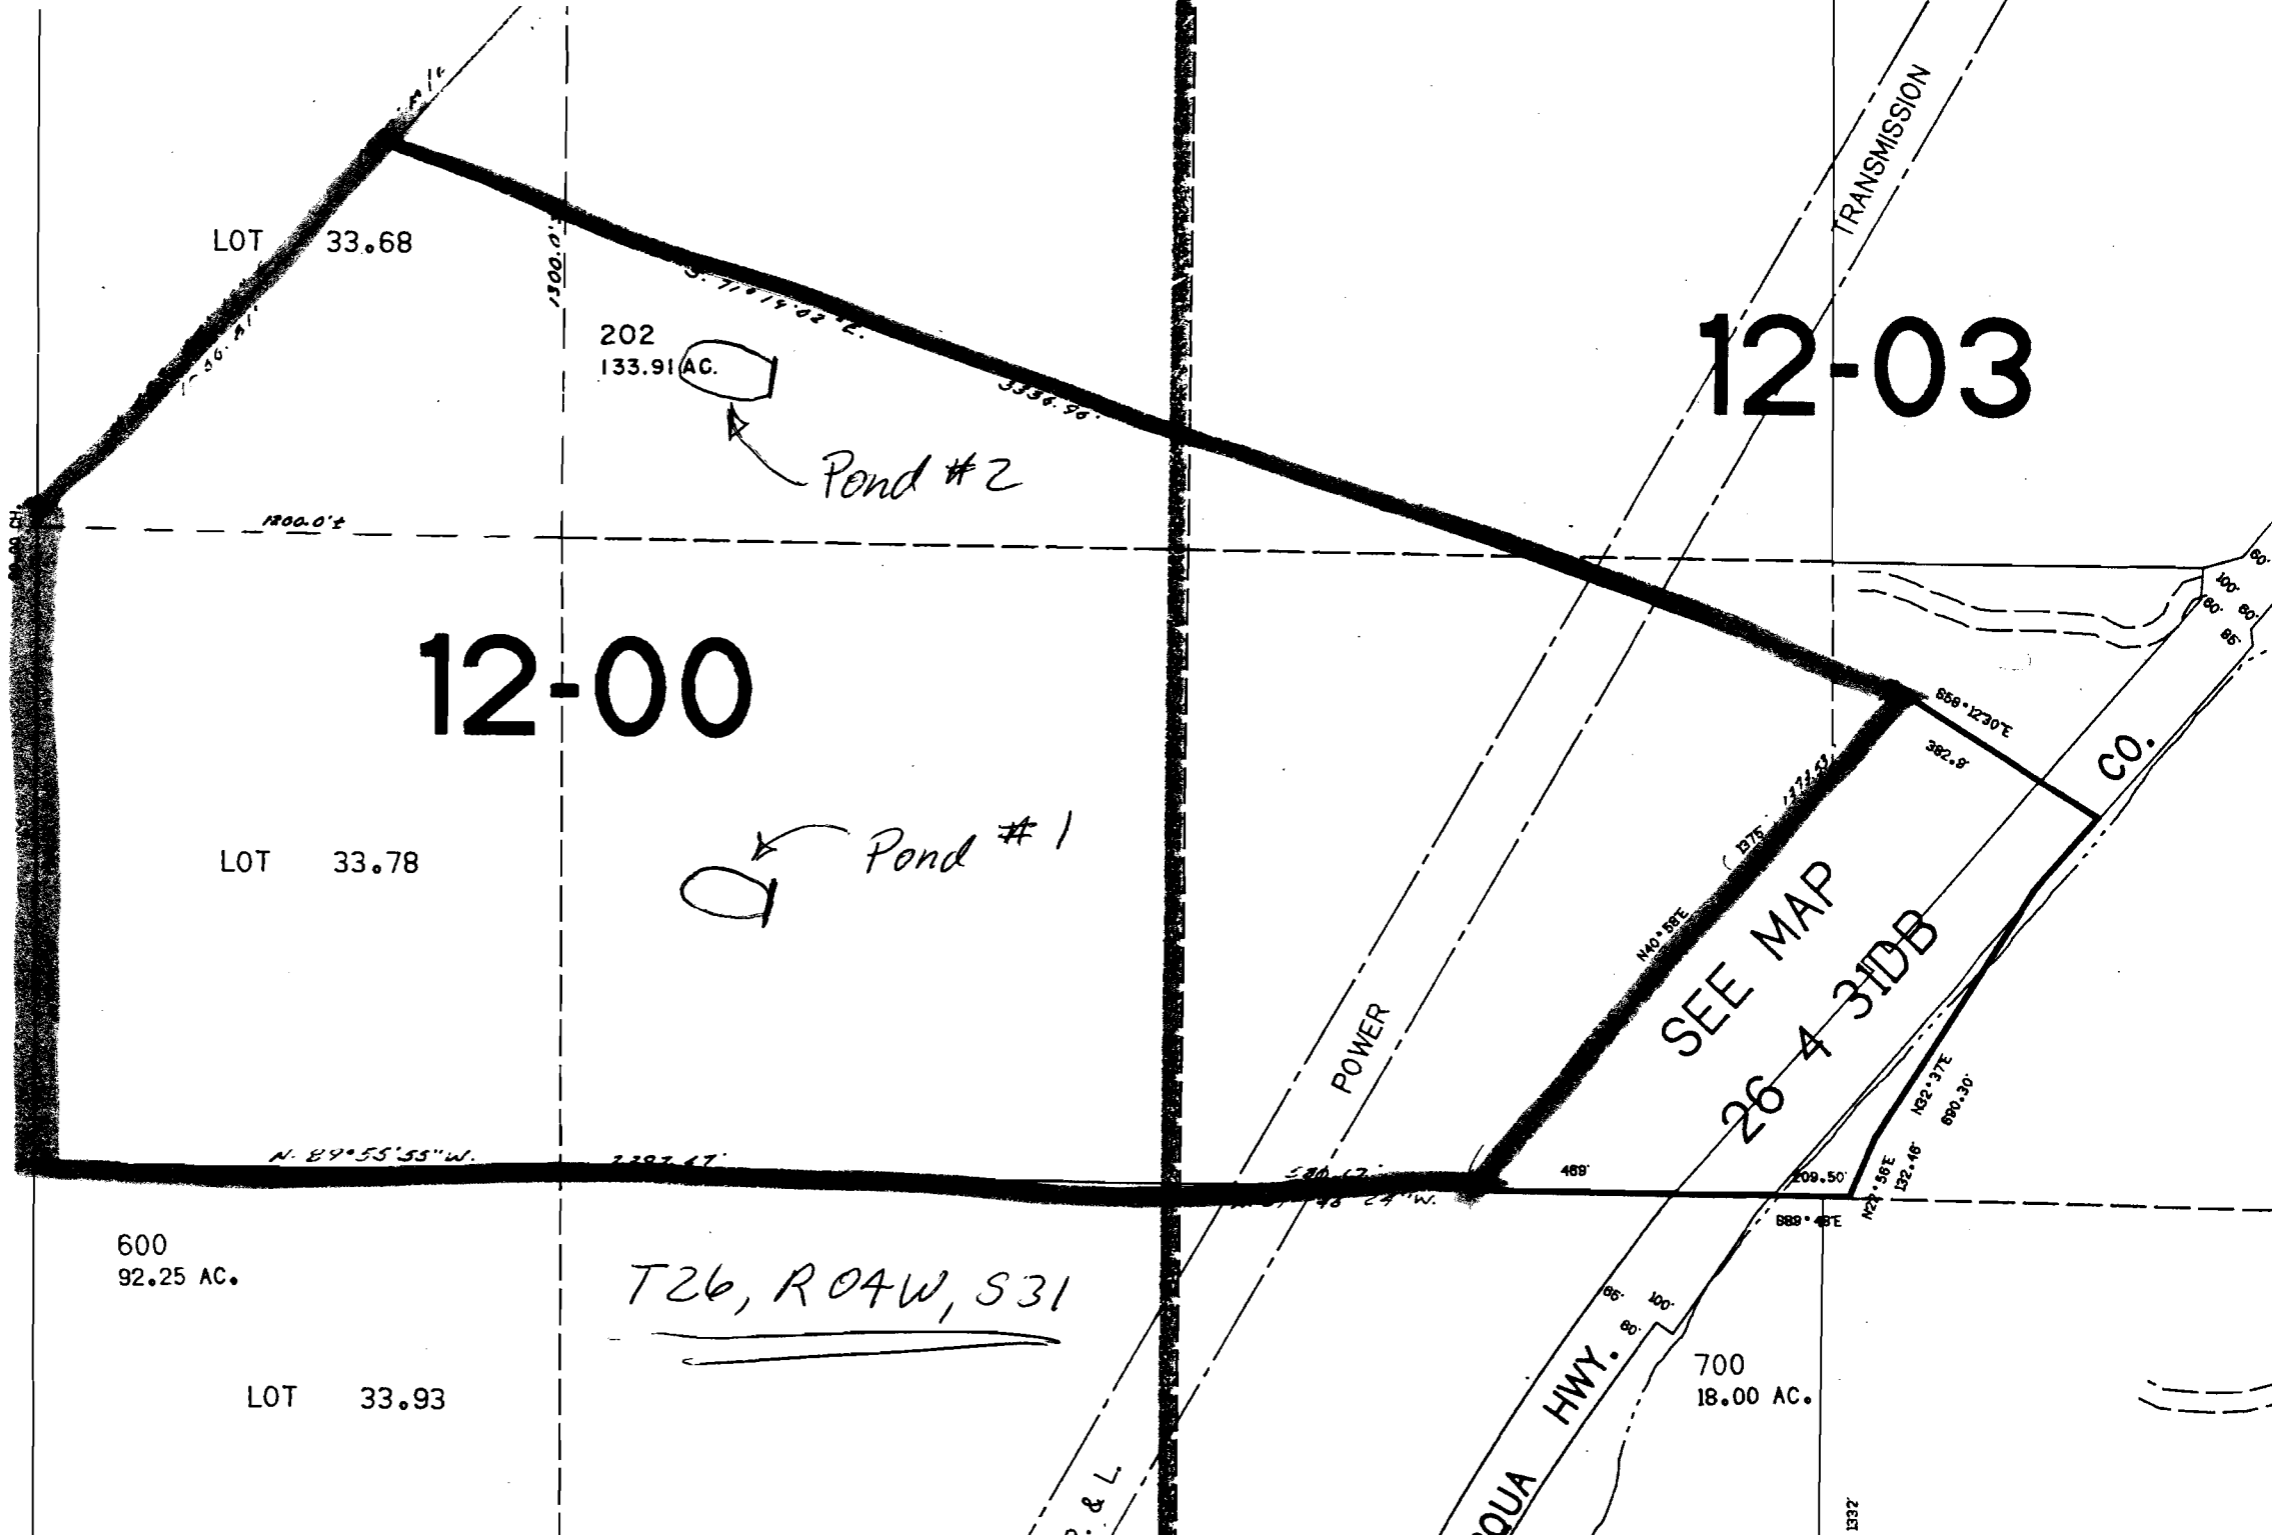

No Final Proof Map available

No Permit Map available