

Application No. 12-76849

Permit No.


DEC 2 1994

WATER RESOURCES DEPT SALEM, OREGON

MILTON-FREEWATER QUADRANGLE OREGON

7.5 MINUTE SERIES (TOPOGRAPHIC)

CERTIFICATE NO. 70768

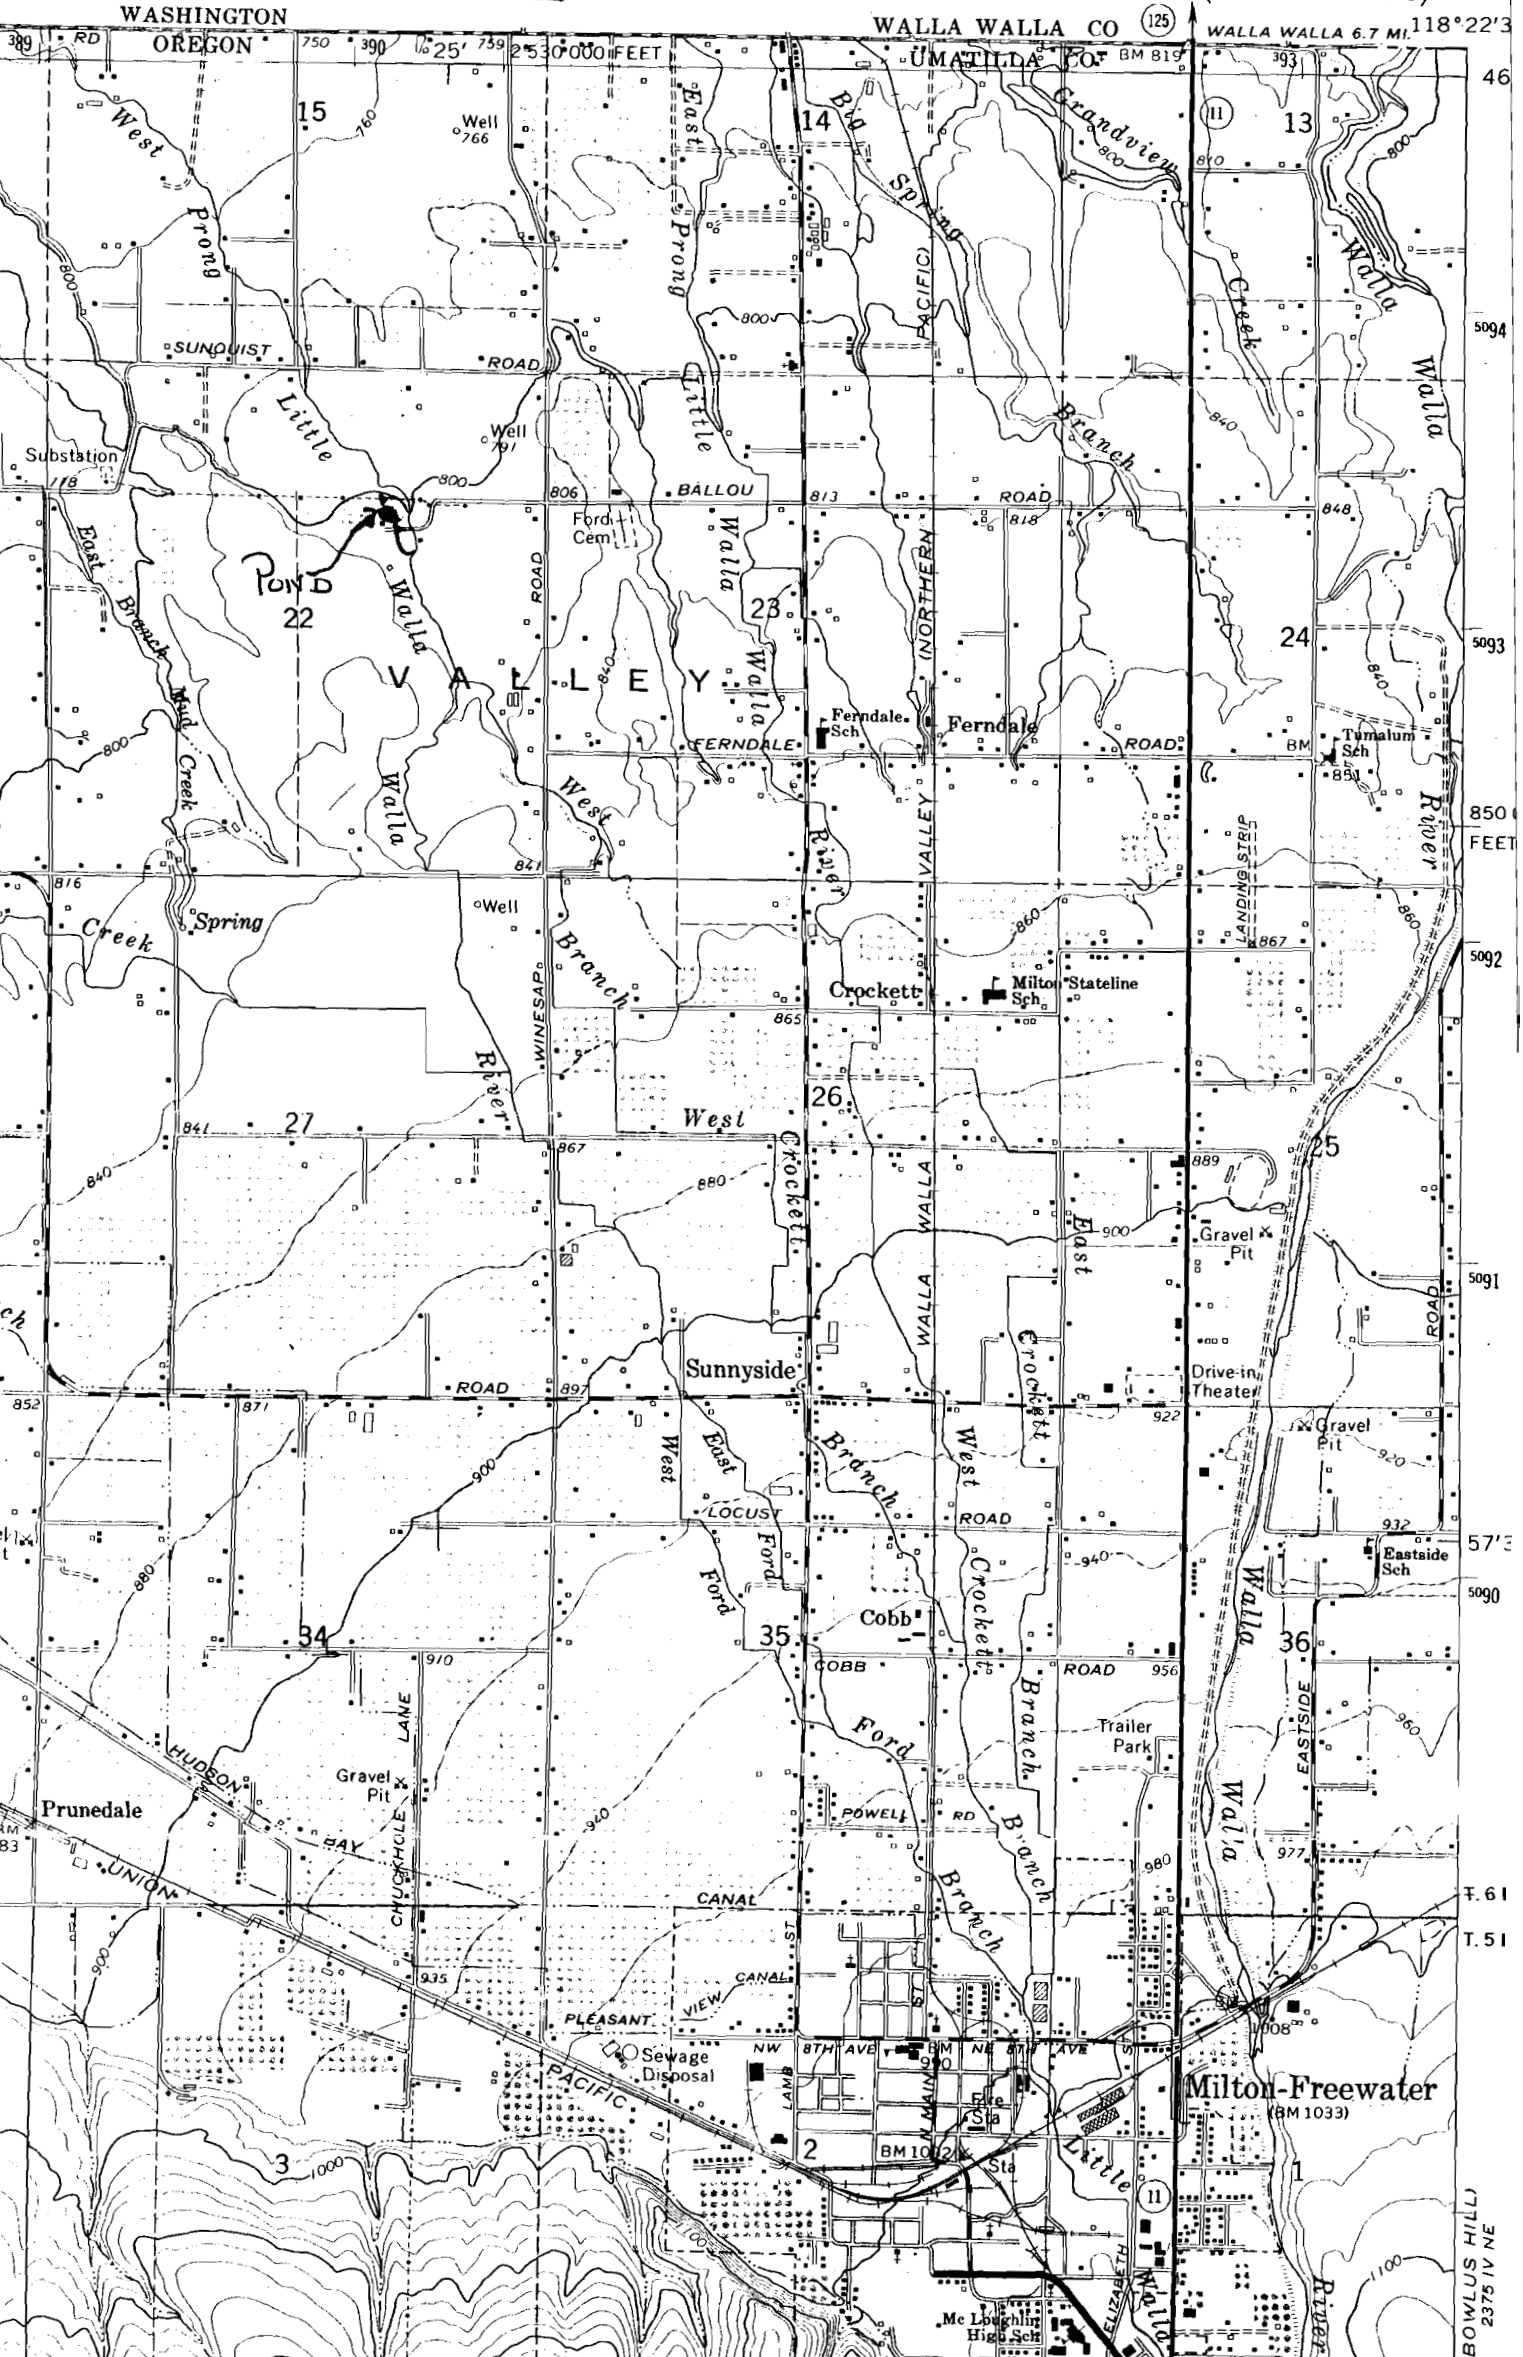

BOWLUS HILL 2375 IV NE

No Final Proof Map available

No Permit Map available