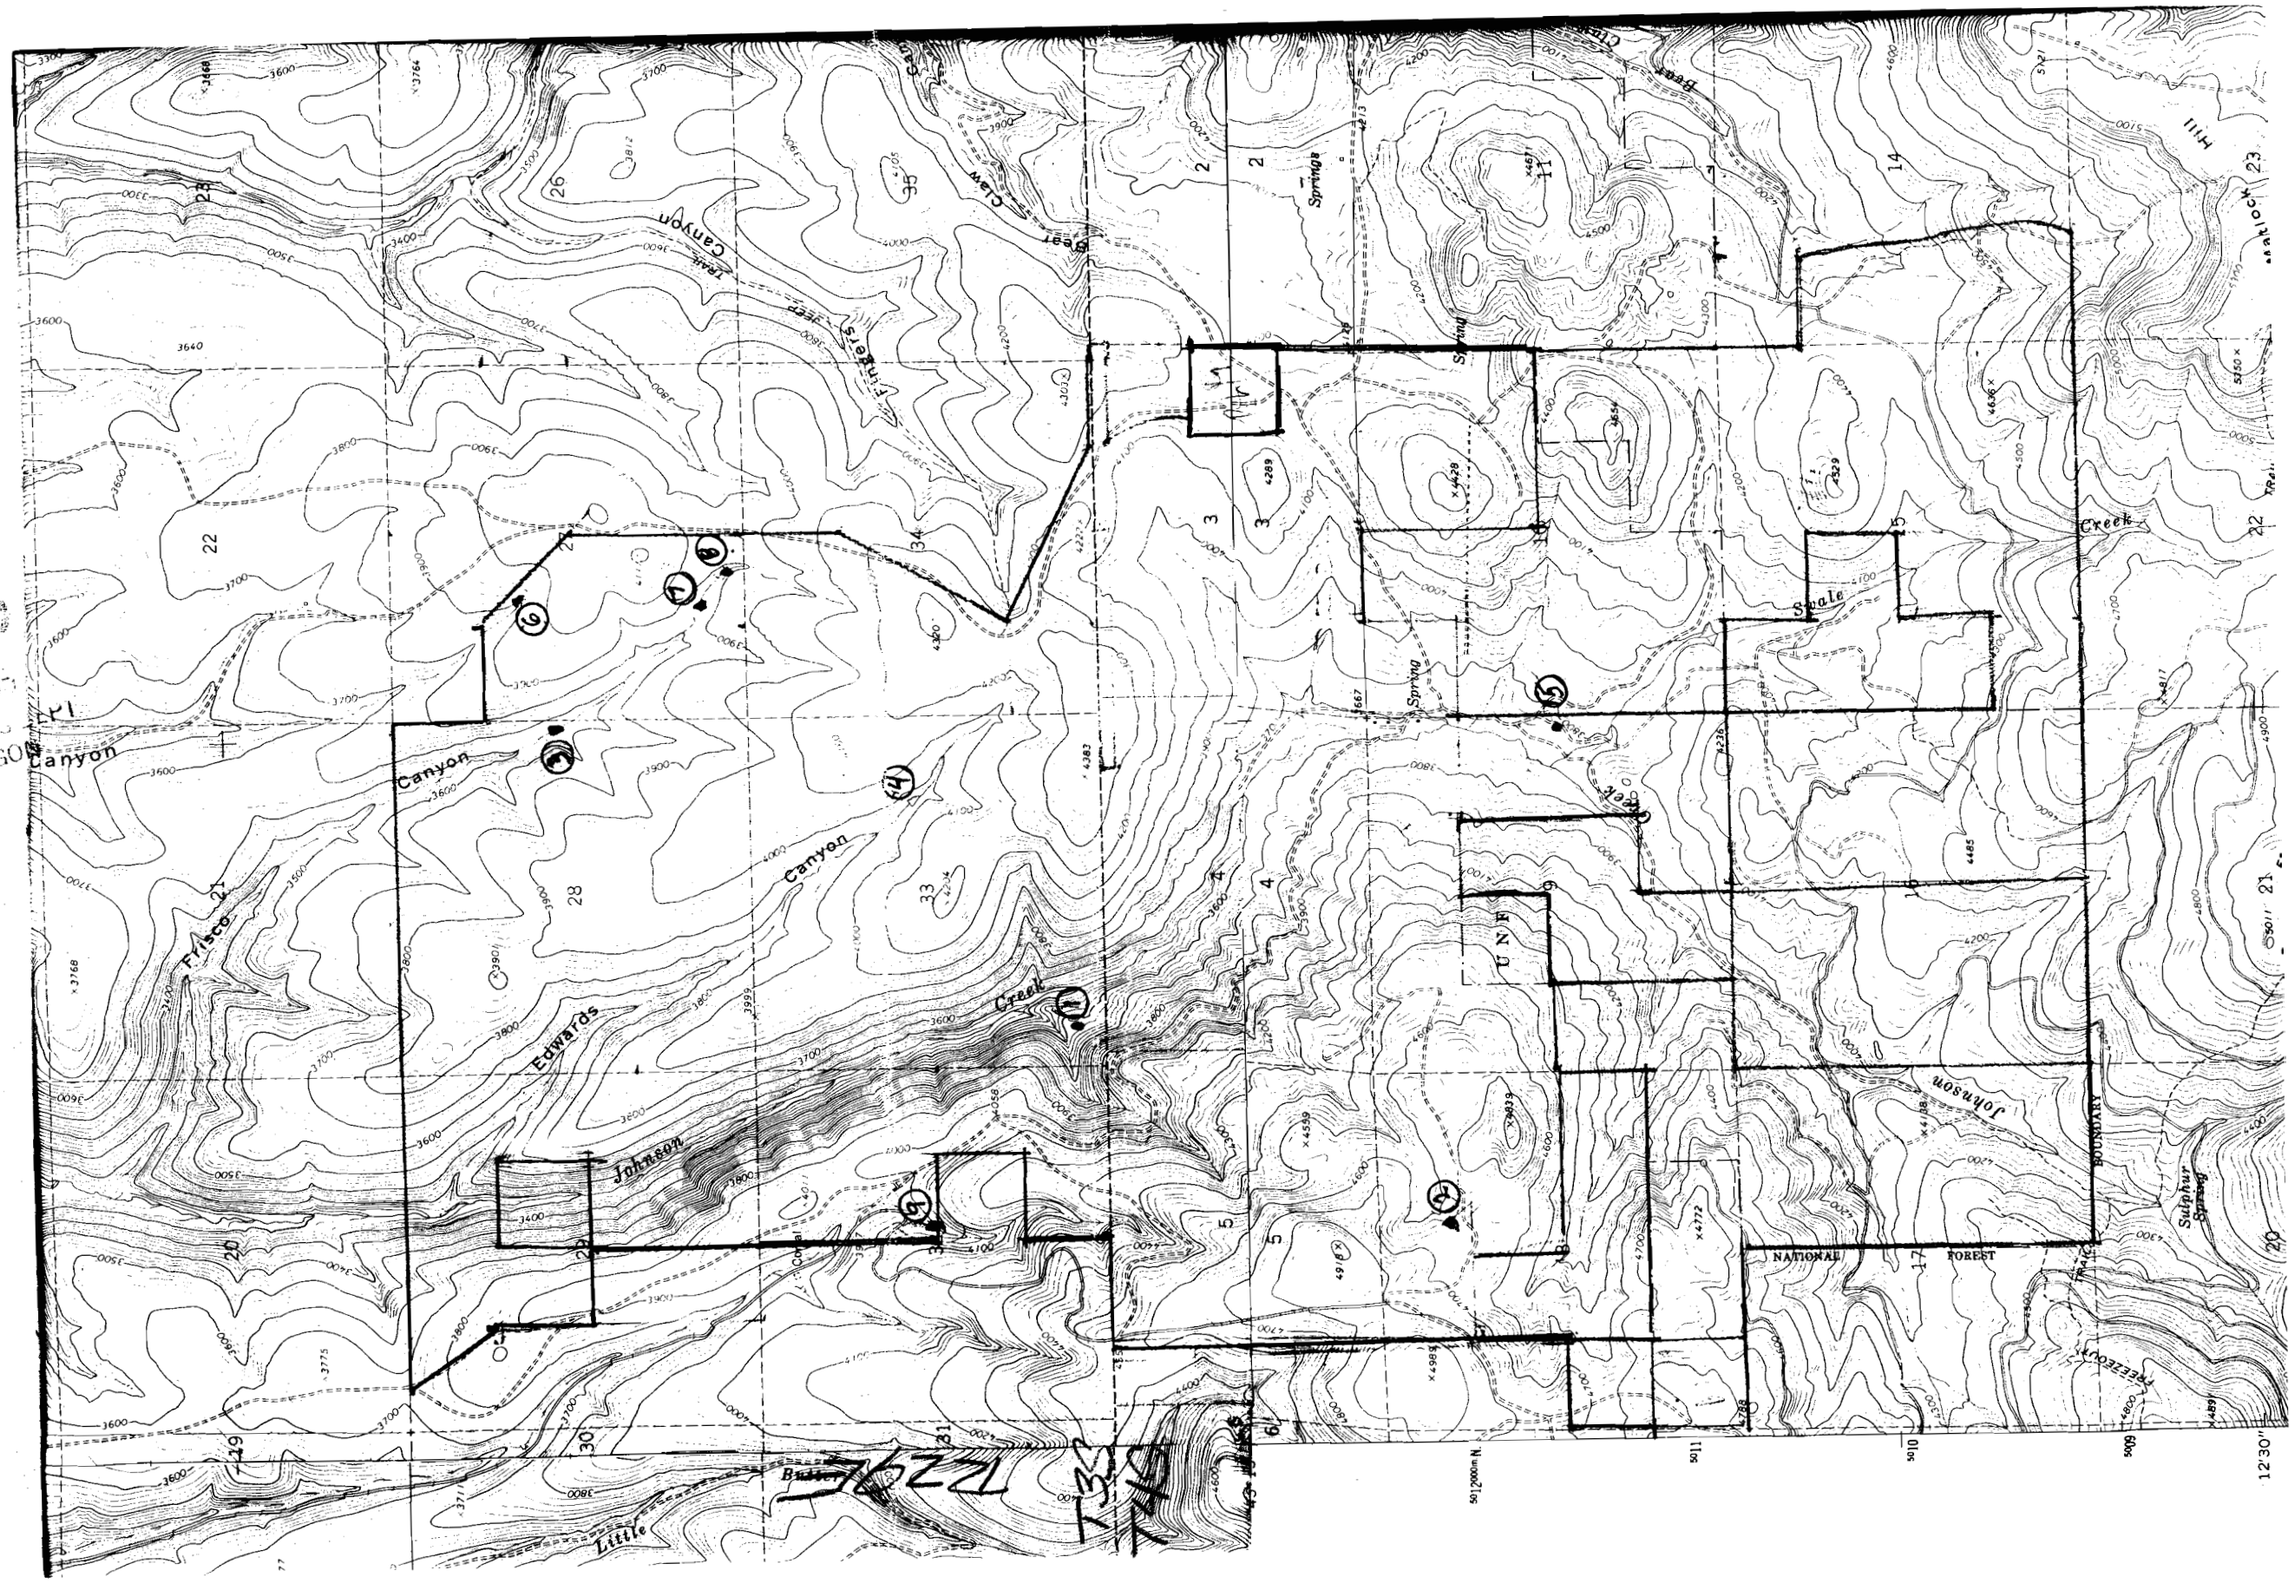

Application No. R-76857

Permit No. CERTIFICATE NO. 70776

No Final Proof Map available

No Permit Map available