

RECEIVED

JAN 23 1995

OREGON


SECTION 32 T.24S. R.4W. W.M.
DOUGLAS COUNTY

1"-400'

Application No. R-76873
Permit No.

CERTIFICATE NO. 70785

SEE MAP 24 4 29

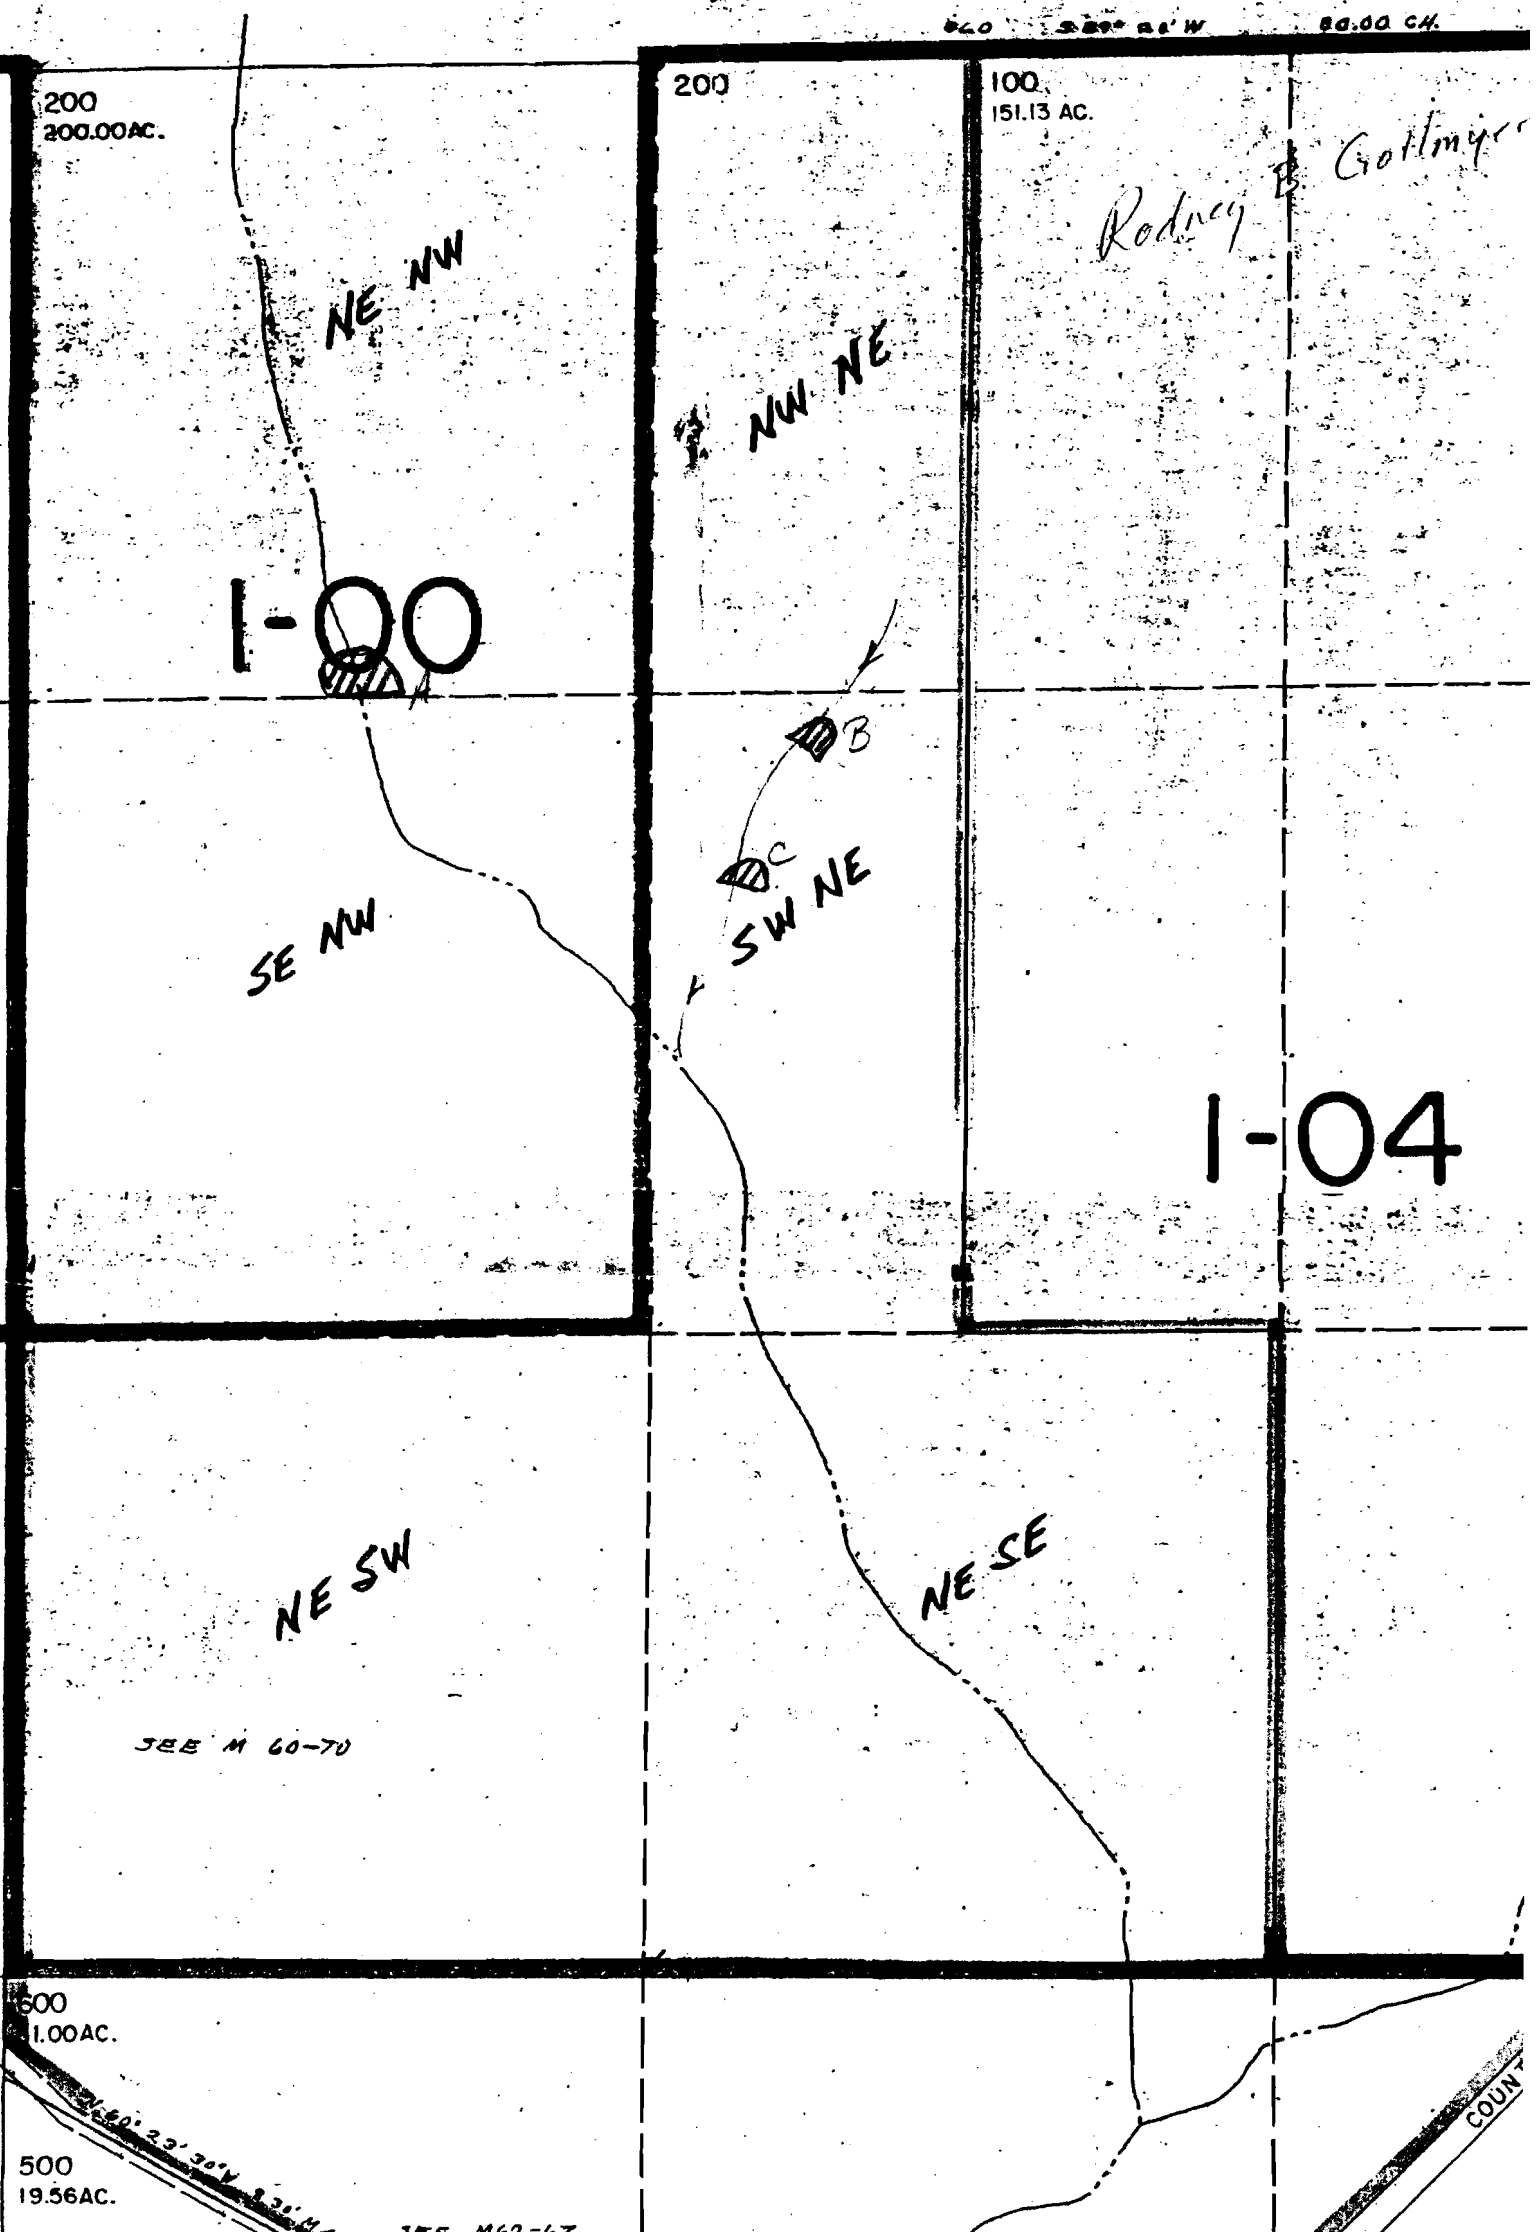

No Final Proof Map available

No Permit Map available