


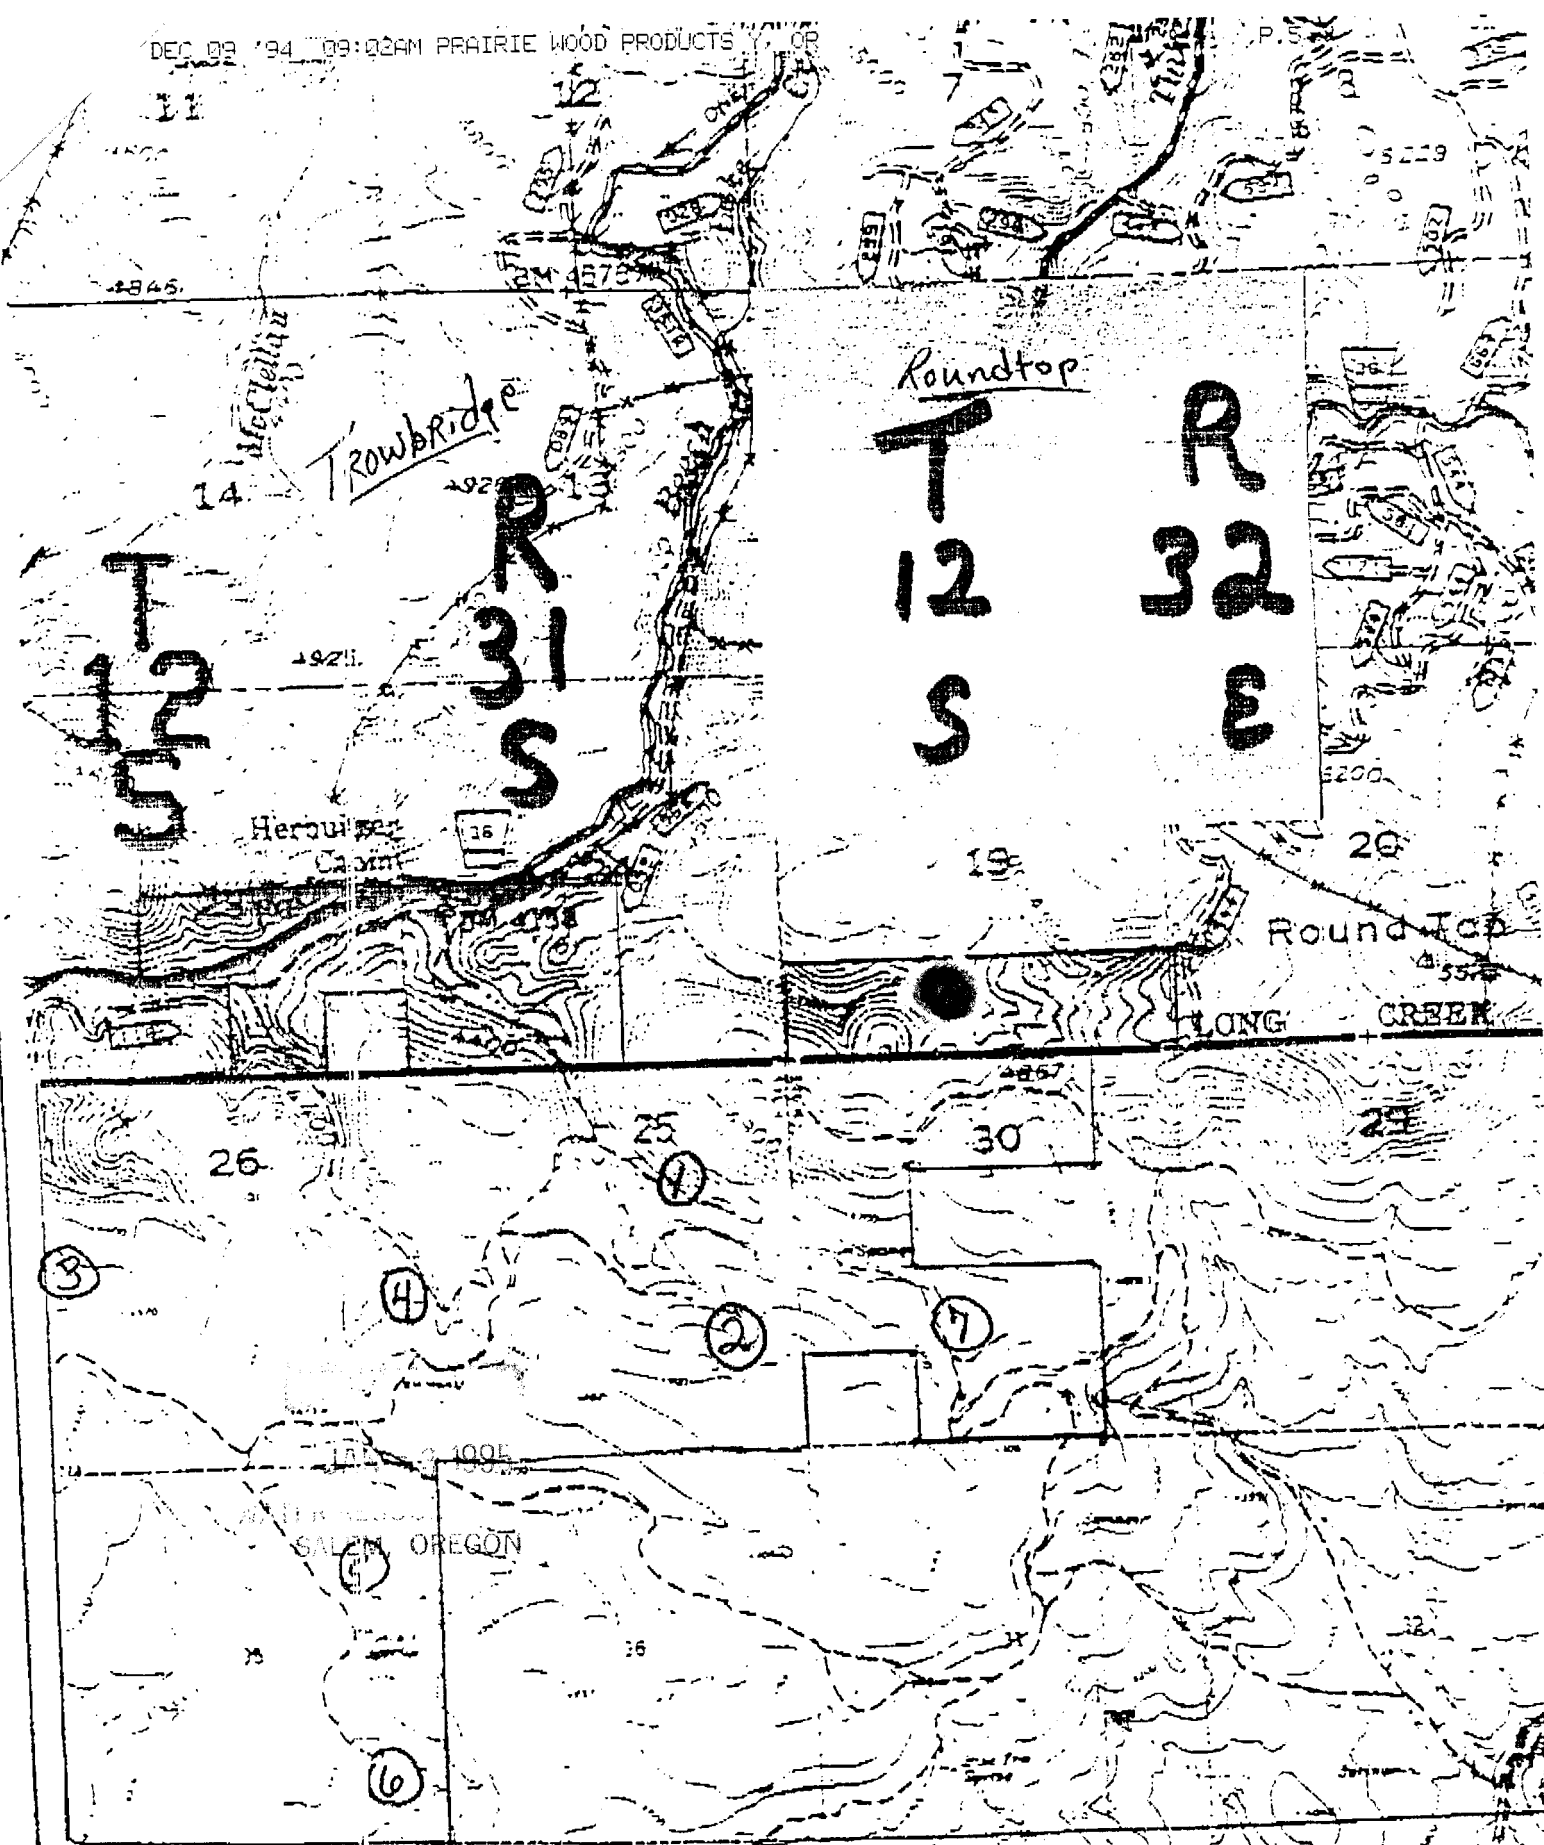

Application No. 17600

Permit No. 17600

No Final Proof Map available

No Permit Map available