


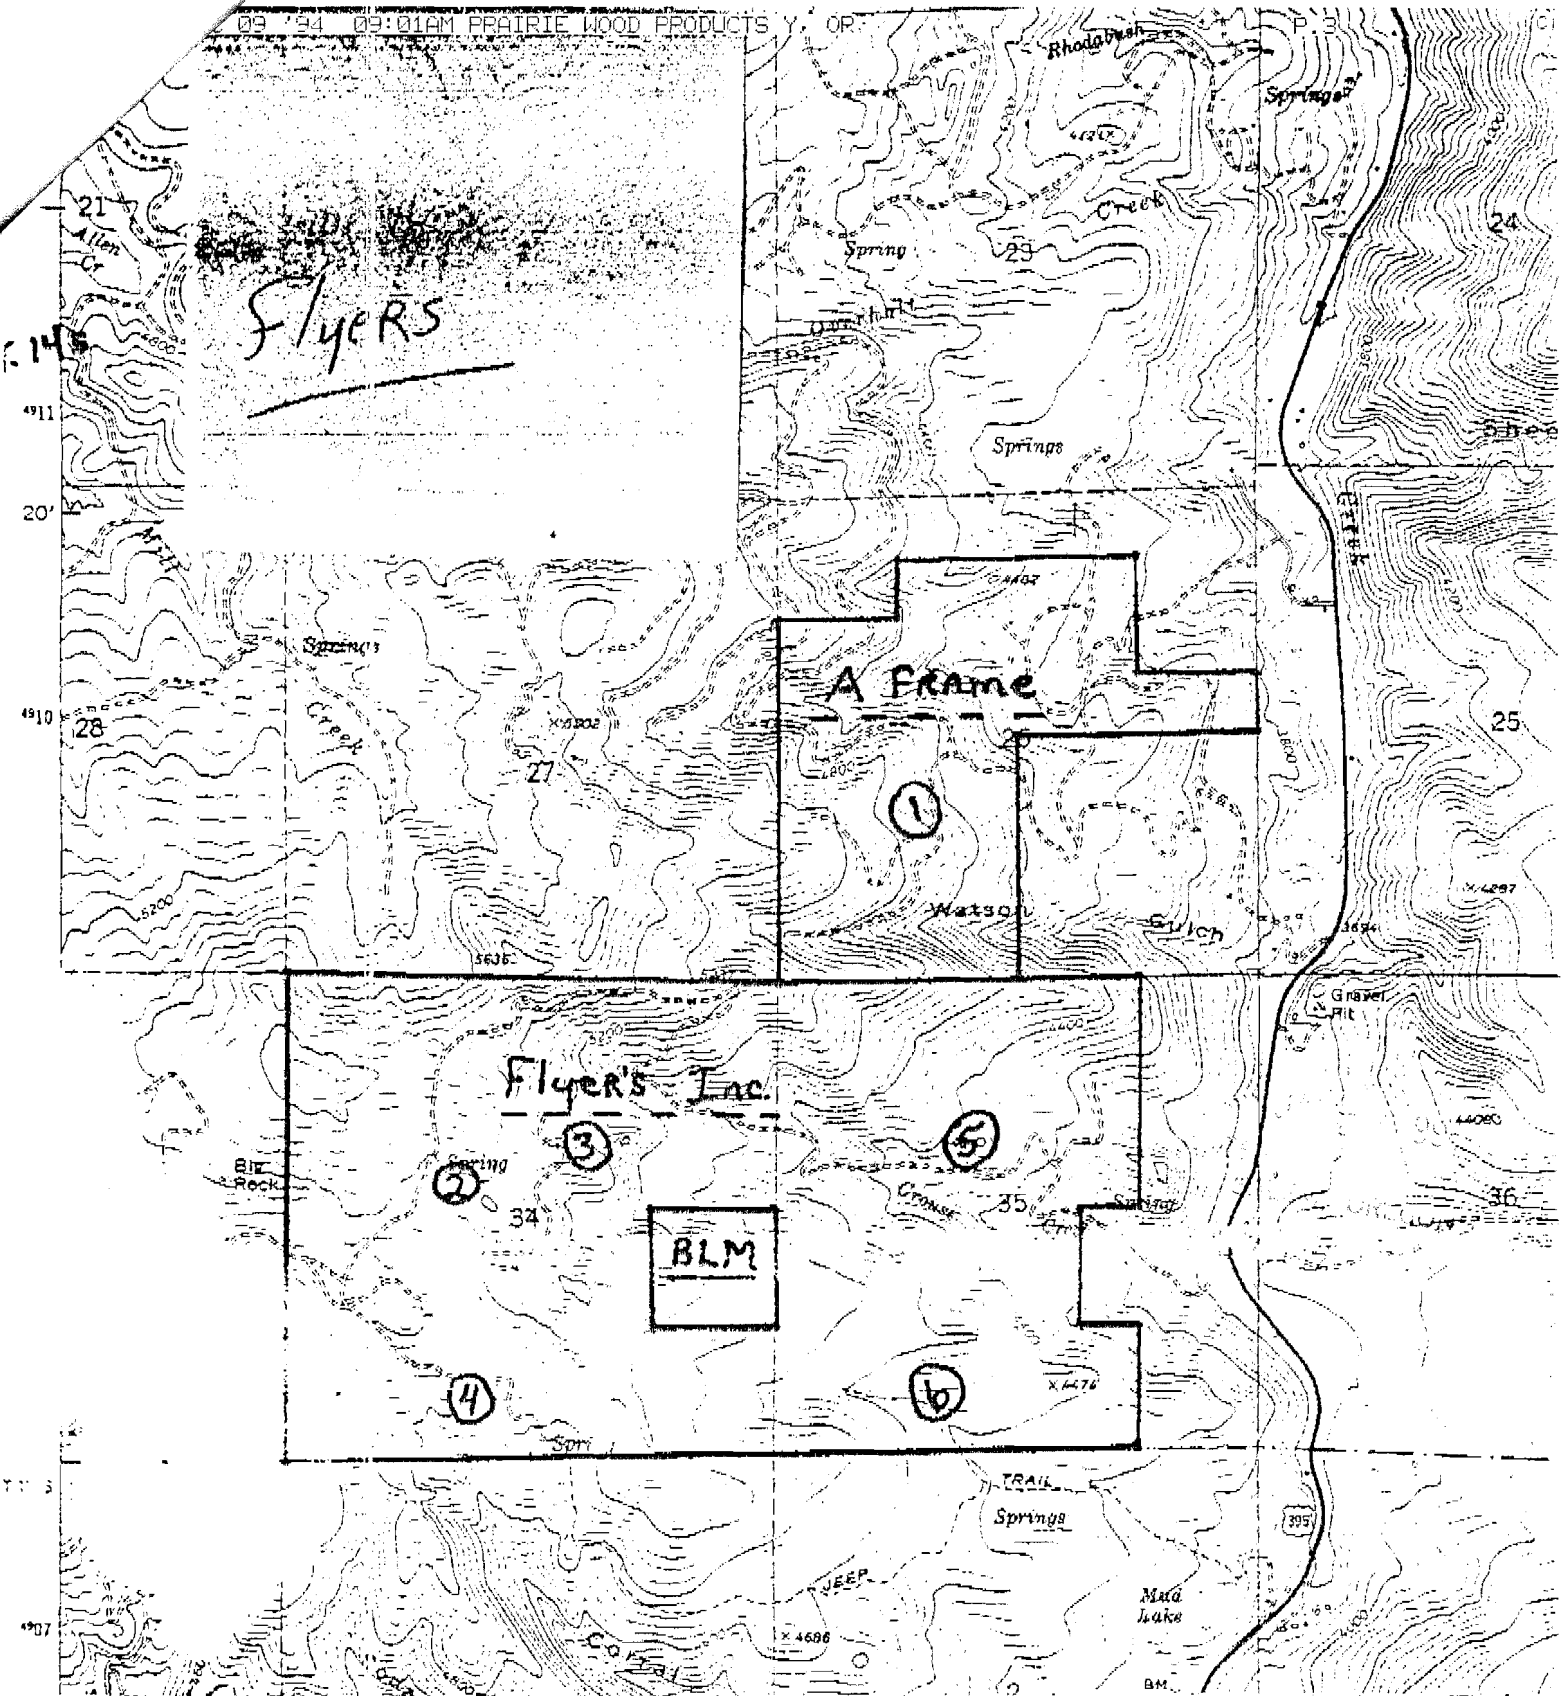

Application No. 2-76883
Permit No.

UNIFICATE NO. 1202