



This map was prepared for
assessment purpose only.

SCALE 1:48000

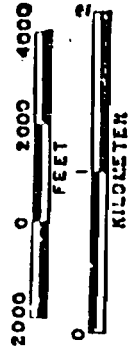

SEE MAP 10 25

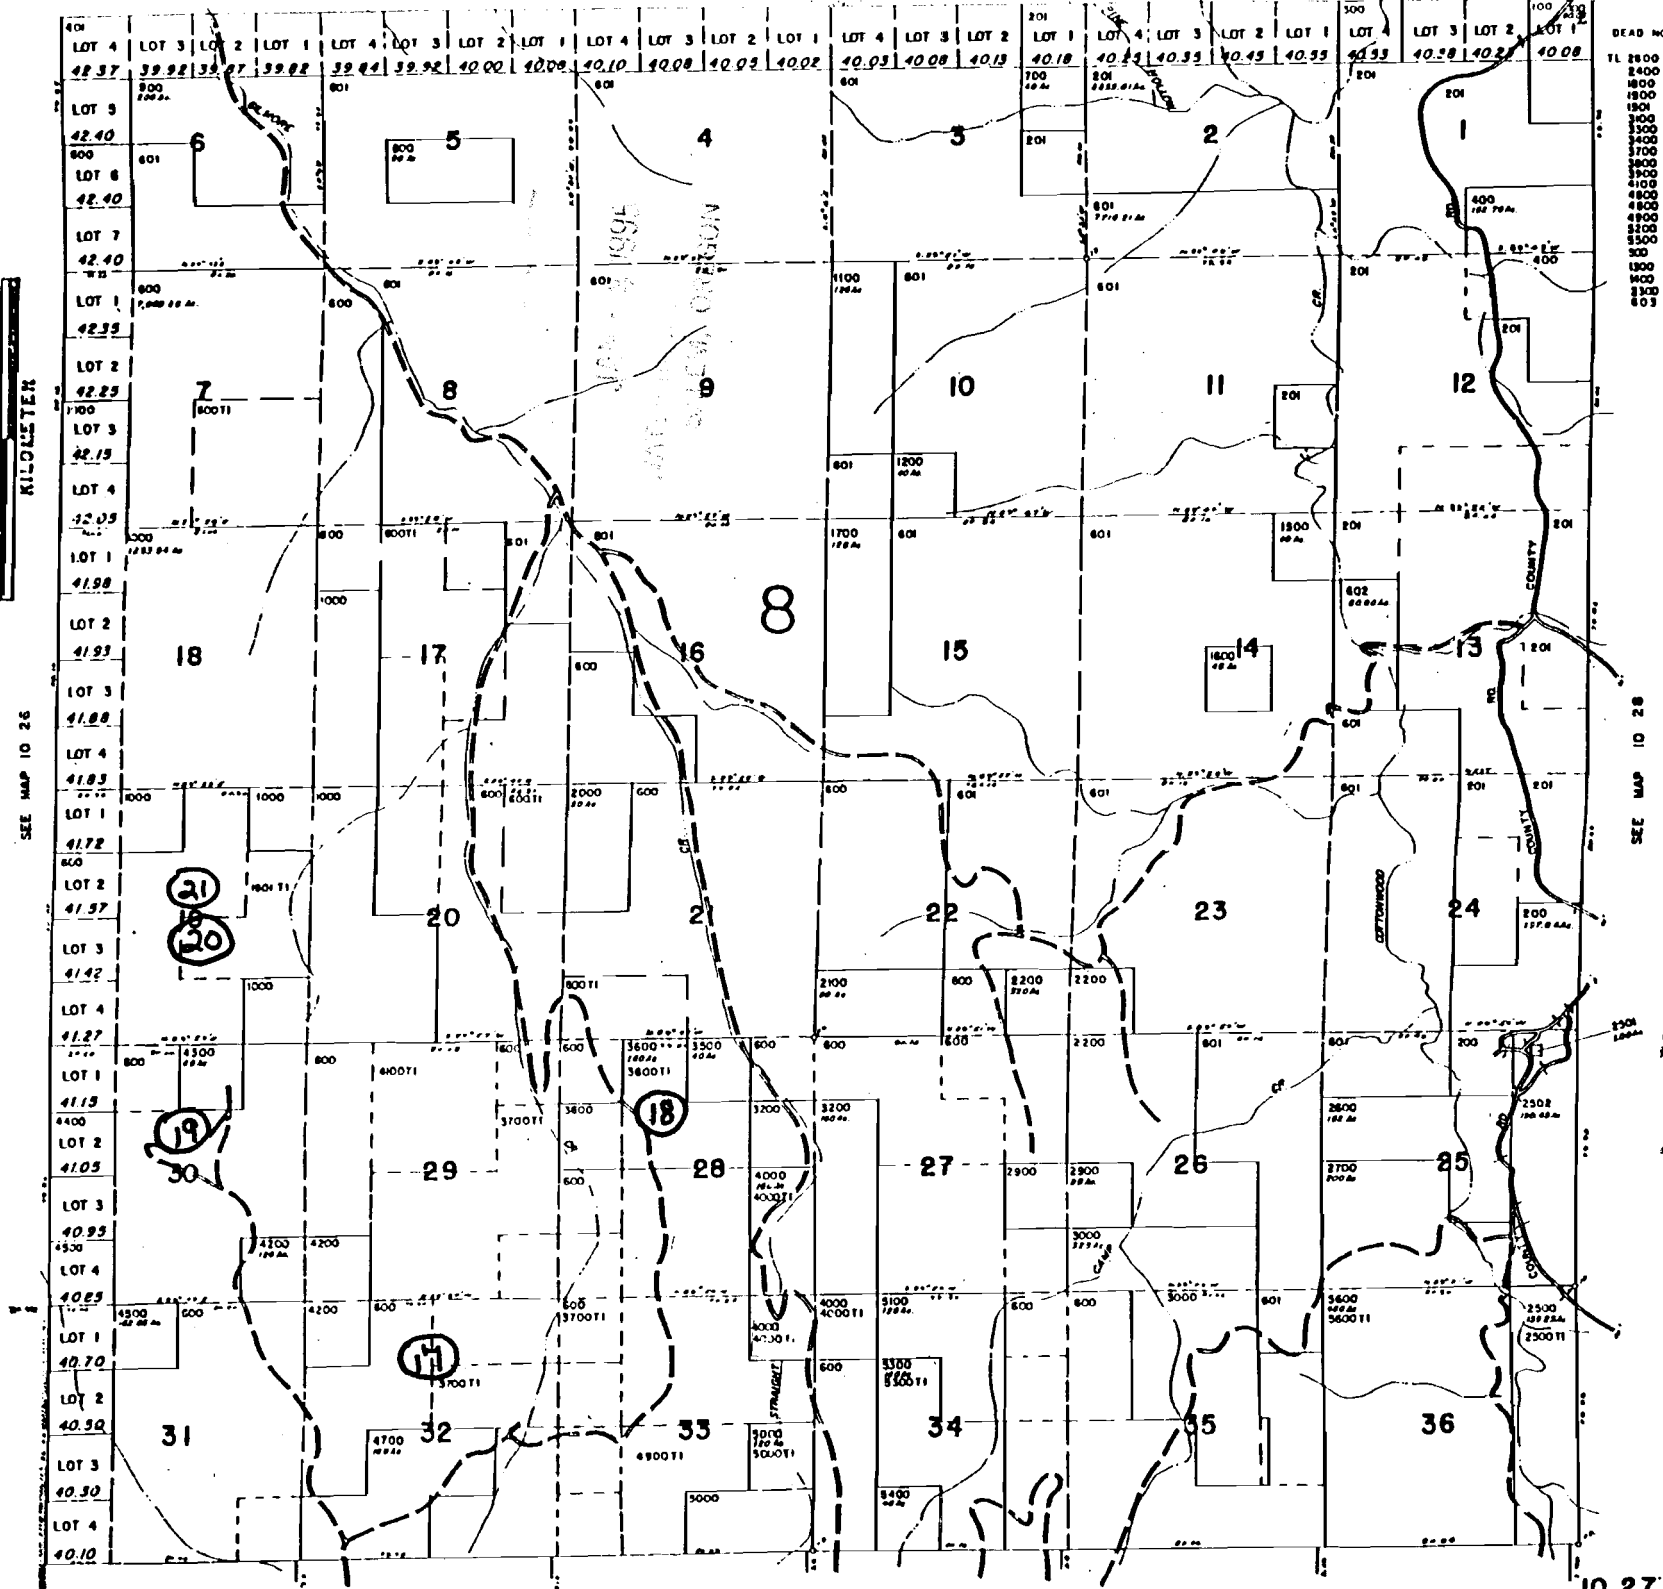

DEAD NO
TL 2800
2400
1800

SEE MAP 10 28

Application No. R-76885
Permit No.

CERTIFICATE NO. 7234

10 27

10 27

No Final Proof Map available

No Permit Map available