


T. 16s. R 30 E.

DEC 07 '94 11:17AM PRAIRIE WOOD PRODUCTS Y. OR
P.P. 4

MALHEUR USFS
NATIONAL
FOREST

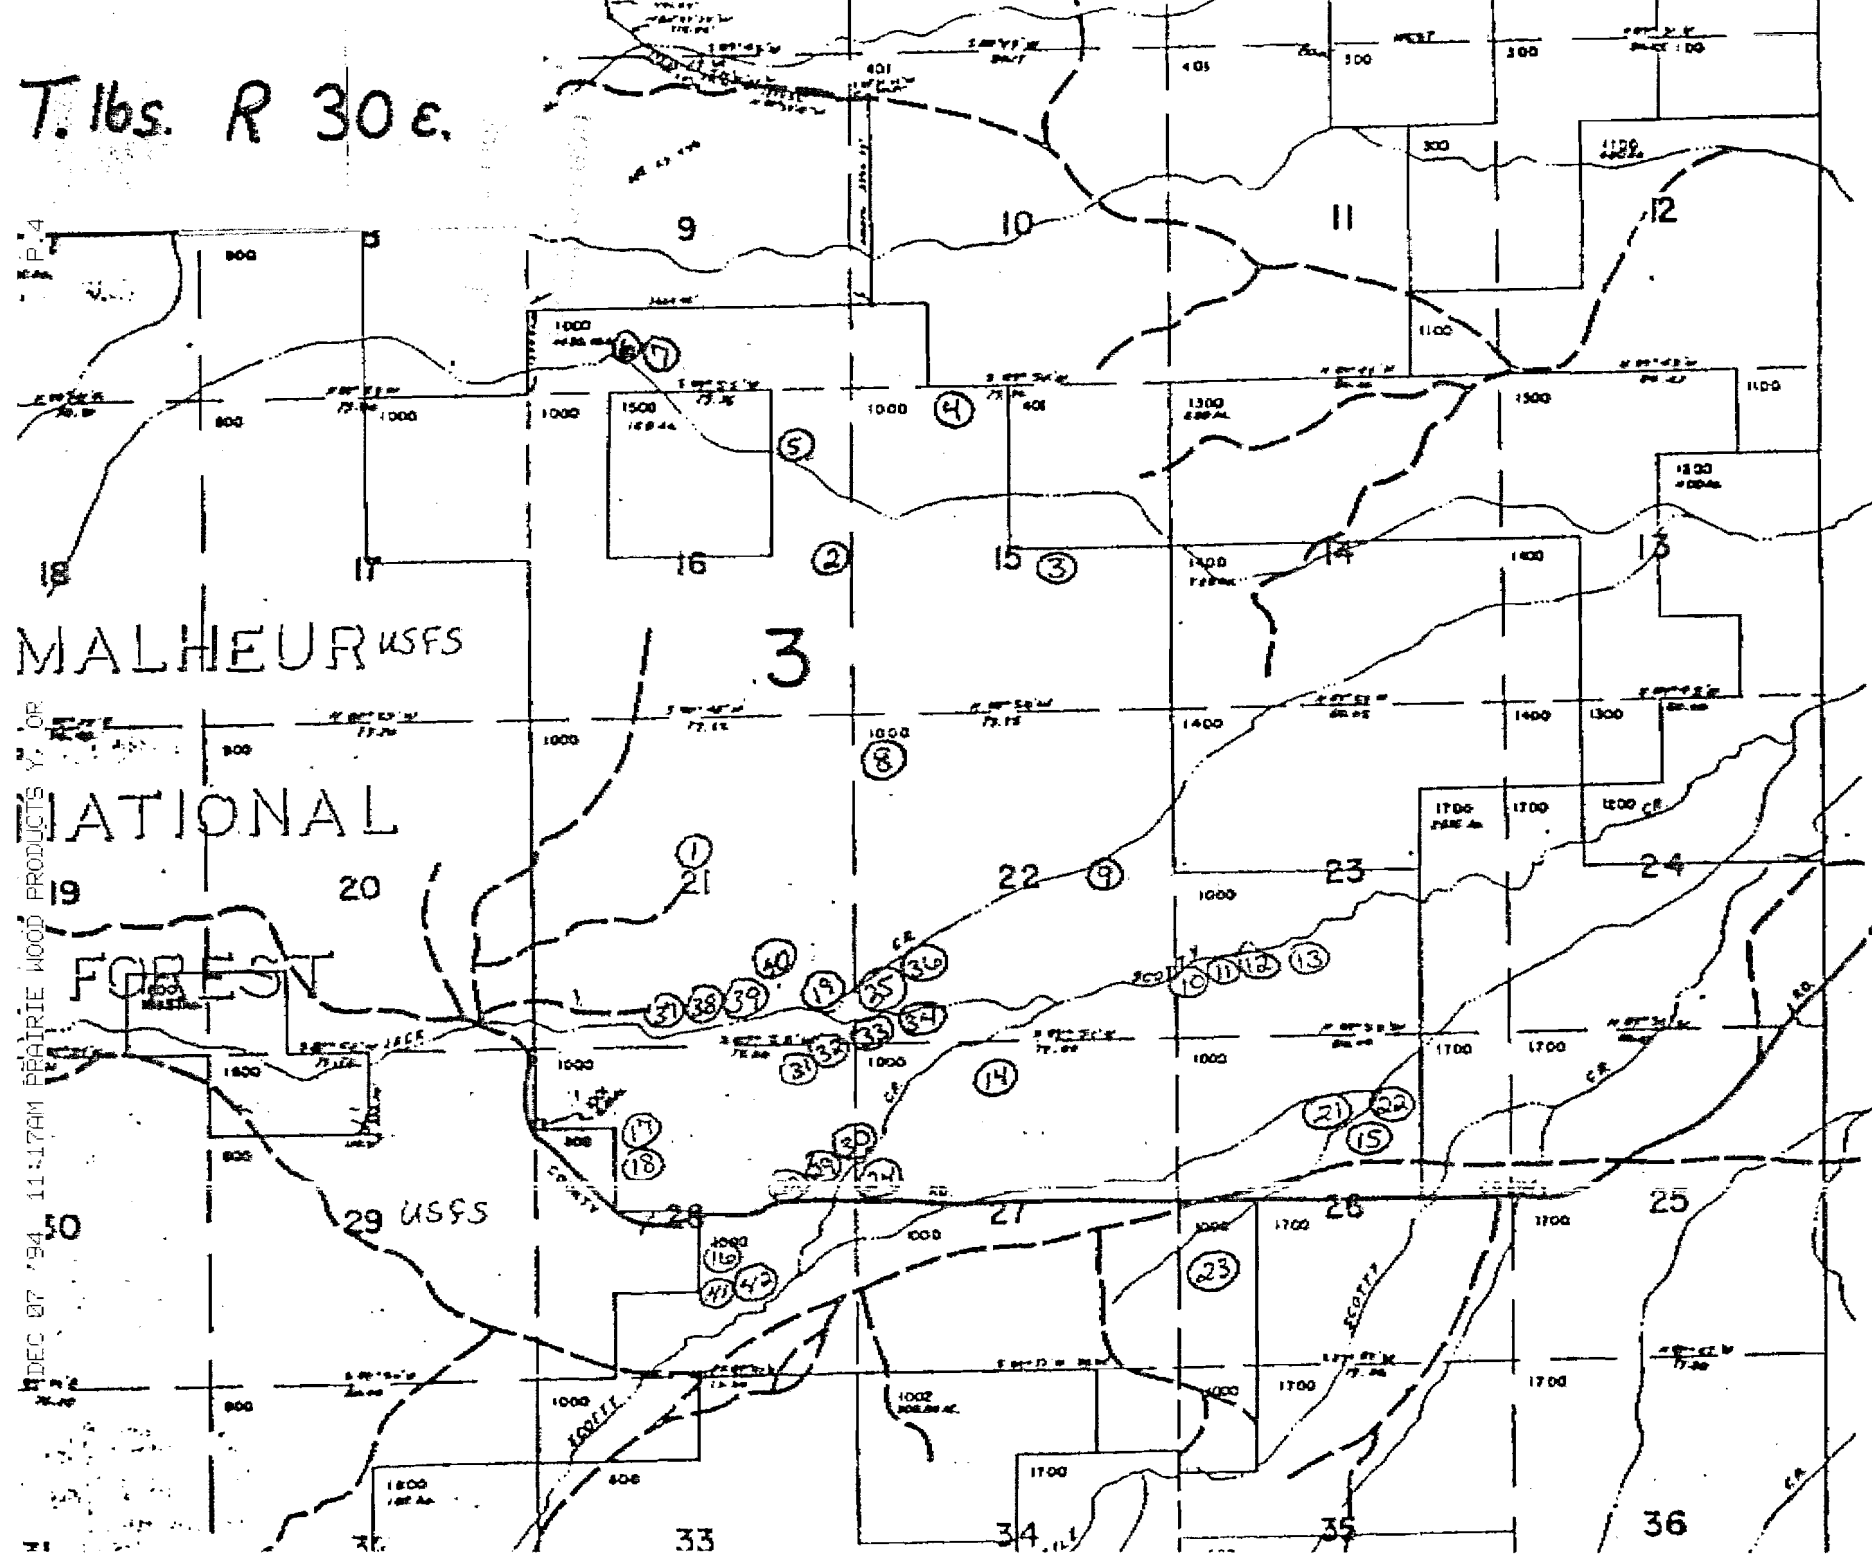

Application No. 2-76888
Permit No.

SEE MAP 16 31

DATE NO. 10-19-97

No Final Proof Map available

No Permit Map available