


T. 16s. R. 30 E.

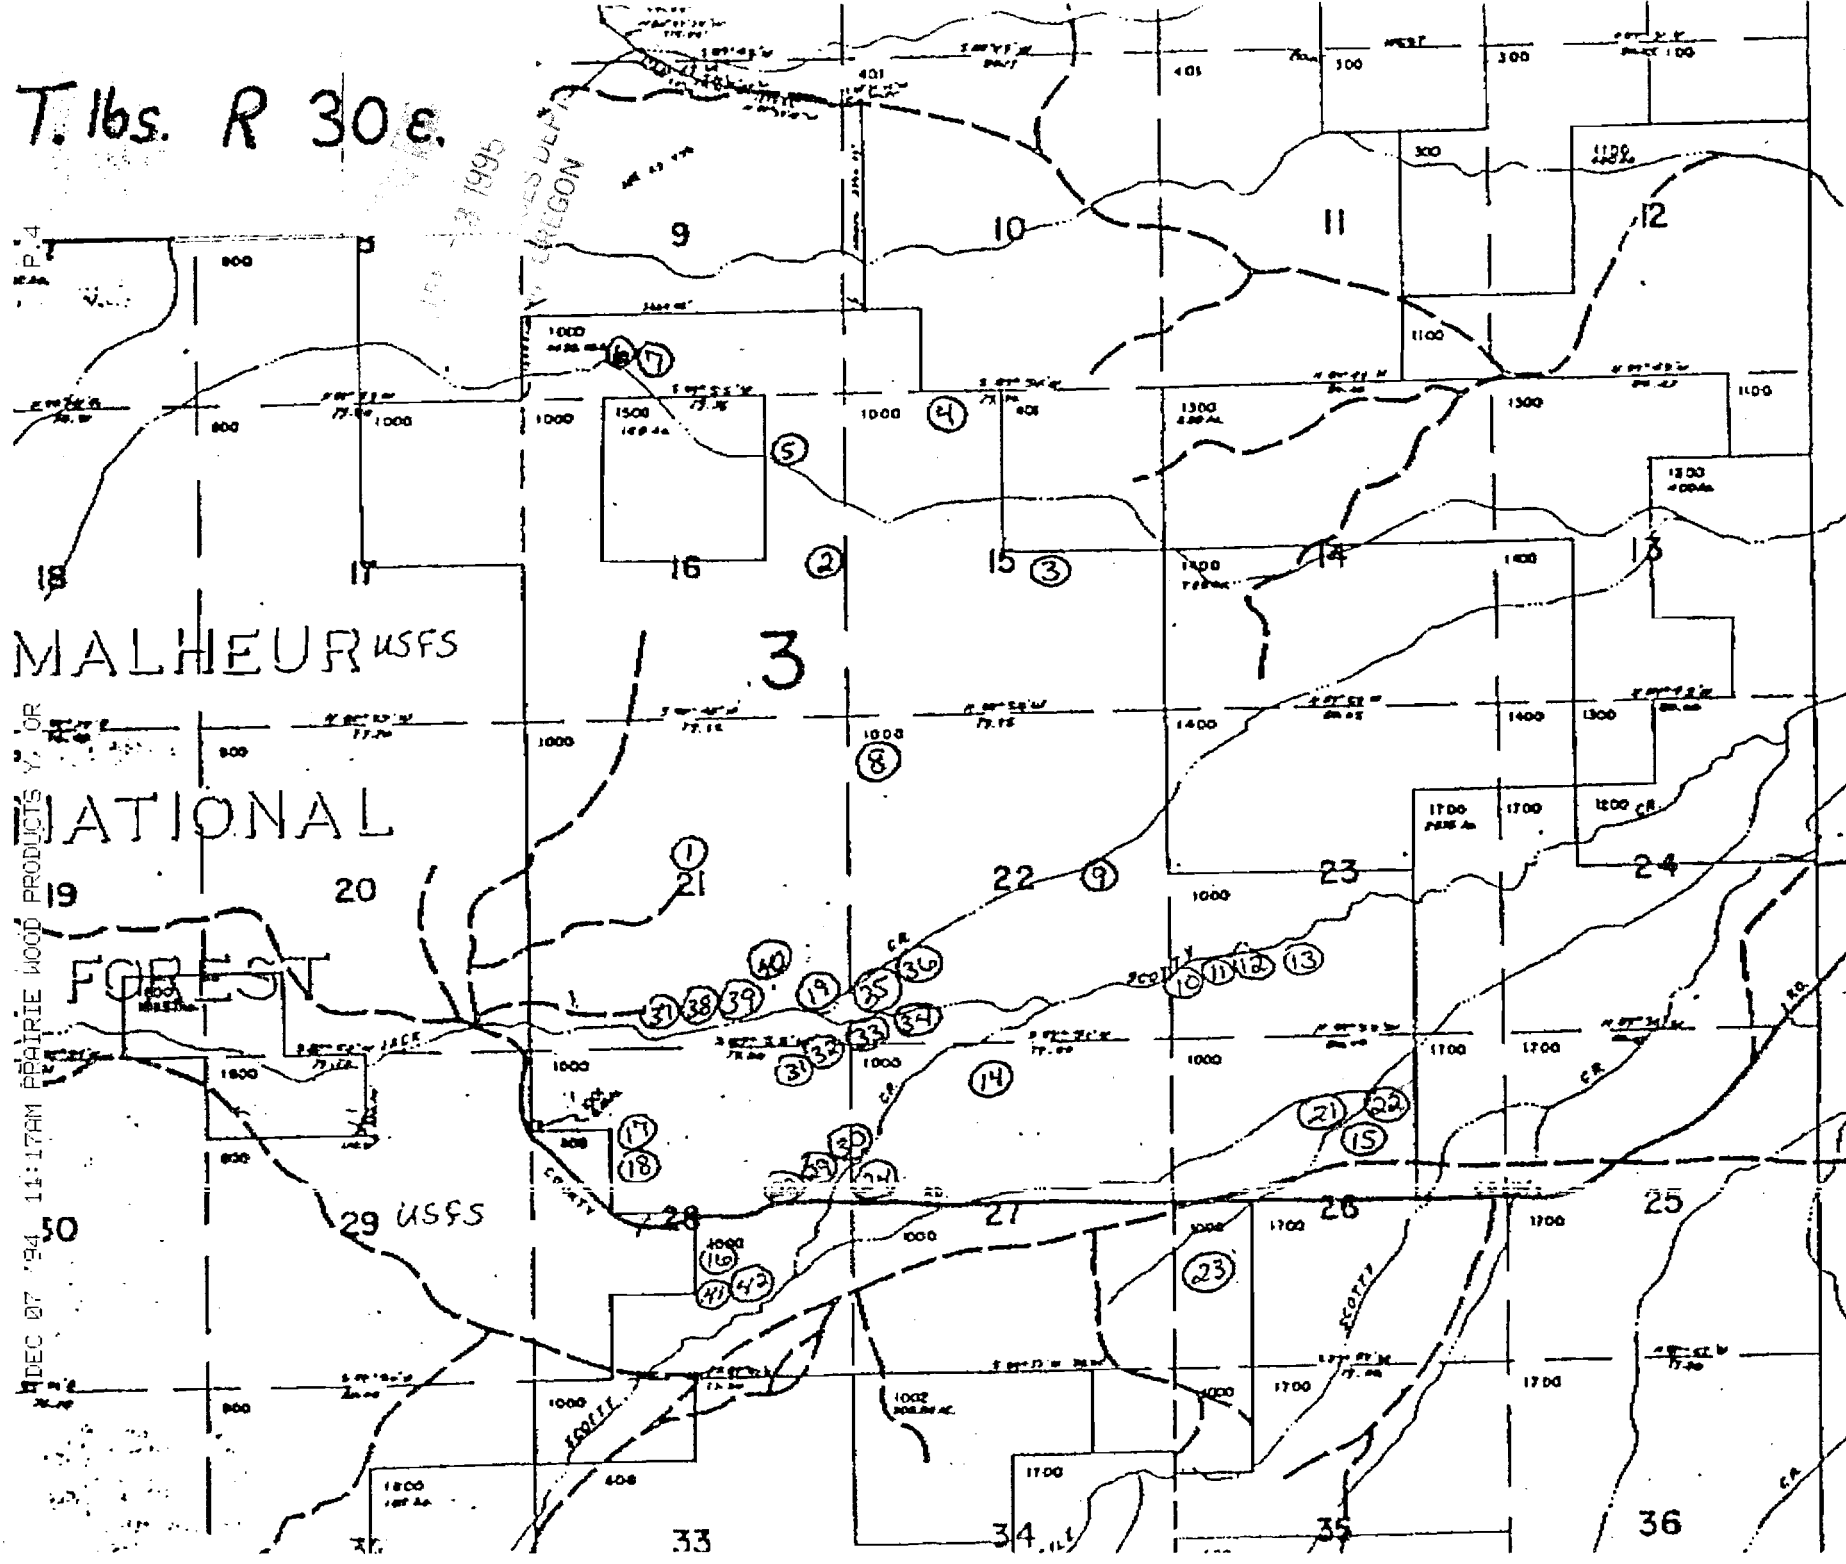

Application No. R-70890
Permit No. 70890

DEC 07 '94 11:17AM
PEOPLE WOOD PRODUCTS Y. OR

SEE MAP IS 31

No Final Proof Map available

No Permit Map available