

Per 7169

7536
7080

Map of
Carter Ditch
T. 10 South, R. 31 E. W. M.


Benton Carter
Appropriator

Scale 8 inch = 1 mile

STATE ENGINEER
RECEIVED

FEB 17 1926

SALEM OREGON

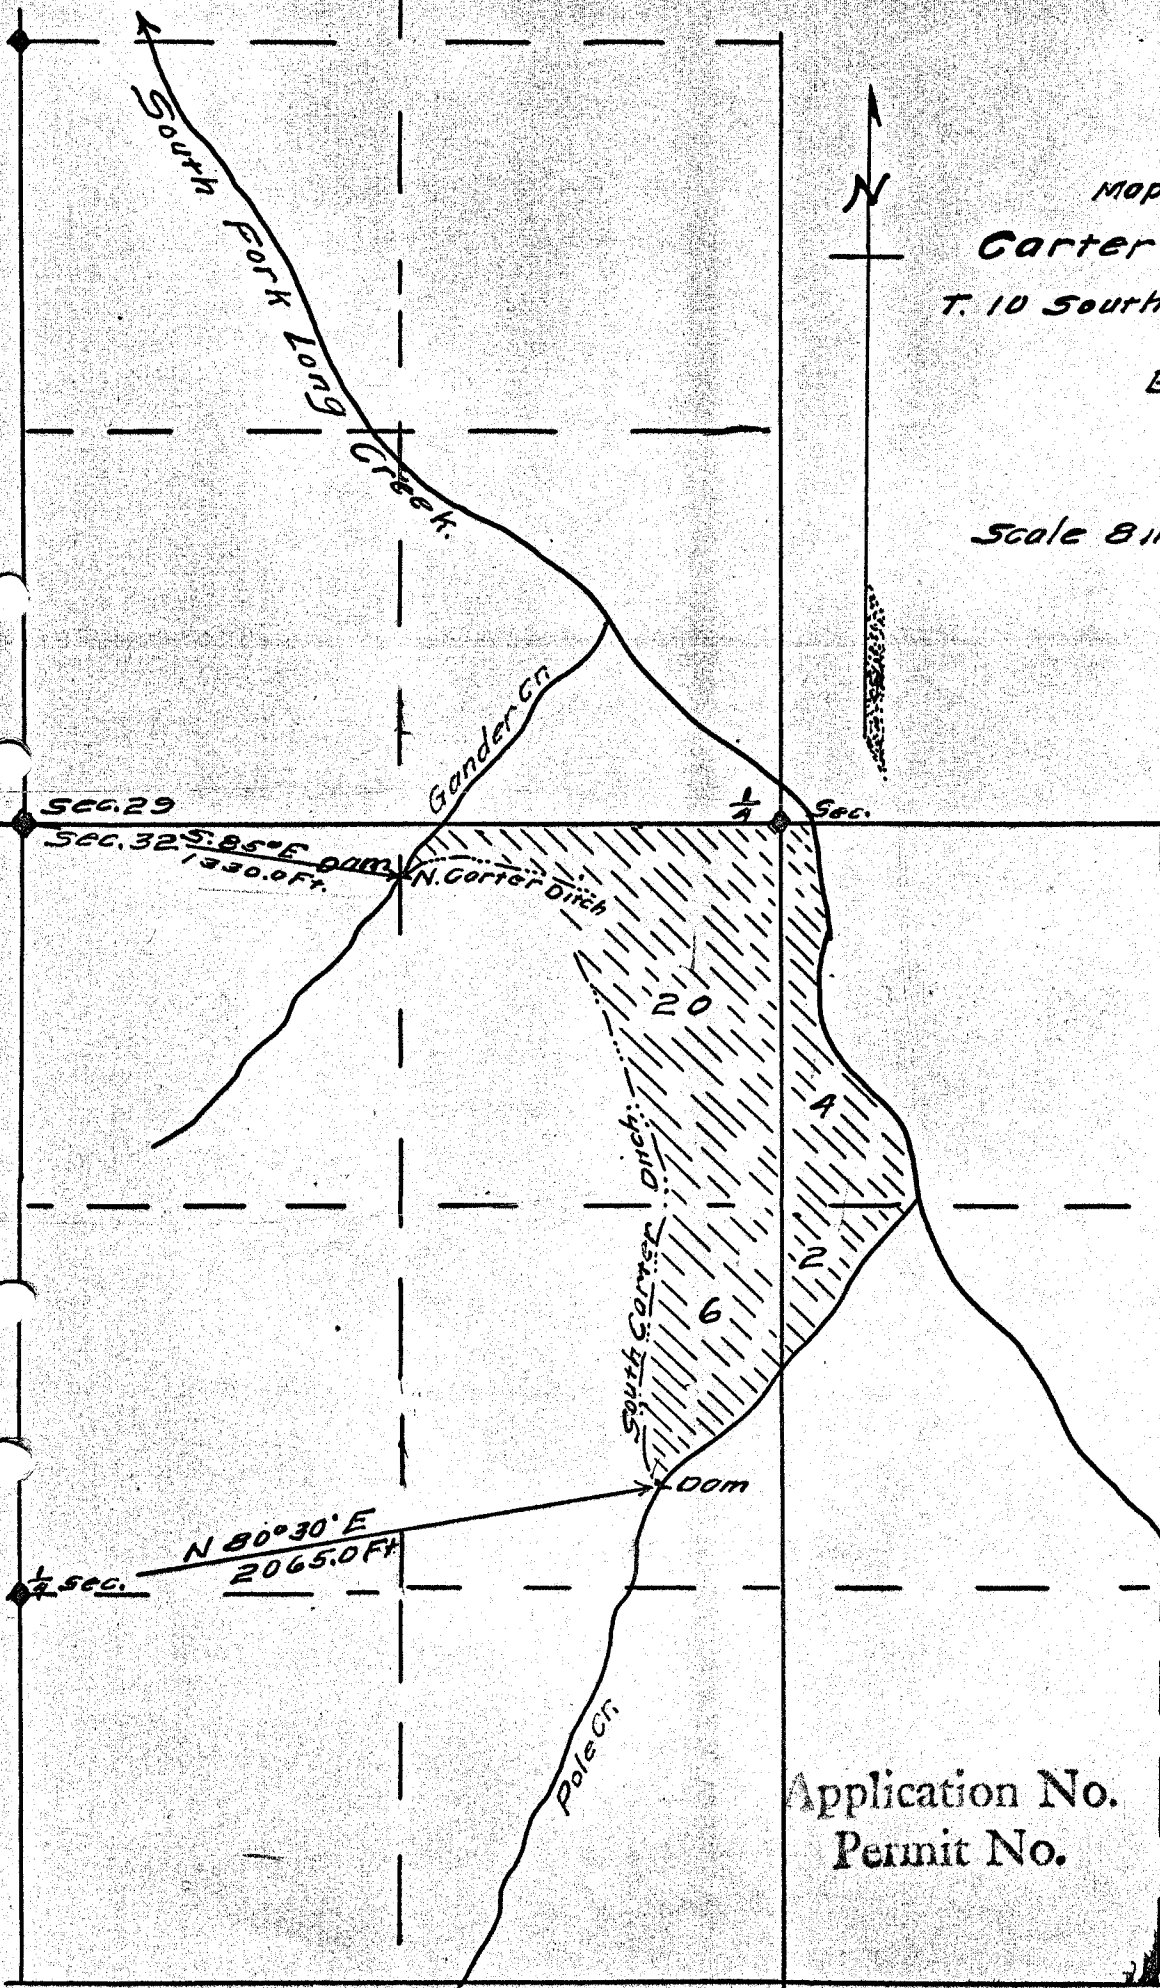

Application No.
Permit No.

10594
7169