


T. 16s. R 30 E.

DEC 07 '94 11:17AM PRAIRIE WOOD PRODUCTS Y. OR

MALHEUR USFS
NATIONAL
FOREST

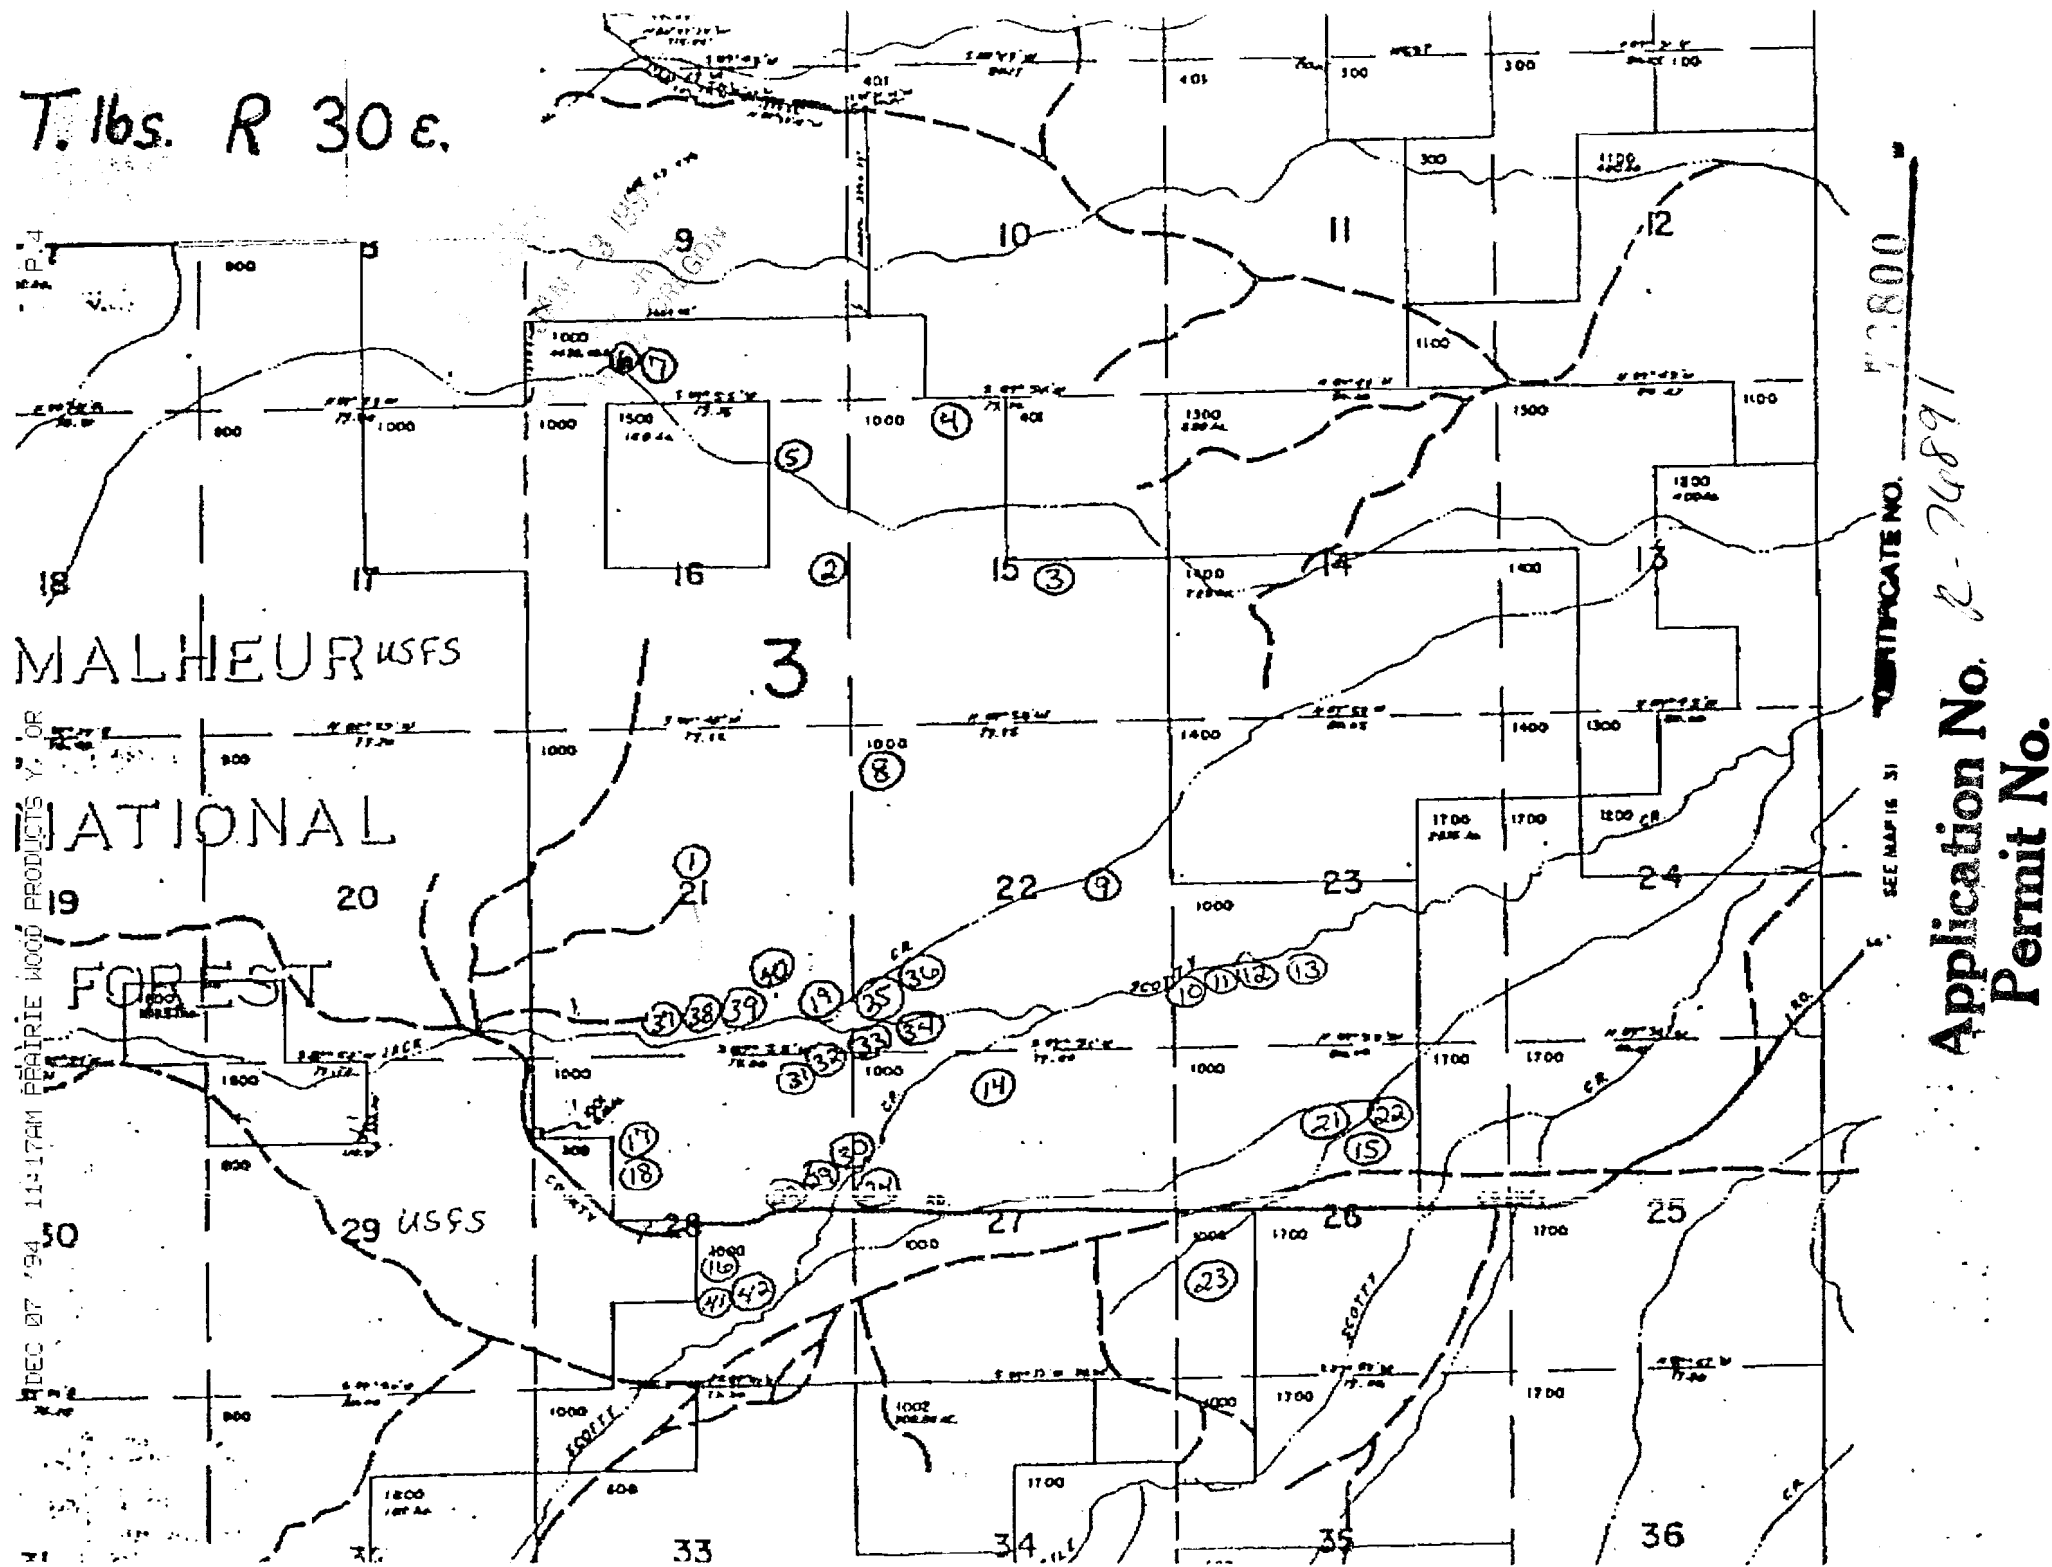

Application No. 8-76891
Permit No.

CERTIFICATE NO. 77800

SEE MAP 16 31

No Final Proof Map available

No Permit Map available