


BERLY

SEC 20 T 29 S R 5 W

53

Application No. R-76893
Permit No. 37802

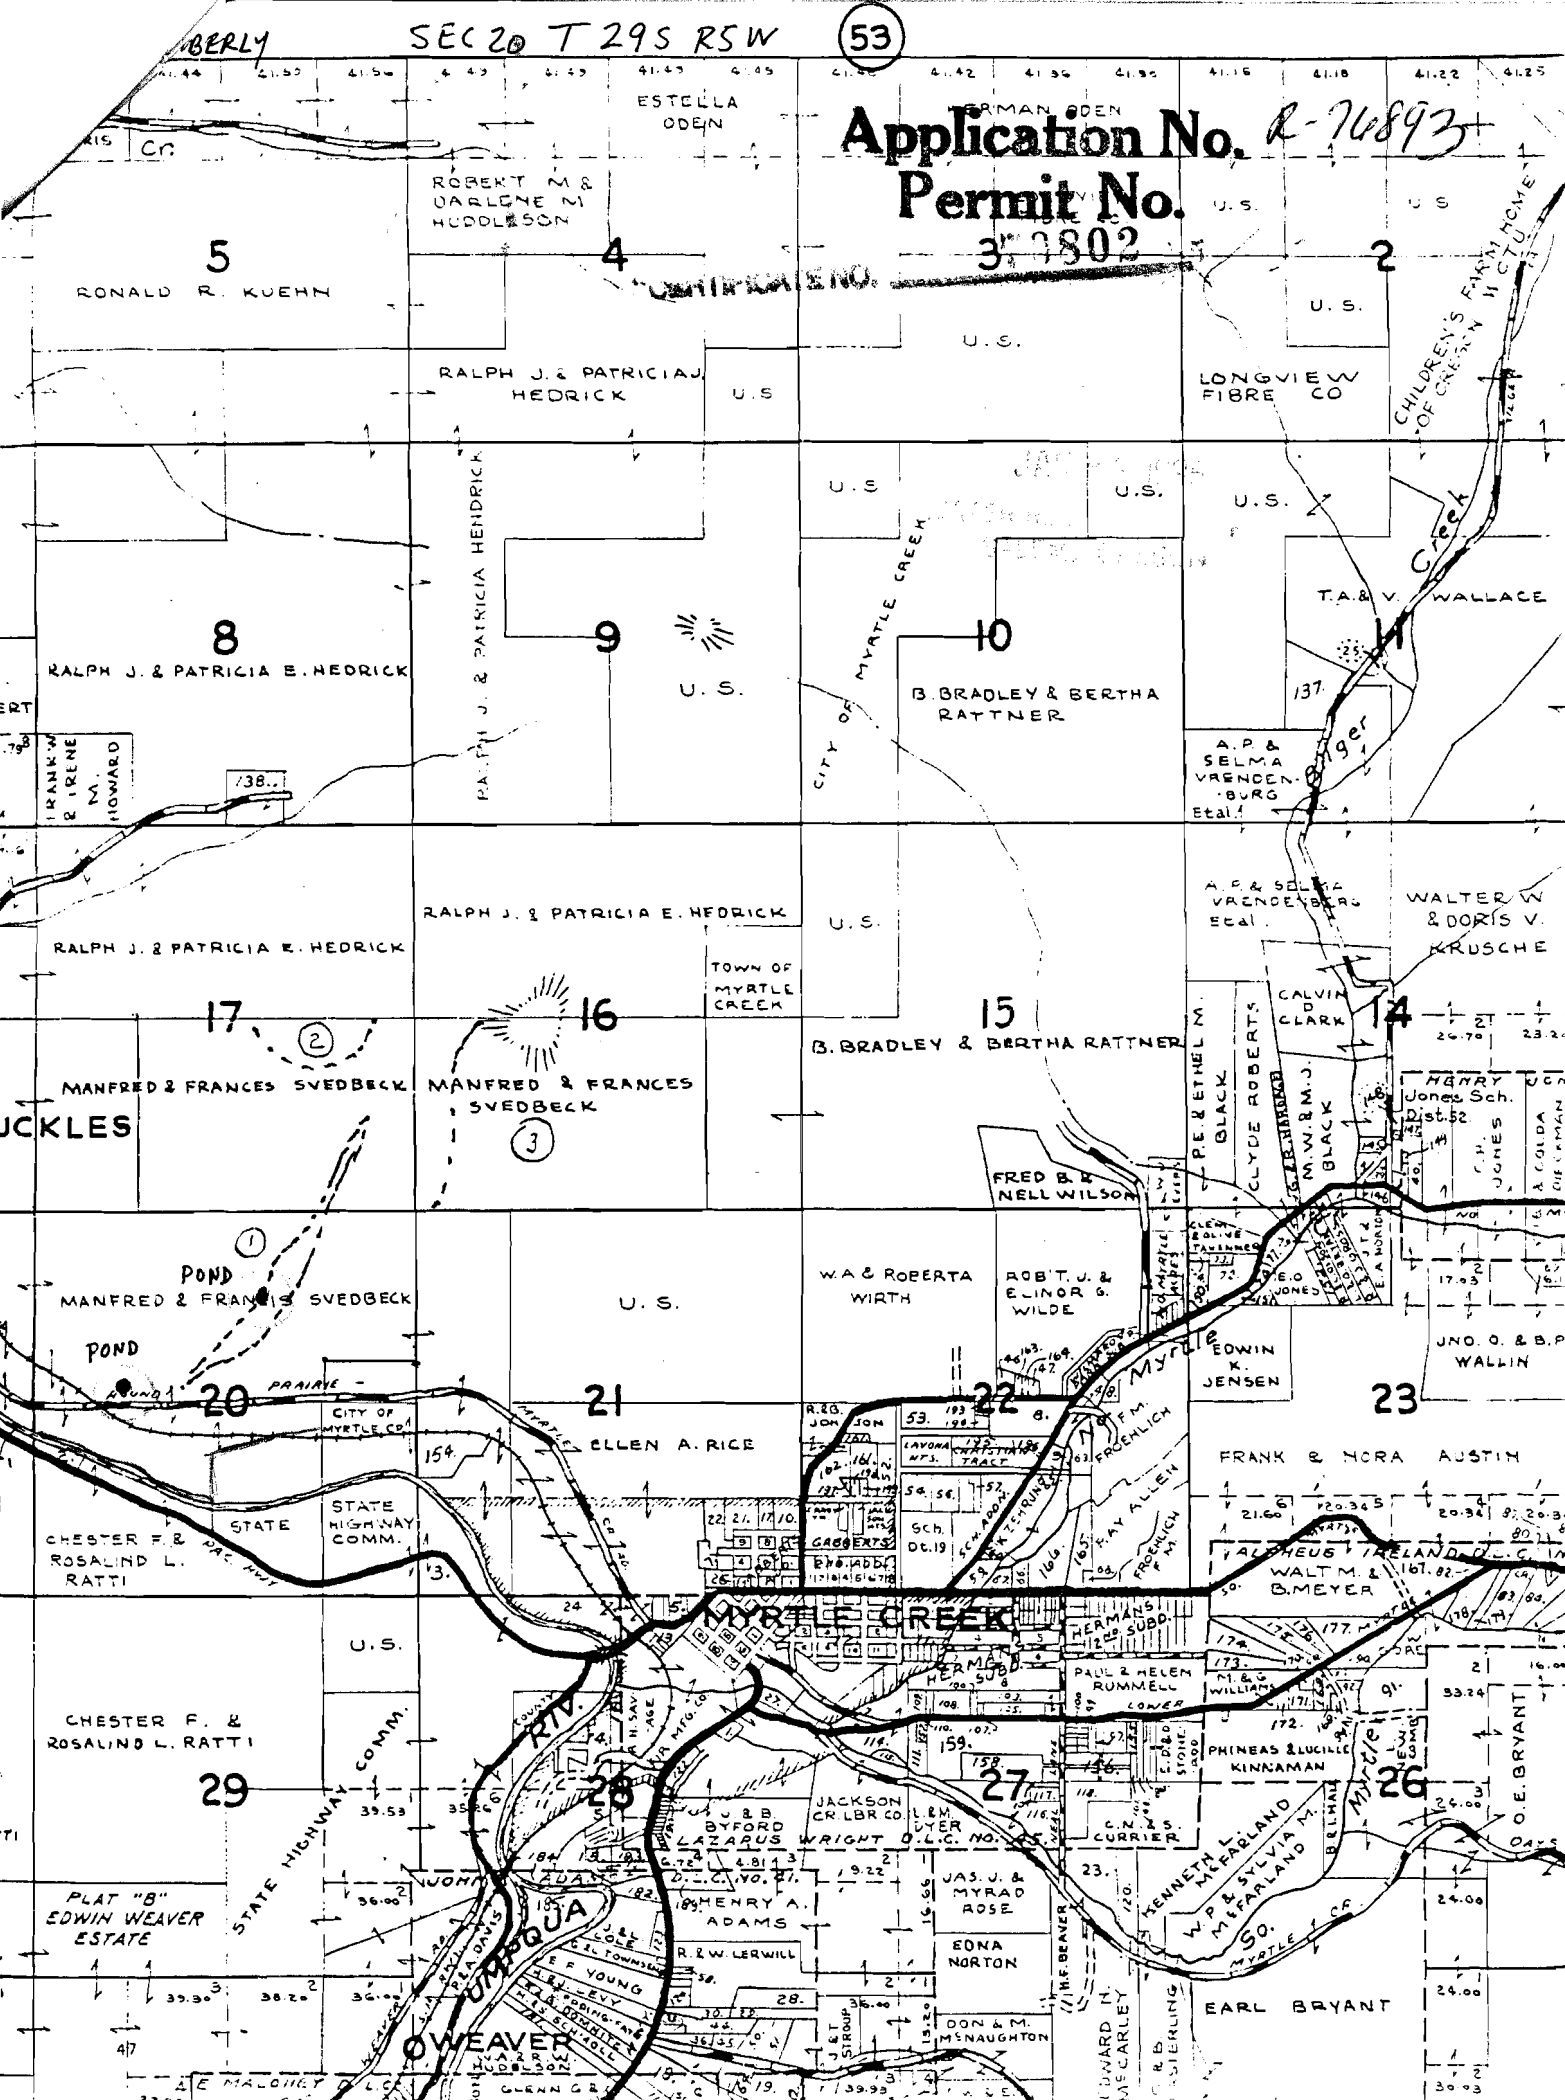

No Final Proof Map available

No Permit Map available