


Application No R-7687
Permit No.

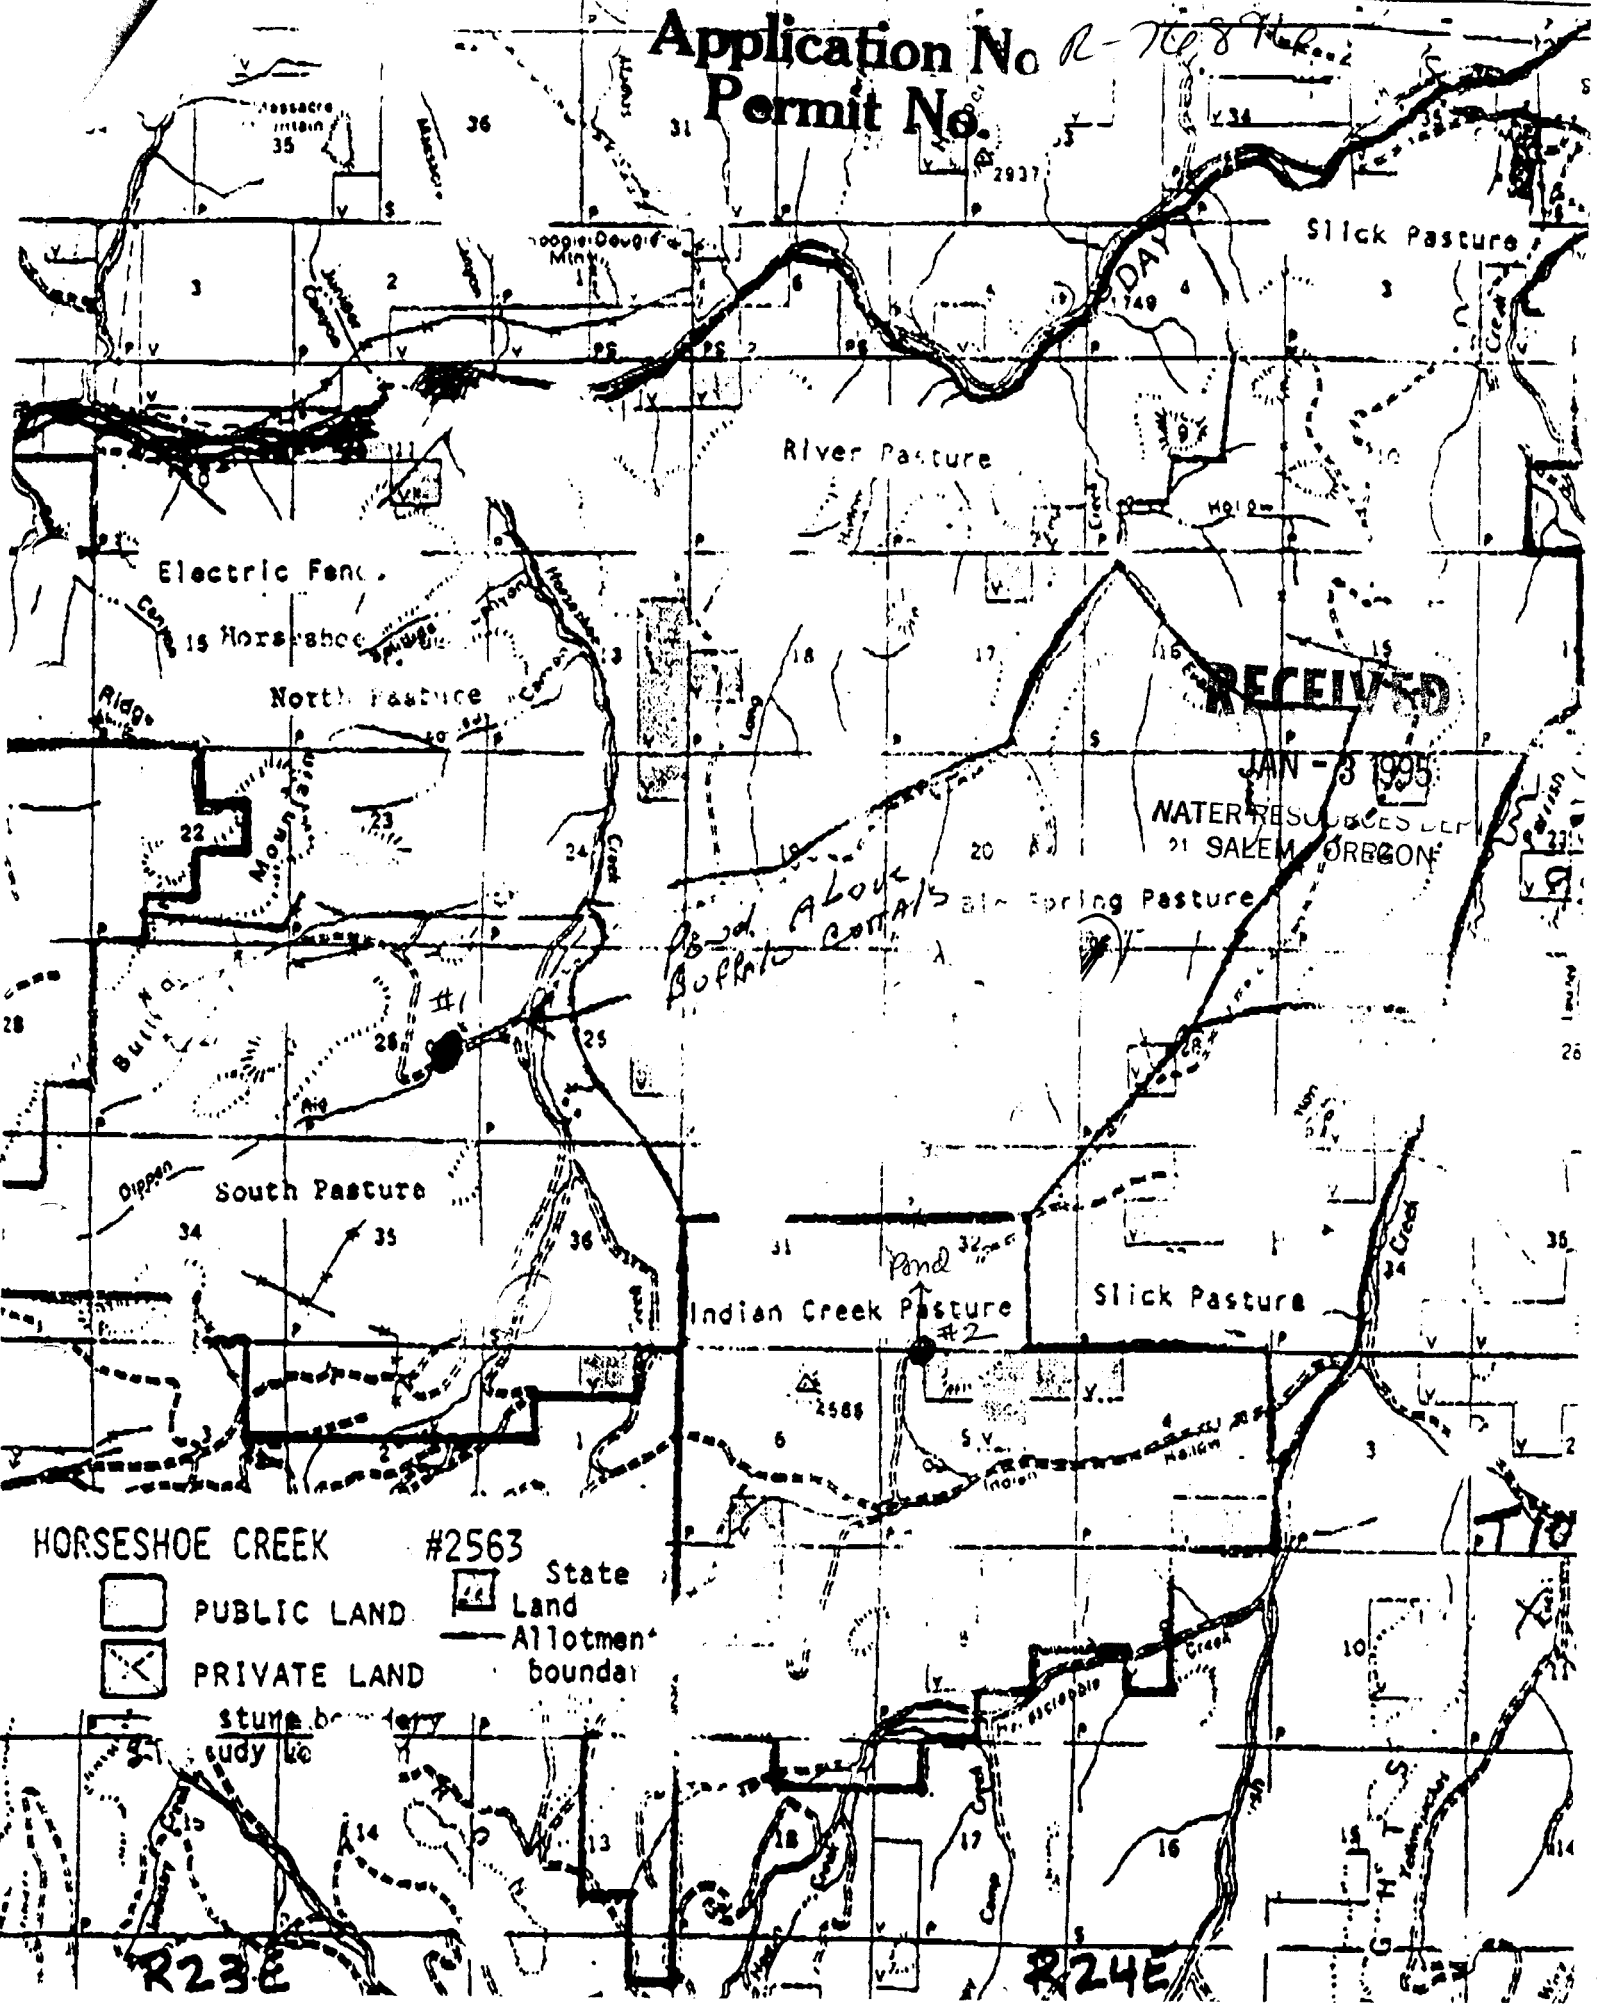

HORSESHOE CREEK #2563

	PUBLIC LAND		State Land
	PRIVATE LAND		Allotment boundary

stump boundary
study line

R23E

R24E