


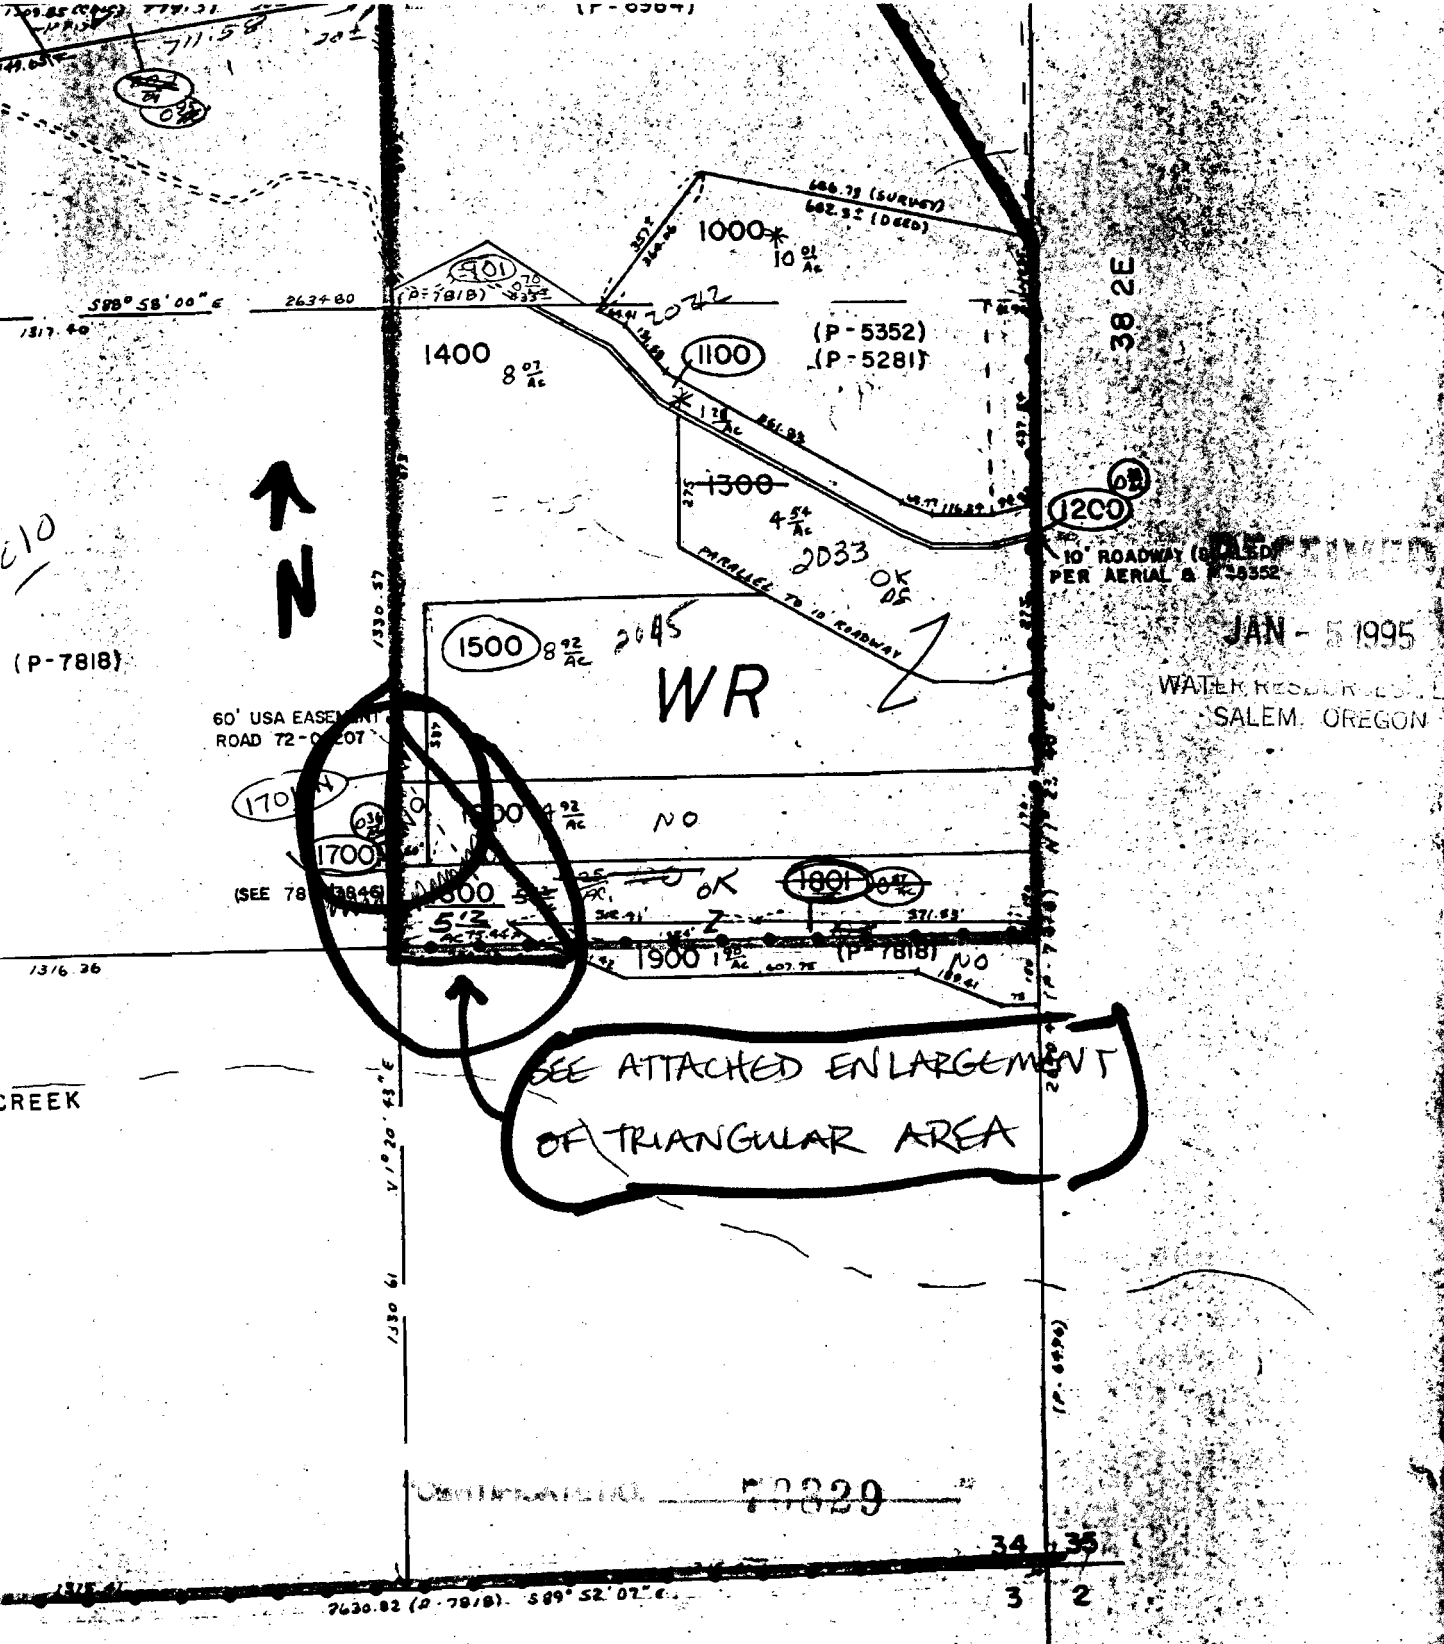

Application No. R-76920
Permit No.

No Final Proof Map available

No Permit Map available