

UNITED STATES
DEPARTMENT OF THE INTERIOR
GEOLOGICAL SURVEY

JOHN L. WILSON
DEBORAH K. WITHROW
HB 2153


119° 45'
44° 52' 30"


804000m


285

42° 30'

287

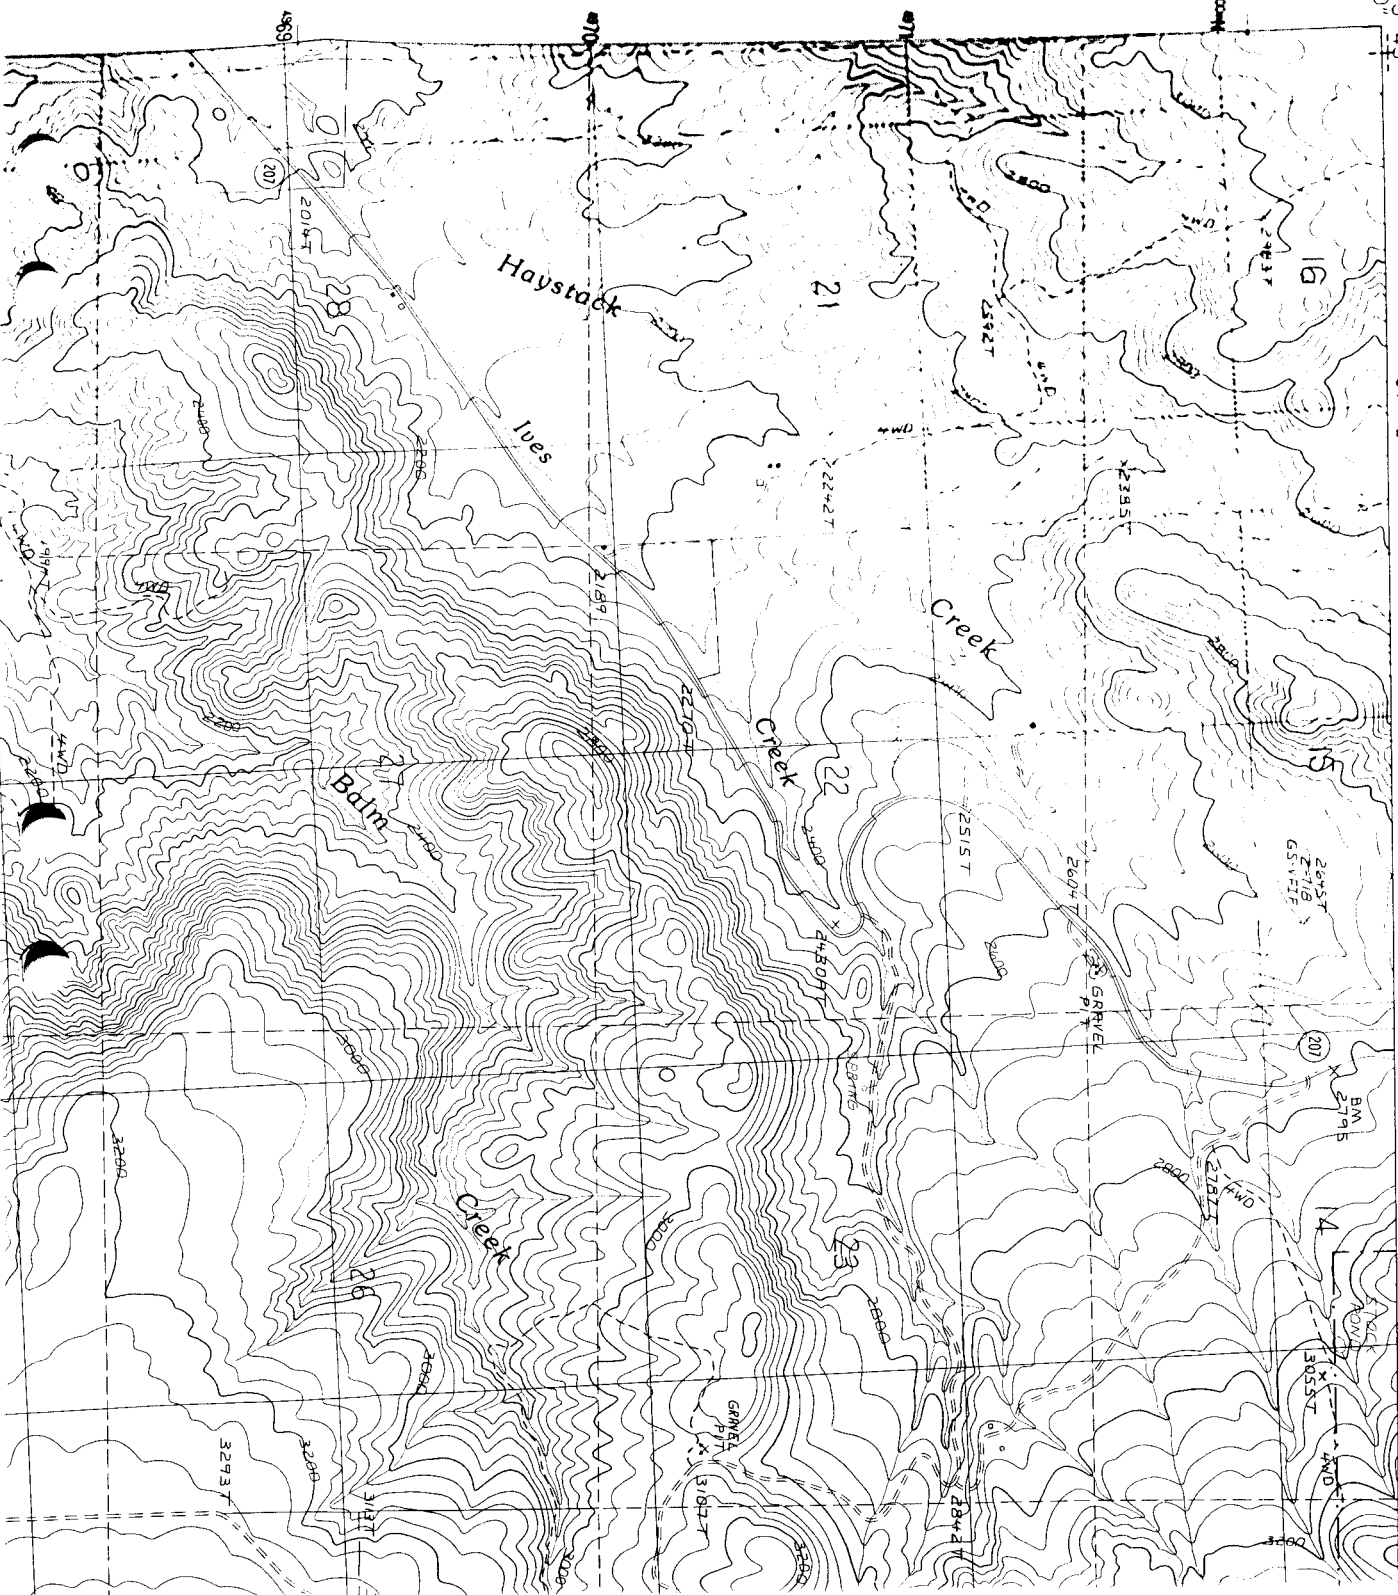

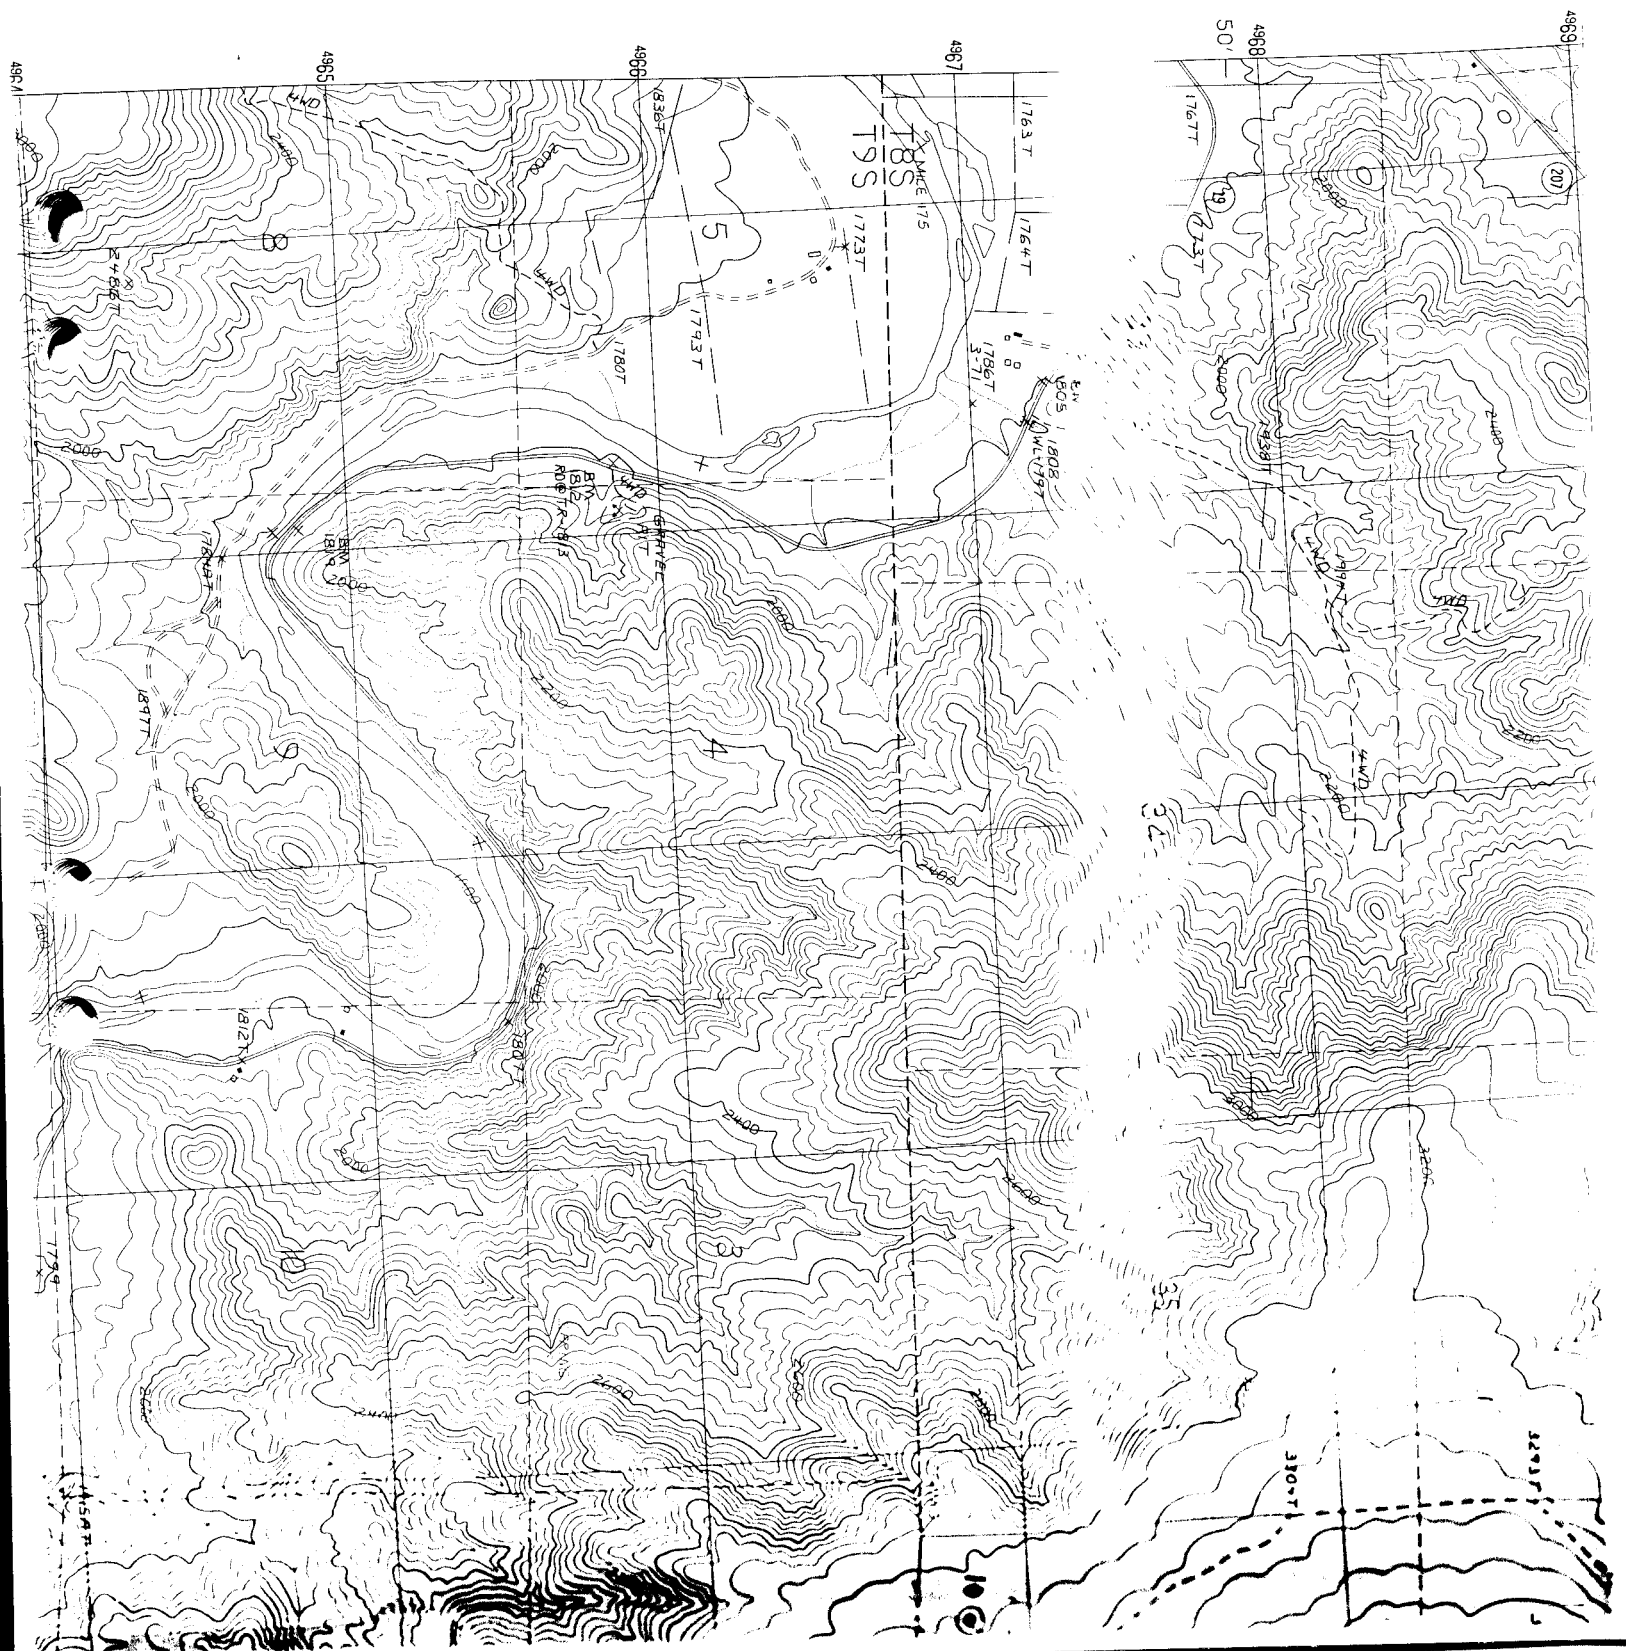

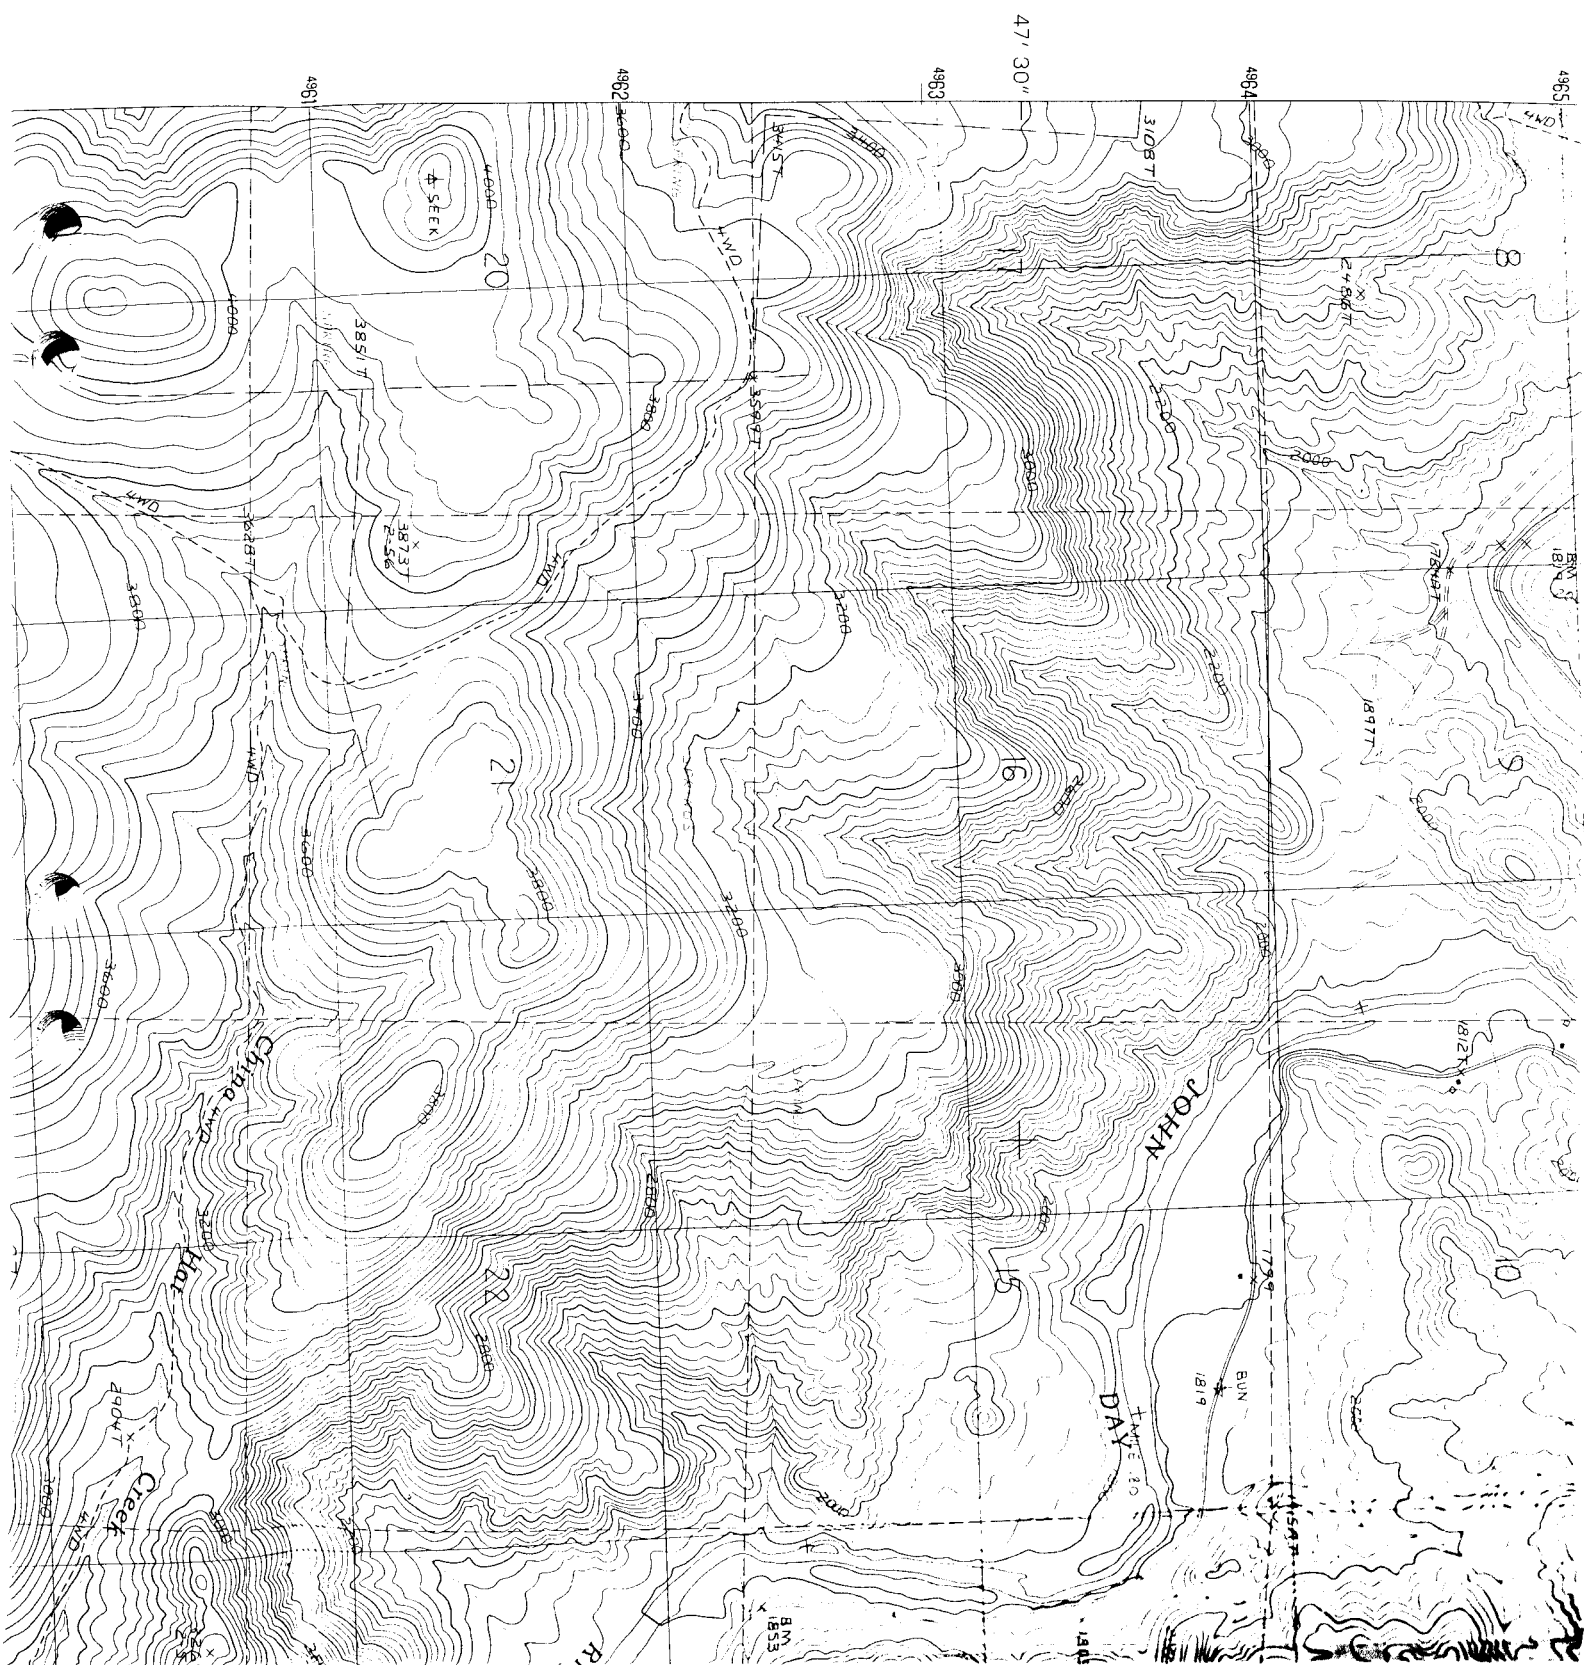


KIMBERLY QUADRANGLE
OREGON
7.5 MINUTE SERIES (TOPOGRAPHIC)


RECEIVED


JAN - 4 1995


WALTON
SALEM, OREGON

Application No. 8-76924
Permit No. 70333

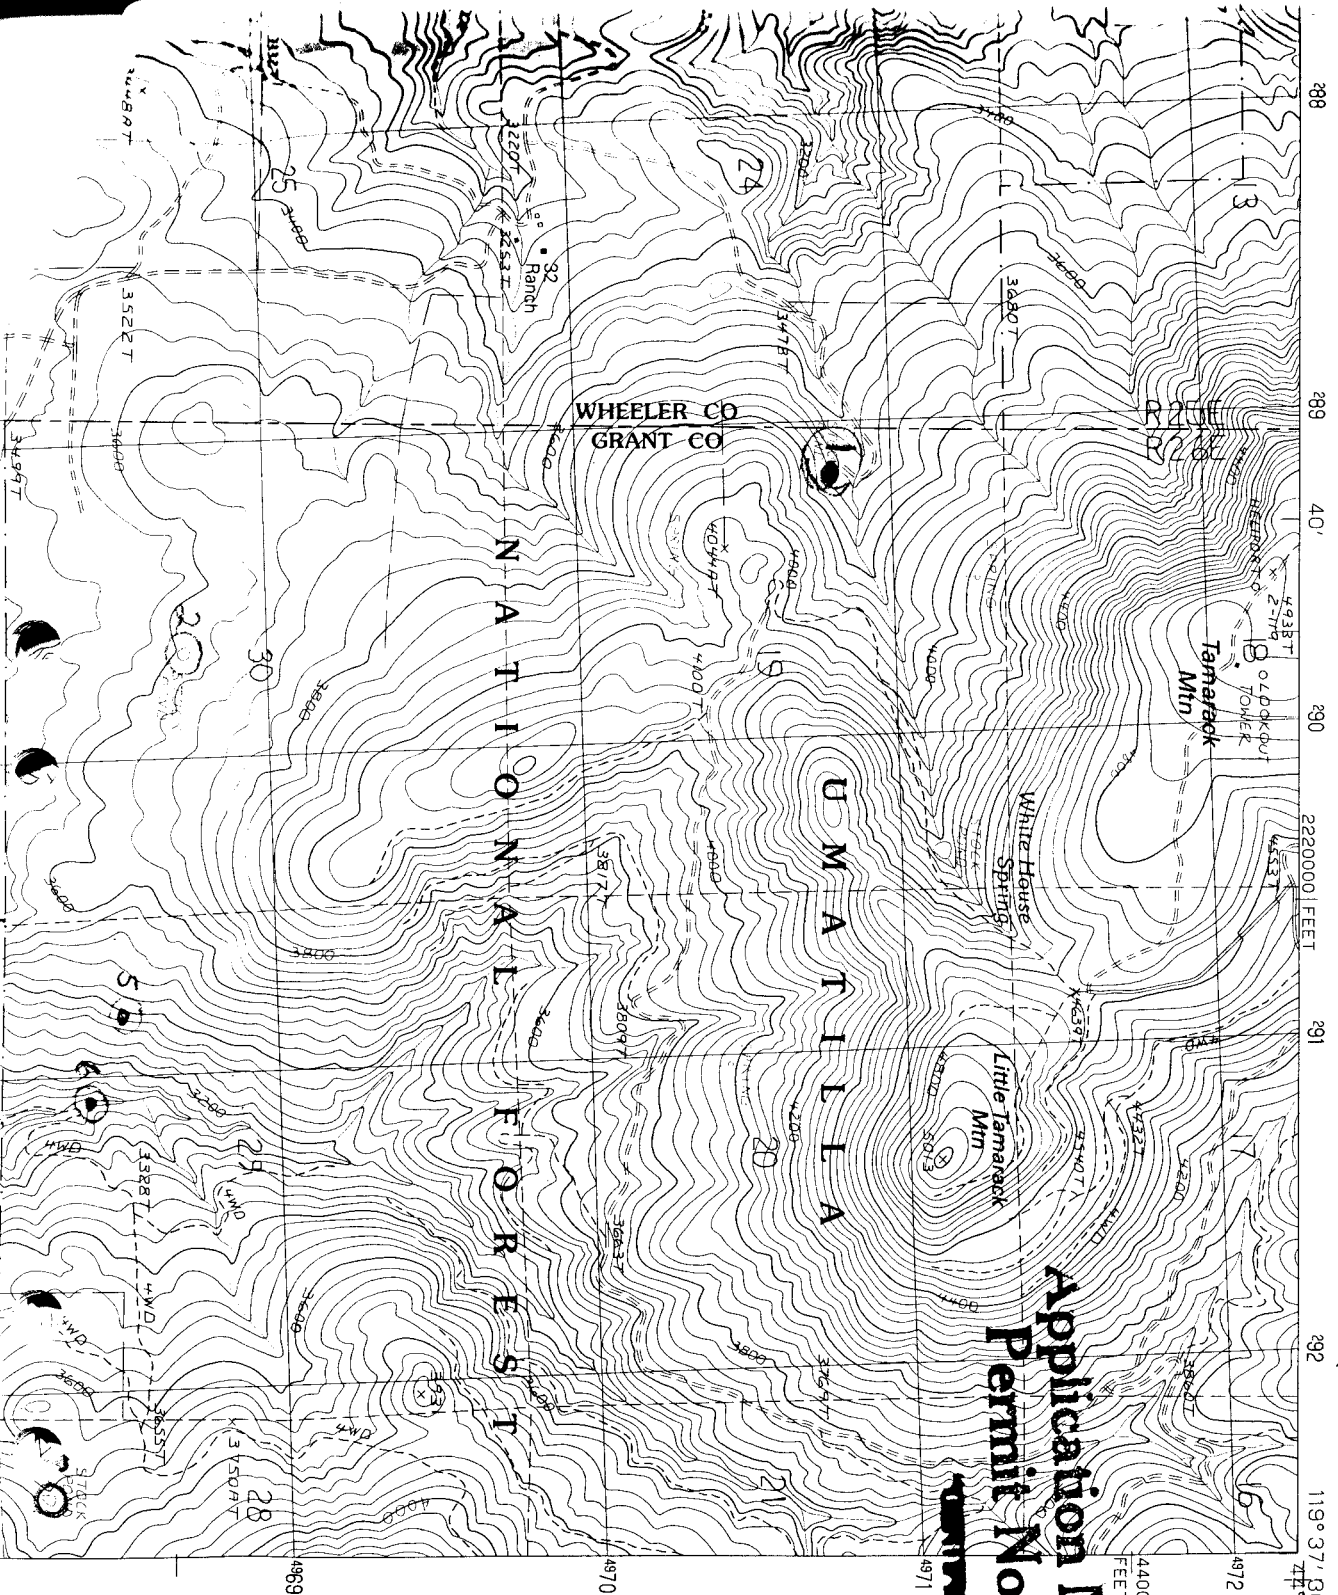

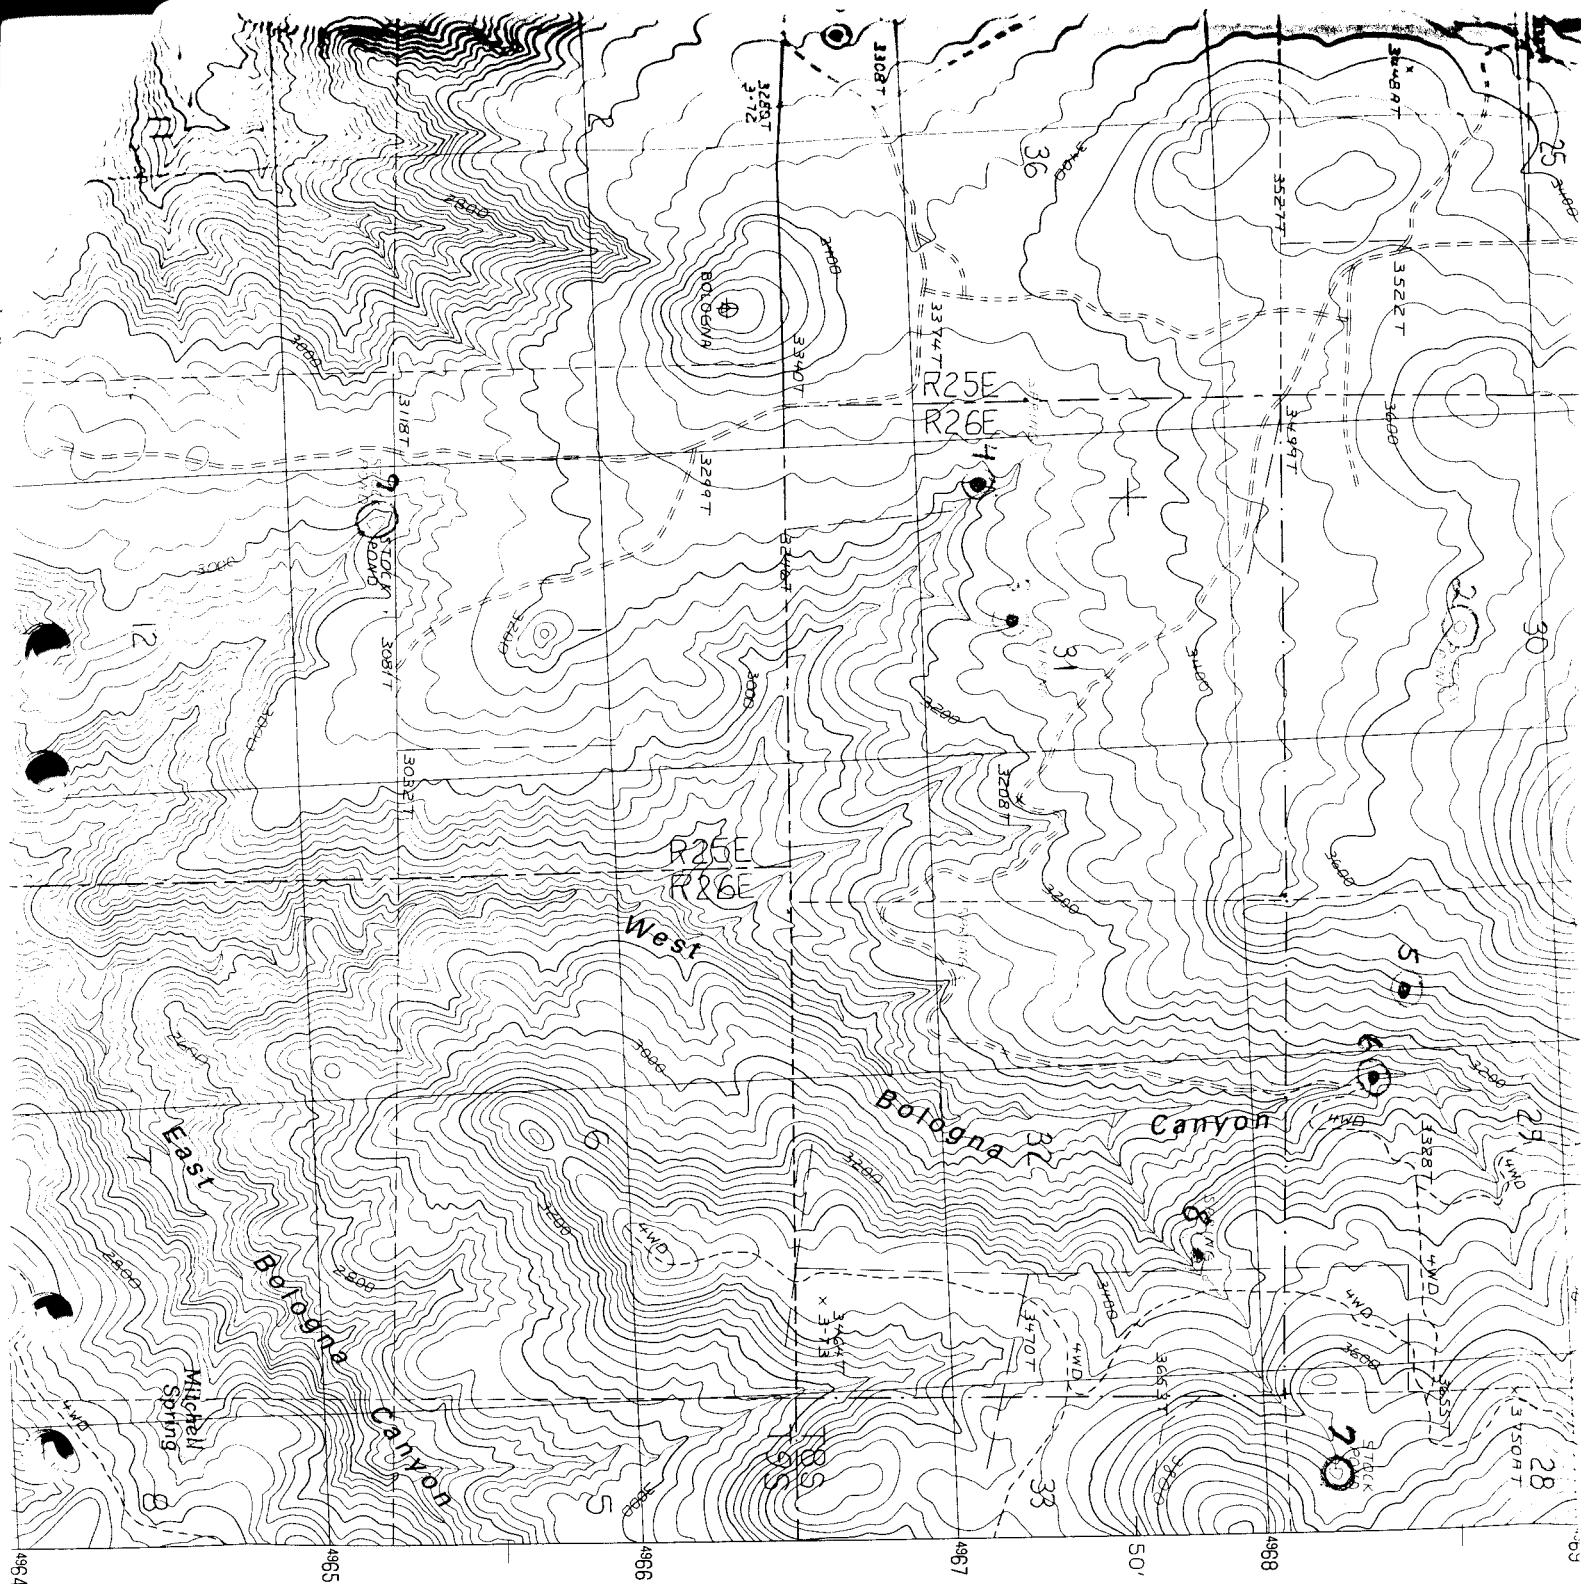

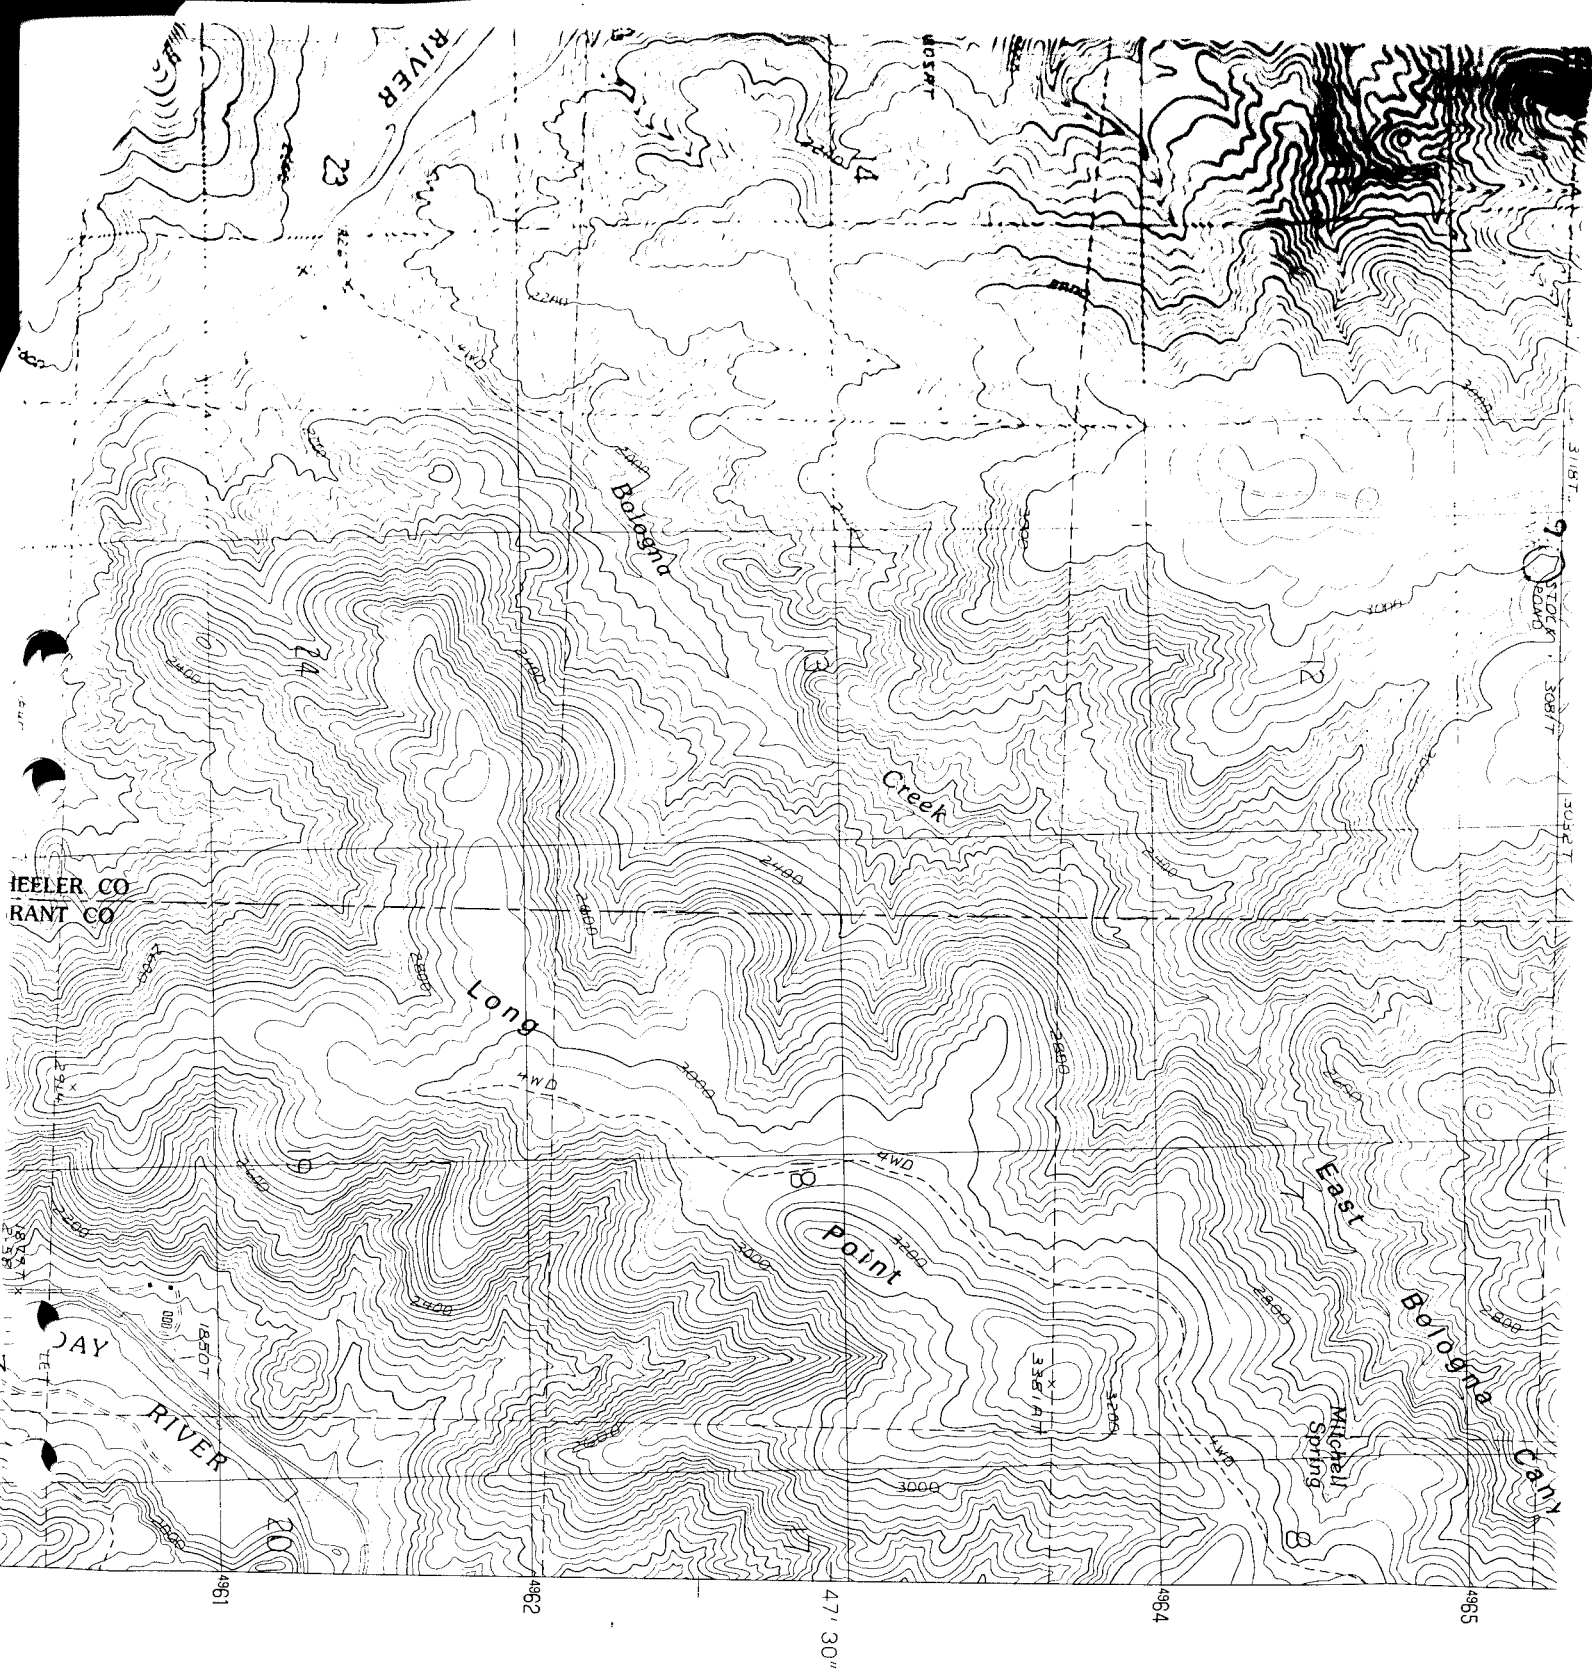

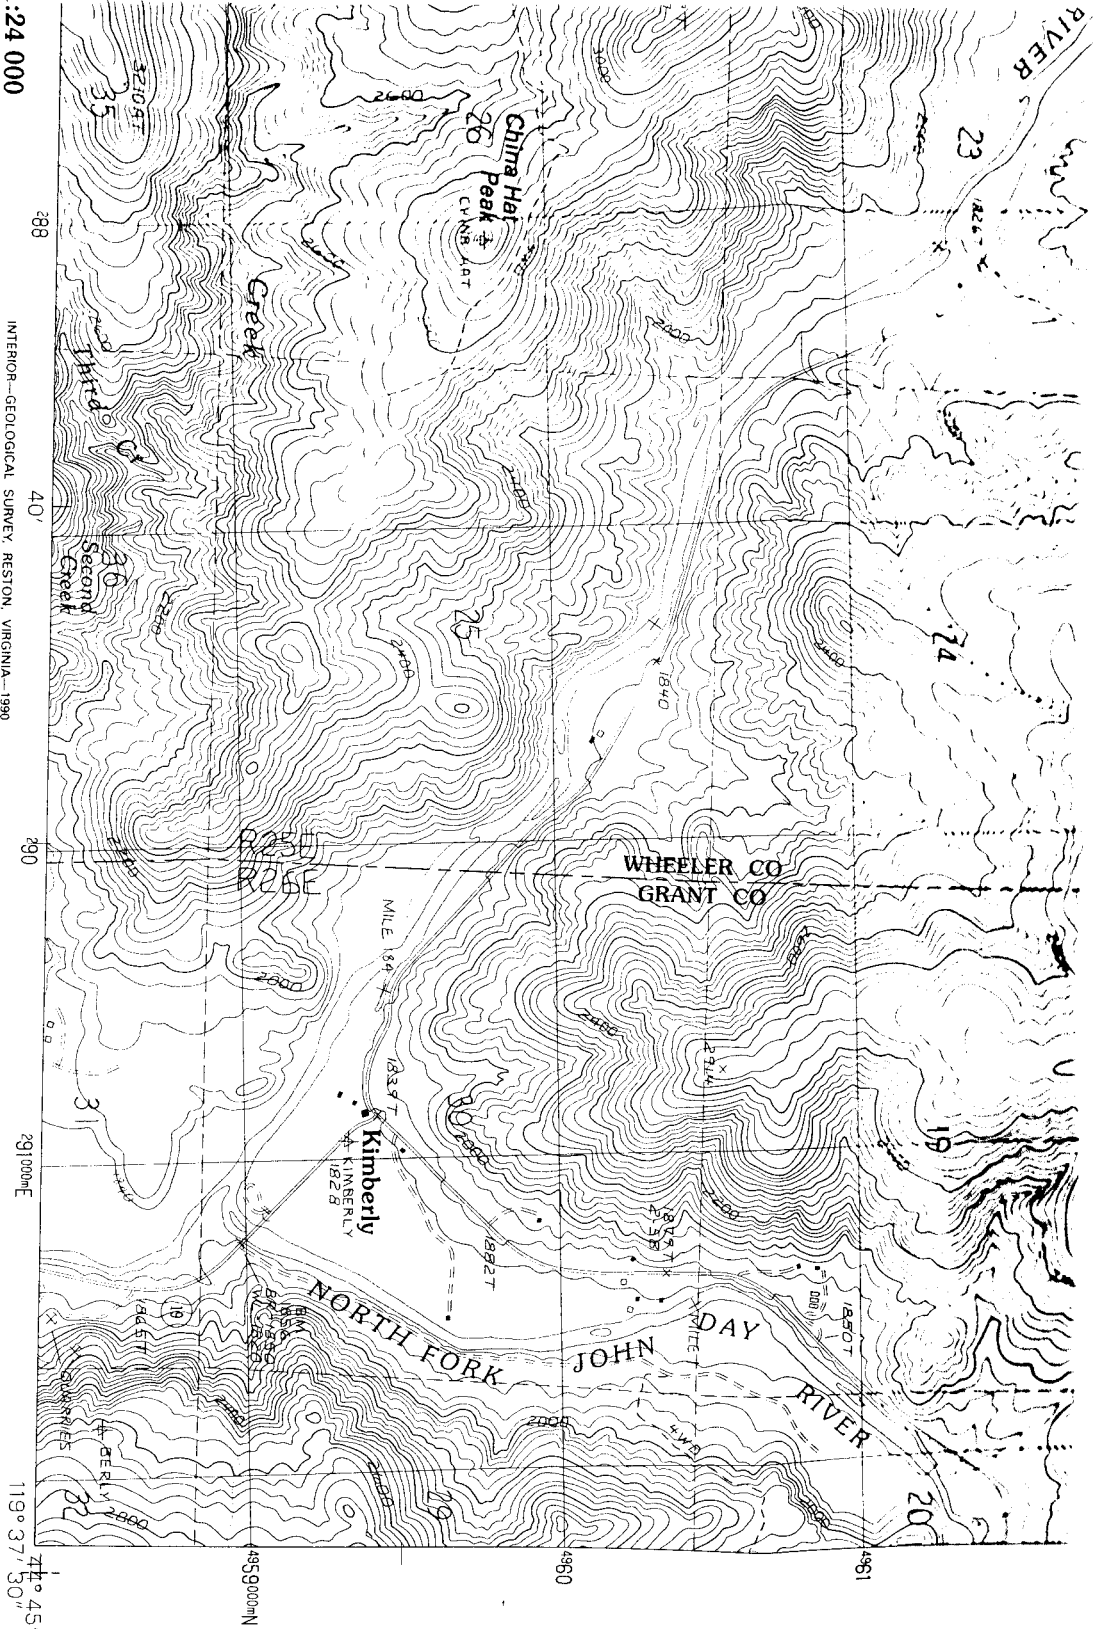


24 000
INTERIOR GEOLOGICAL SURVEY RESTON, VIRGINIA-1990

TERS
RS 1 2
1000 2000

5000 6000 7000 8000 9000 10 000

RVAL 40 FEET

QUADRANGLE LOCATION

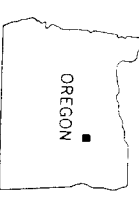


ACCURACY STANDARDS
SURVEY
TINIA 22092

ROAD LEGEND

Improved Road
Unimproved Road
Trail

Interstate Route U. S. Route State Route

KIMBERLY, OREGON
PROVISIONAL EDITION 1990

44119-G6-TF-024