


map is made solely for the purpose of assisting in  
ing the premises herein described. Western  
near Title of Lane County assumes no liability for  
ations, if any, in dimensions and locations ascer-  
able by actual survey.

Application No. K-76925

Permit No. 10331

*This notice is to certify that  
the water impoundment shown  
on this map was in existence prior  
to January 1st, 1993.*


*Jon P. Humber  
Danda L. Martin*  
IN WITNESS ON JAN. 3, 1995  
SIGNATURE OF JON P. HUBBER  
Danda L. Martin

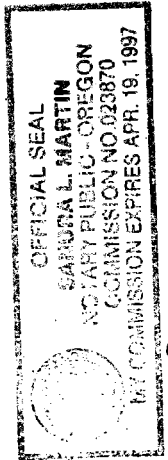

028-02

028-07

028-02

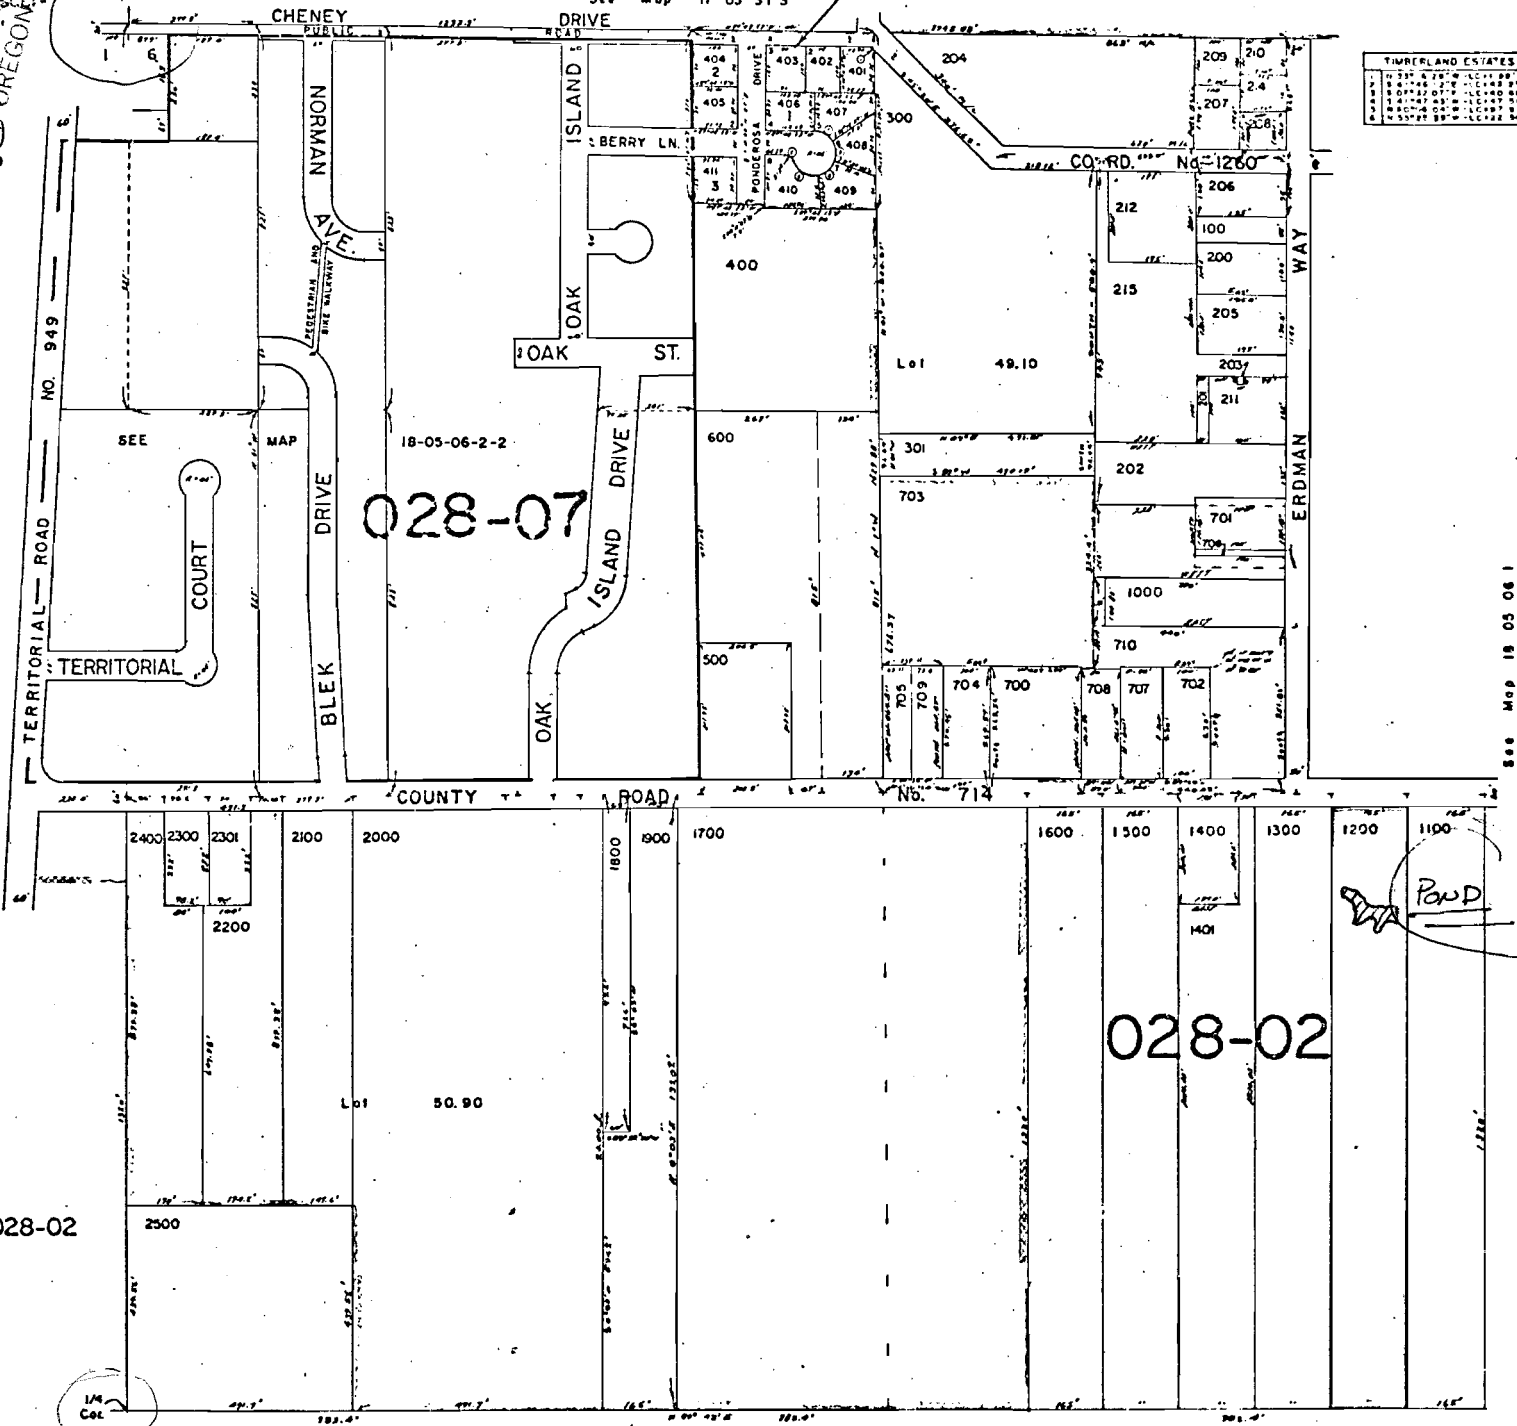

TIMBERLAND ESTATES


See Map 18 05 06 1