
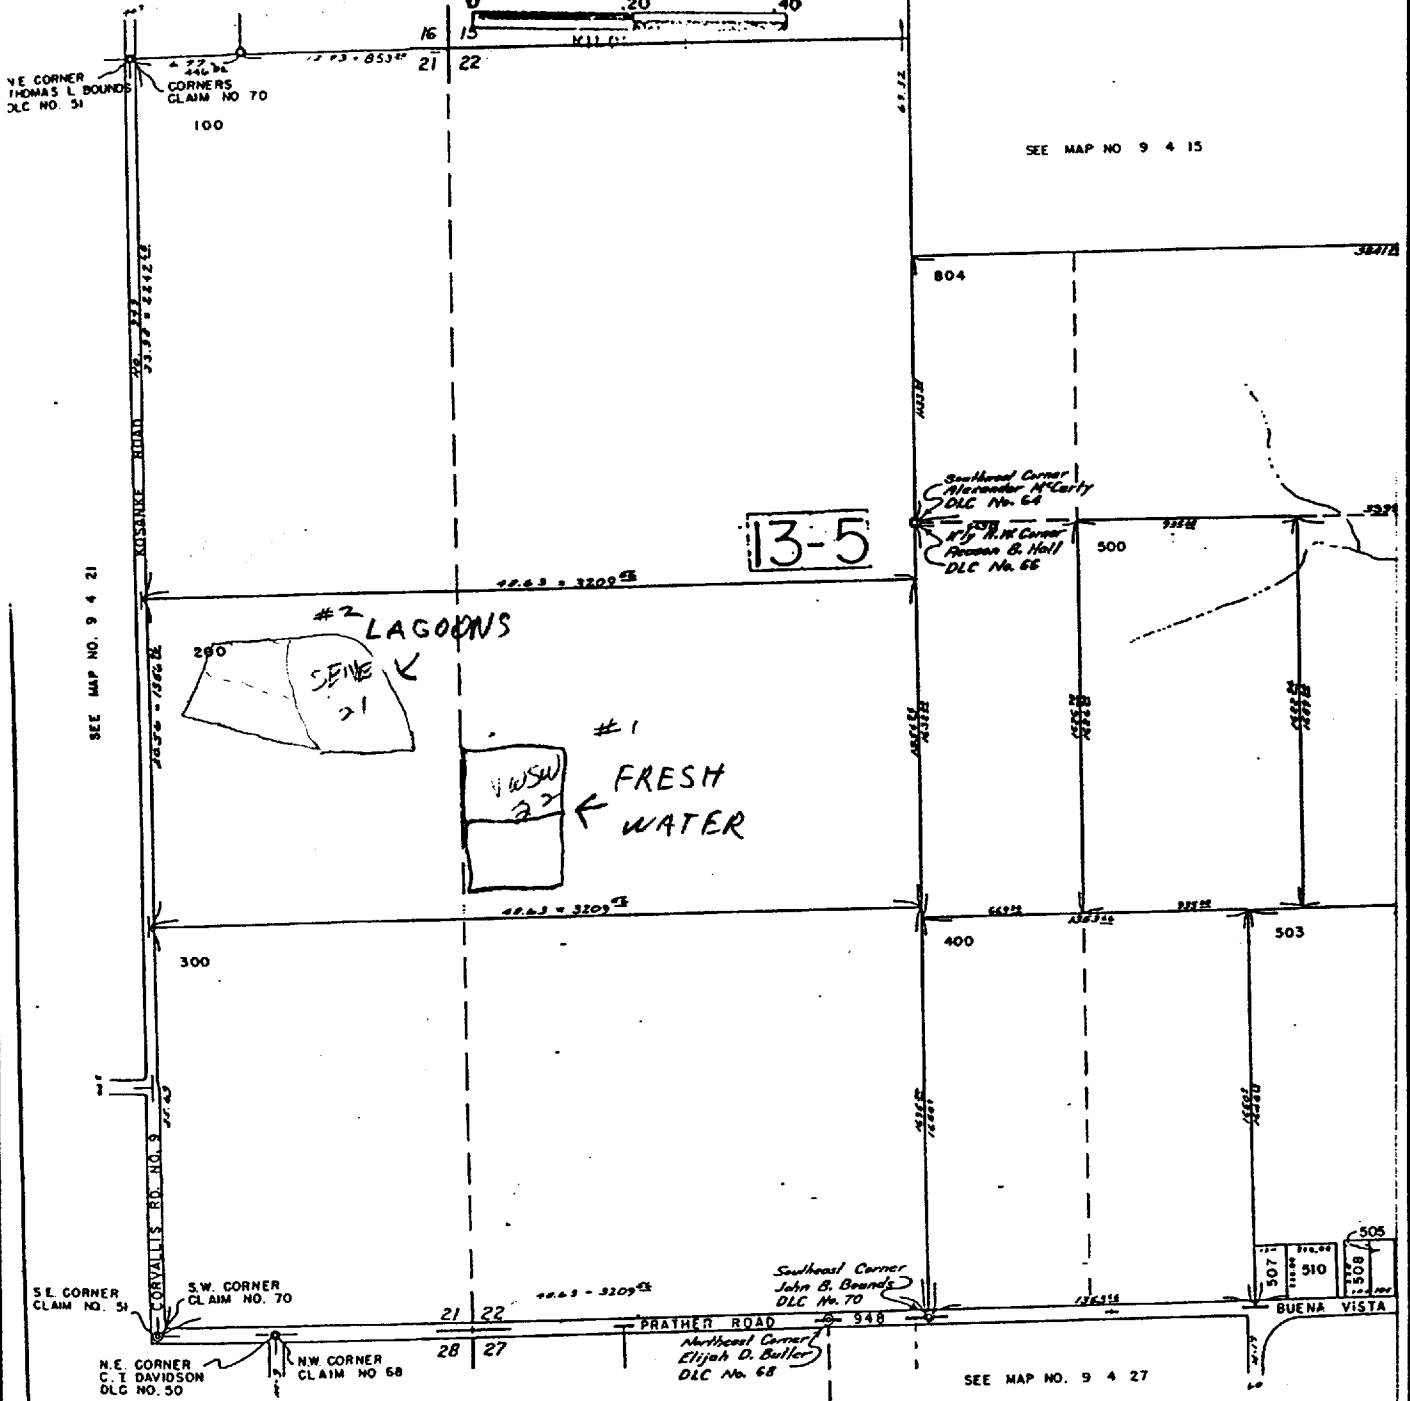


POLK COUNTY

SCALE 1:9600

SCALE 1"=400'

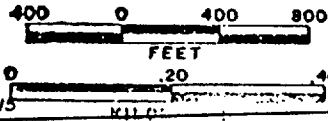

Application No. R-70939
 Permit No.

Plat Map