

HAMPTON FORESTS

TOWNSHIP: 4S7W
 COUNTY: Yamhill

SECTION: 32
 REVISION DATE: 6/92



TYPE#	SPC	STK%	BIRTH	SITE	ACRE
40	DF	69	1928	135	26.8
41	DF	63	1977	135	12.8
42	DF	60	1977	135	9.0
43	DF	55	1977	135	9.0
44	DF	55	1977	135	8.0
45	DF	7	1977	135	4.3
46	RA	90	1977	135	6.4
47	DF	69	1977	135	8.3
RO	RO	0	0	0	14.6
ZP	ZP	0	0	0	178.7

RECEIVED

JAN 3 1995


WATER RESOURCES DEPT.
 SALEM, OREGON

Application No. R-76948
 Permit No.

CERTIFICATE NO. 70856

Total Legal Acres: 640.00

- Primary Hwy
- Rock Road
- Creeks
- Section Lines
- Secondary Hwy
- Dirt Road
- Classl Streams
- Ownership
- Paved Road
- Trail
- Lakes
- Type Lines
- Gate
- Archaeological site

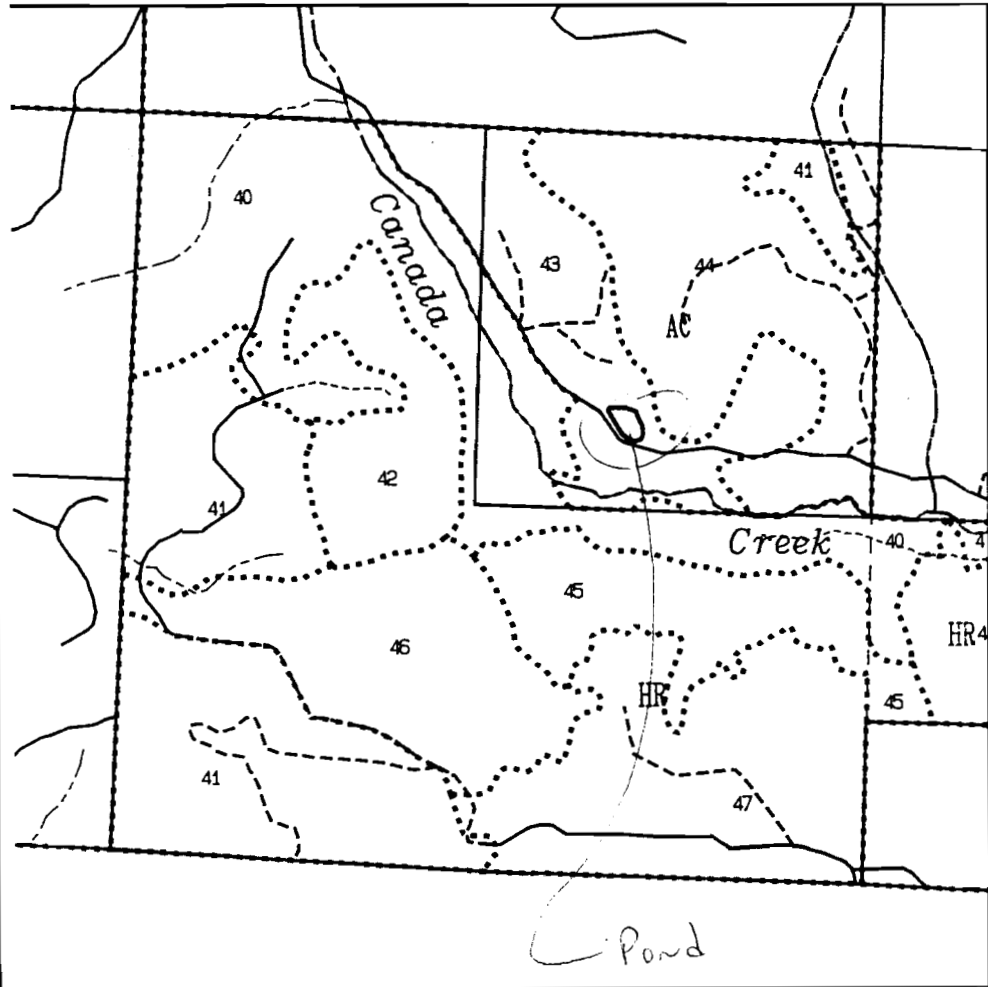

1 Inch = 1000 Feet