

1" = 400'

T. 2 S., R. 4 E
SEC 31

40064

CERTIFICATE NO.

Small
Springs surface on land
behind my property (Lot #28).
More springs surface on
this property (#5) and
created a marshy piece
of land. We scooped out
a space and found the
main springs that forms
the majority of reason for
the marshy - marshy land and
created this small pond
a decade ago.

RECEIVED


JAN 3 1995

WATER RESOURCES DEPT
JAN 3 1995
5101
5702
5502
5301
5802
600
4690
5500
5501
6902
5892
5803
5890
800
5103

PROPERTY UNDER
SURVEY

PRESENT ACRES
15.86 Ac. R-76956
0.92 Ac.
16.78 Ac.

RECALCULATED
16.97 Ac.
So close we
will not change
EAST BY Survey

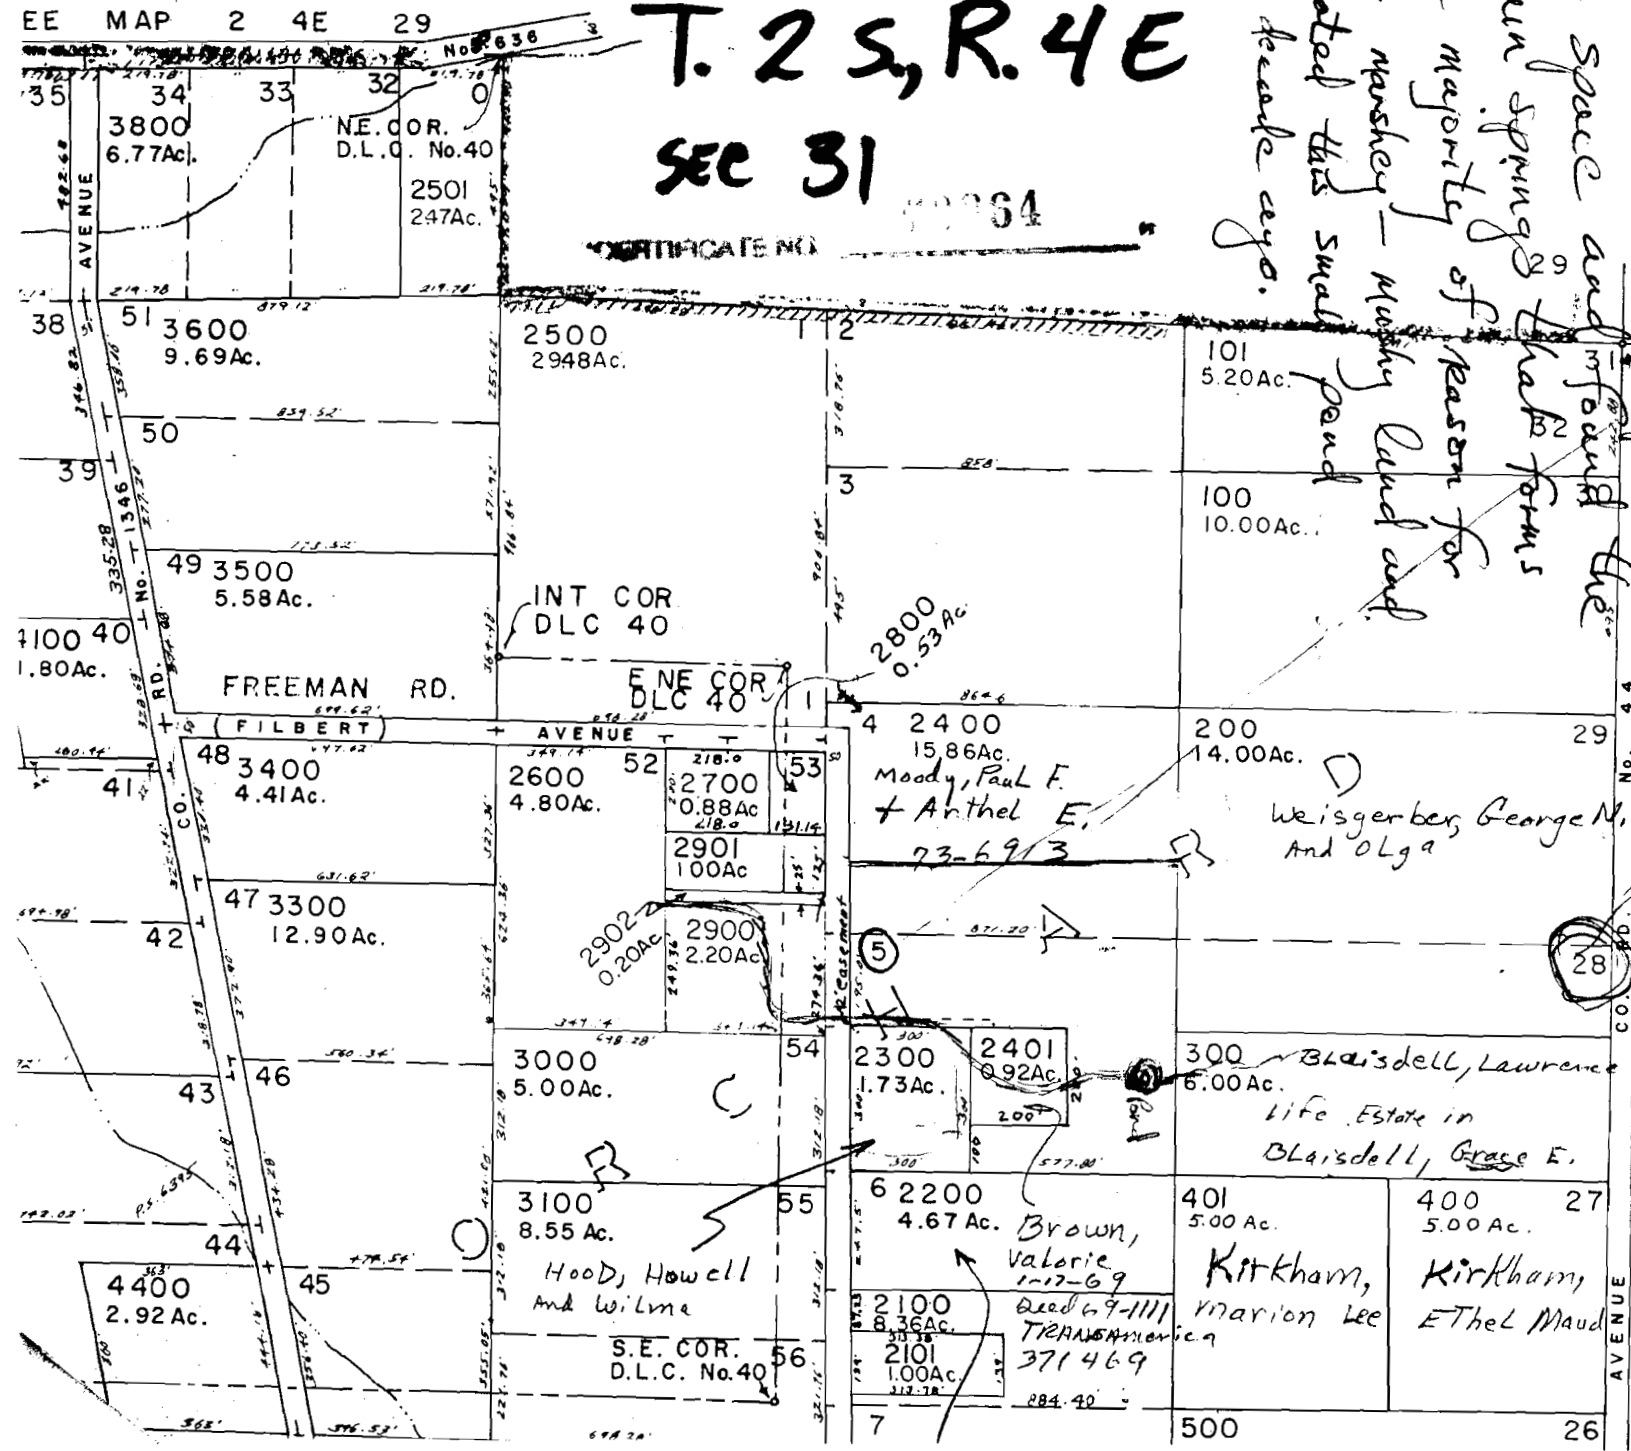


PHILIP FOSTER NO. 37
J.W. FOSTER NO. 40

CLACKAMAS COUNTY

$$I^M = 400'$$

SEE MAP 2 4E 29

SCALE 1:9600

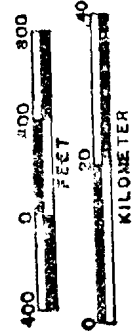

TL	ADD
1700	23888
2101	25260
2700	27937
2901	22815
4901	25020
5703	30443
5801	30520
6000	24375
	24443
7602	24221
7701	24283

RECEIVED
FEB 27 1995
DEPT. OF REVENUE
STATE OF OREGON

SEE MAP 2 4E 31

NOTED ON 2 APR 51

108-17

E.F.U.- 20

RRFF-5 108-03

UNRECORDED PLAT
OF EAGLE CREEK
FARMS

22500

CANCELLED T.L'S

3700
7100
5101
5702
5502
5301
5802
600
4690
5500
5501
6902
5892
5803
5890
800
5103
5394
5704

SEE MAP 2 4E '33

23500

work map MK 1/94

5023000m N.

T. 2 S.


T. 3 S.

5021
20'

5019

5018

SW
MND

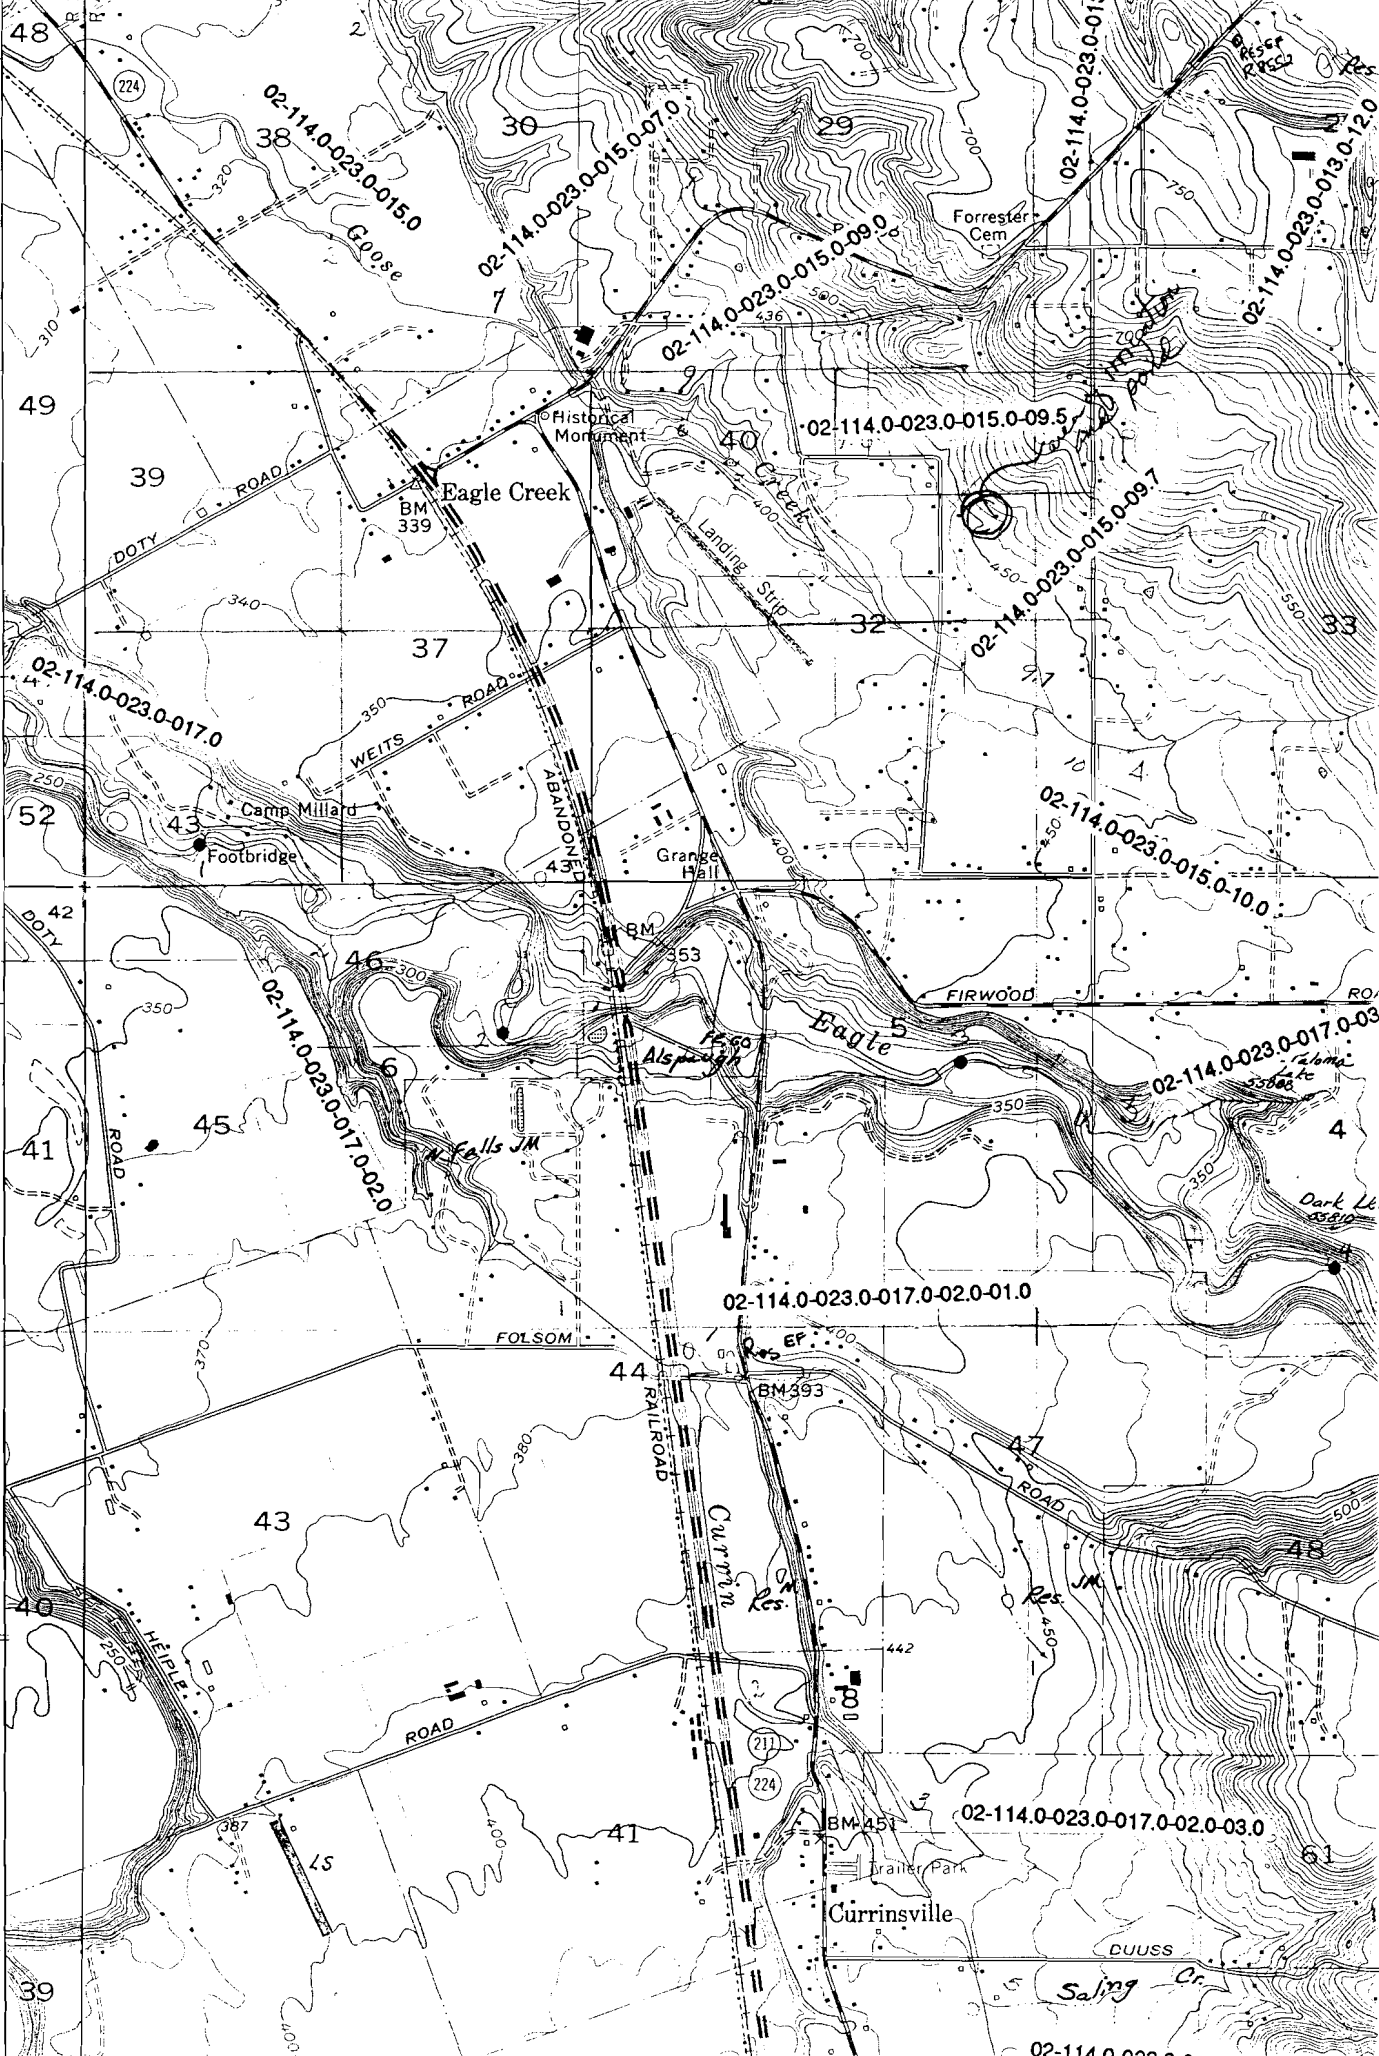

R-76956
work sheet

~~58156~~

1/96

No Final Proof Map available

No Permit Map available