

58-3

C.S. No. 13,451
C.S. No. 16,231

3/4" I.P.
N 89° 40' 05" E 15.55
SAID TO BE 1/16 COR.
C.S. 16,231

FOR ASSESSMENT
PURPOSES ONLY
DO NOT RELY ON
FOR ANY OTHER USE


NOTE:
EASEMENT 1004/566
N 01° 40' W 413.28 FROM
THE S.E. COR SEC 10;
THENCE S 24° 38' 20" W 9.55'
TO AN IRON ROD; THENCE
S 88° 28' 20" W 185.65 ...

WASHINGTON COUNTY
DEPARTMENT OF
ASSESSMENT & TAXATION

SEP 13 1991

FOR ASSESSMENT PURPOSES
ONLY - DO NOT RELY ON
FOR OTHER USE

2S 3 10D

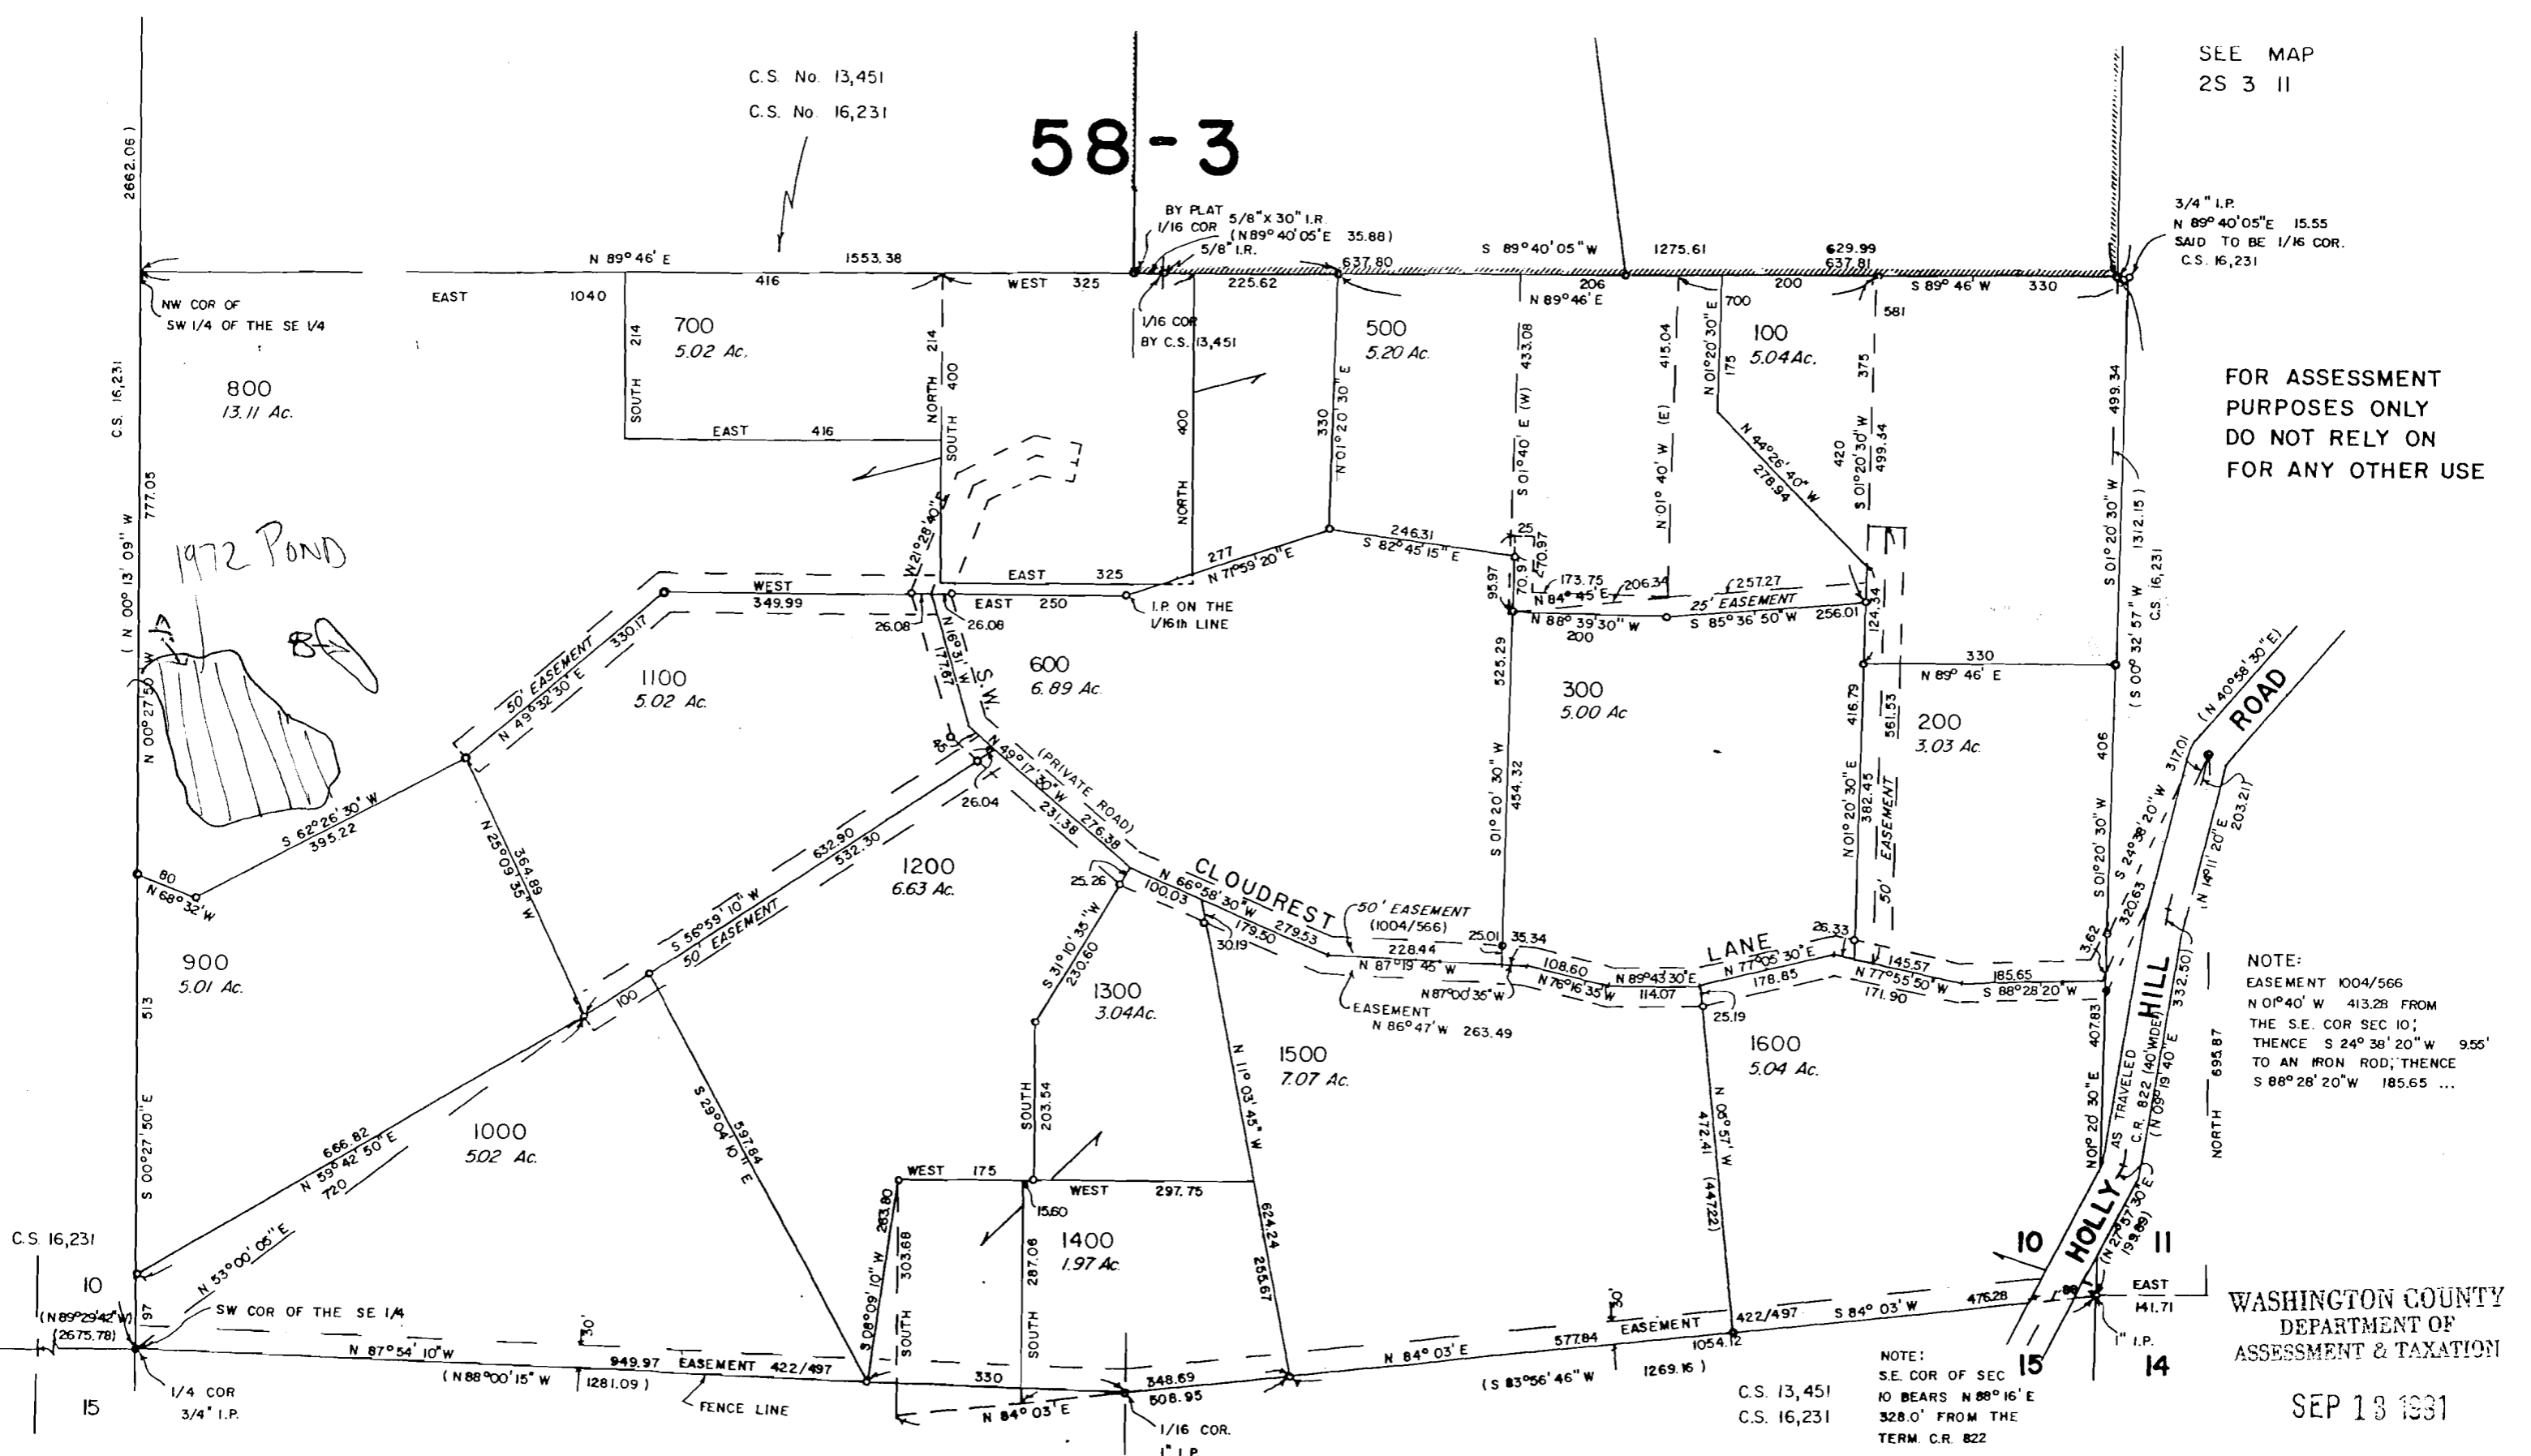

YAMHILL COUNTY

SECTION 15
T2S R3W

Application No R-76957
Permit No.

NOTE:
S.E. COR OF SEC
10 BEARS N 88° 16' E
328.0' FROM THE
TERM. C.R. 822

C.S. 13,451
C.S. 16,231

C.S. 16,231

2662.06

C.S. 16,231

(N 00° 13' 09" W
777.05

N 00° 27' 50" W
513

(N 89° 23' 42" W
2675.78)

15

N 89° 46' E
1040

1553.38
416

WEST 325

BY PLAT
1/16 COR
5/8" I.R.
5/8" x 30" I.R.
(N 89° 40' 05" E 35.88)
5/8" I.R.

S 89° 40' 05" W
1275.61

629.99
637.81

S 89° 46' W
330

499.34

800
13.11 Ac.

700
5.02 Ac.

500
5.20 Ac.

100
5.04 Ac.

1100
5.02 Ac.

600
6.89 Ac.

300
5.00 Ac.

200
3.03 Ac.

1200
6.63 Ac.

1300
3.04 Ac.

1500
7.07 Ac.

1600
5.04 Ac.

900
5.01 Ac.

1000
5.02 Ac.

1400
1.97 Ac.

SW COR OF THE SE 1/4

(N 88° 00' 15" W
1281.09)

EASEMENT 422/497
949.97

WEST 175

WEST 297.75

SOUTH 287.06

N 84° 03' E
577.84

EASEMENT
422/497

S 84° 03' W
476.28

(S 83° 56' 46" W
1269.16)

15

14

10

11

