


Application No. R-76958  
 Permit No.

70881dc

SEE MAP 6 8 130

SEE MAP 6 8 13A

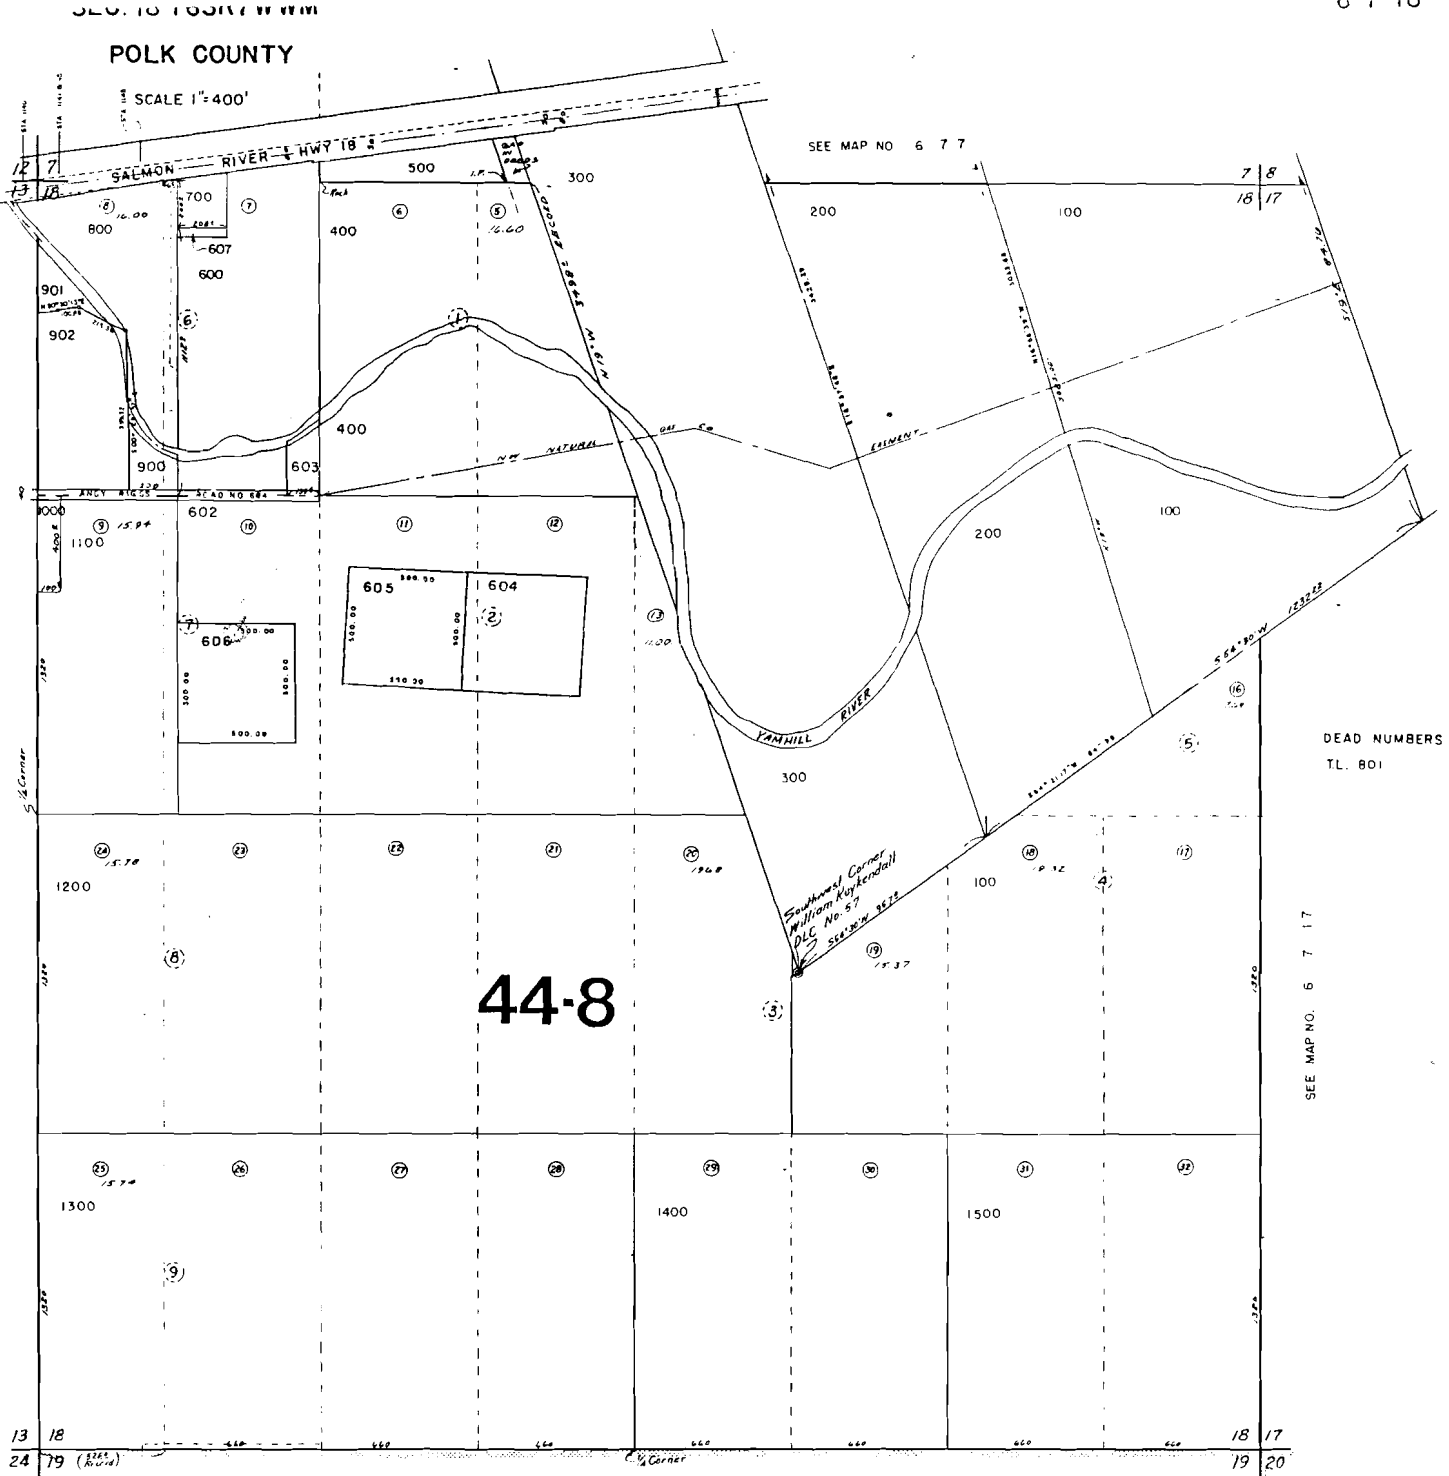

SEE MAP NO 6 7 19

2--Orn, Survey Lot Numbers

RECEIVED

JAN 3 1995

PLANNING & ZONING DEPT.  


Application No. R-76958  
Permit No.

CERTIFICATE NO. 100066

**IMPORTANT**  
This Map for Assessment  
and Taxation Purposes  
**ONLY**

**SEC.18 T6S R7W WM**  
**POLK COUNTY**

Scale 1" = 400'

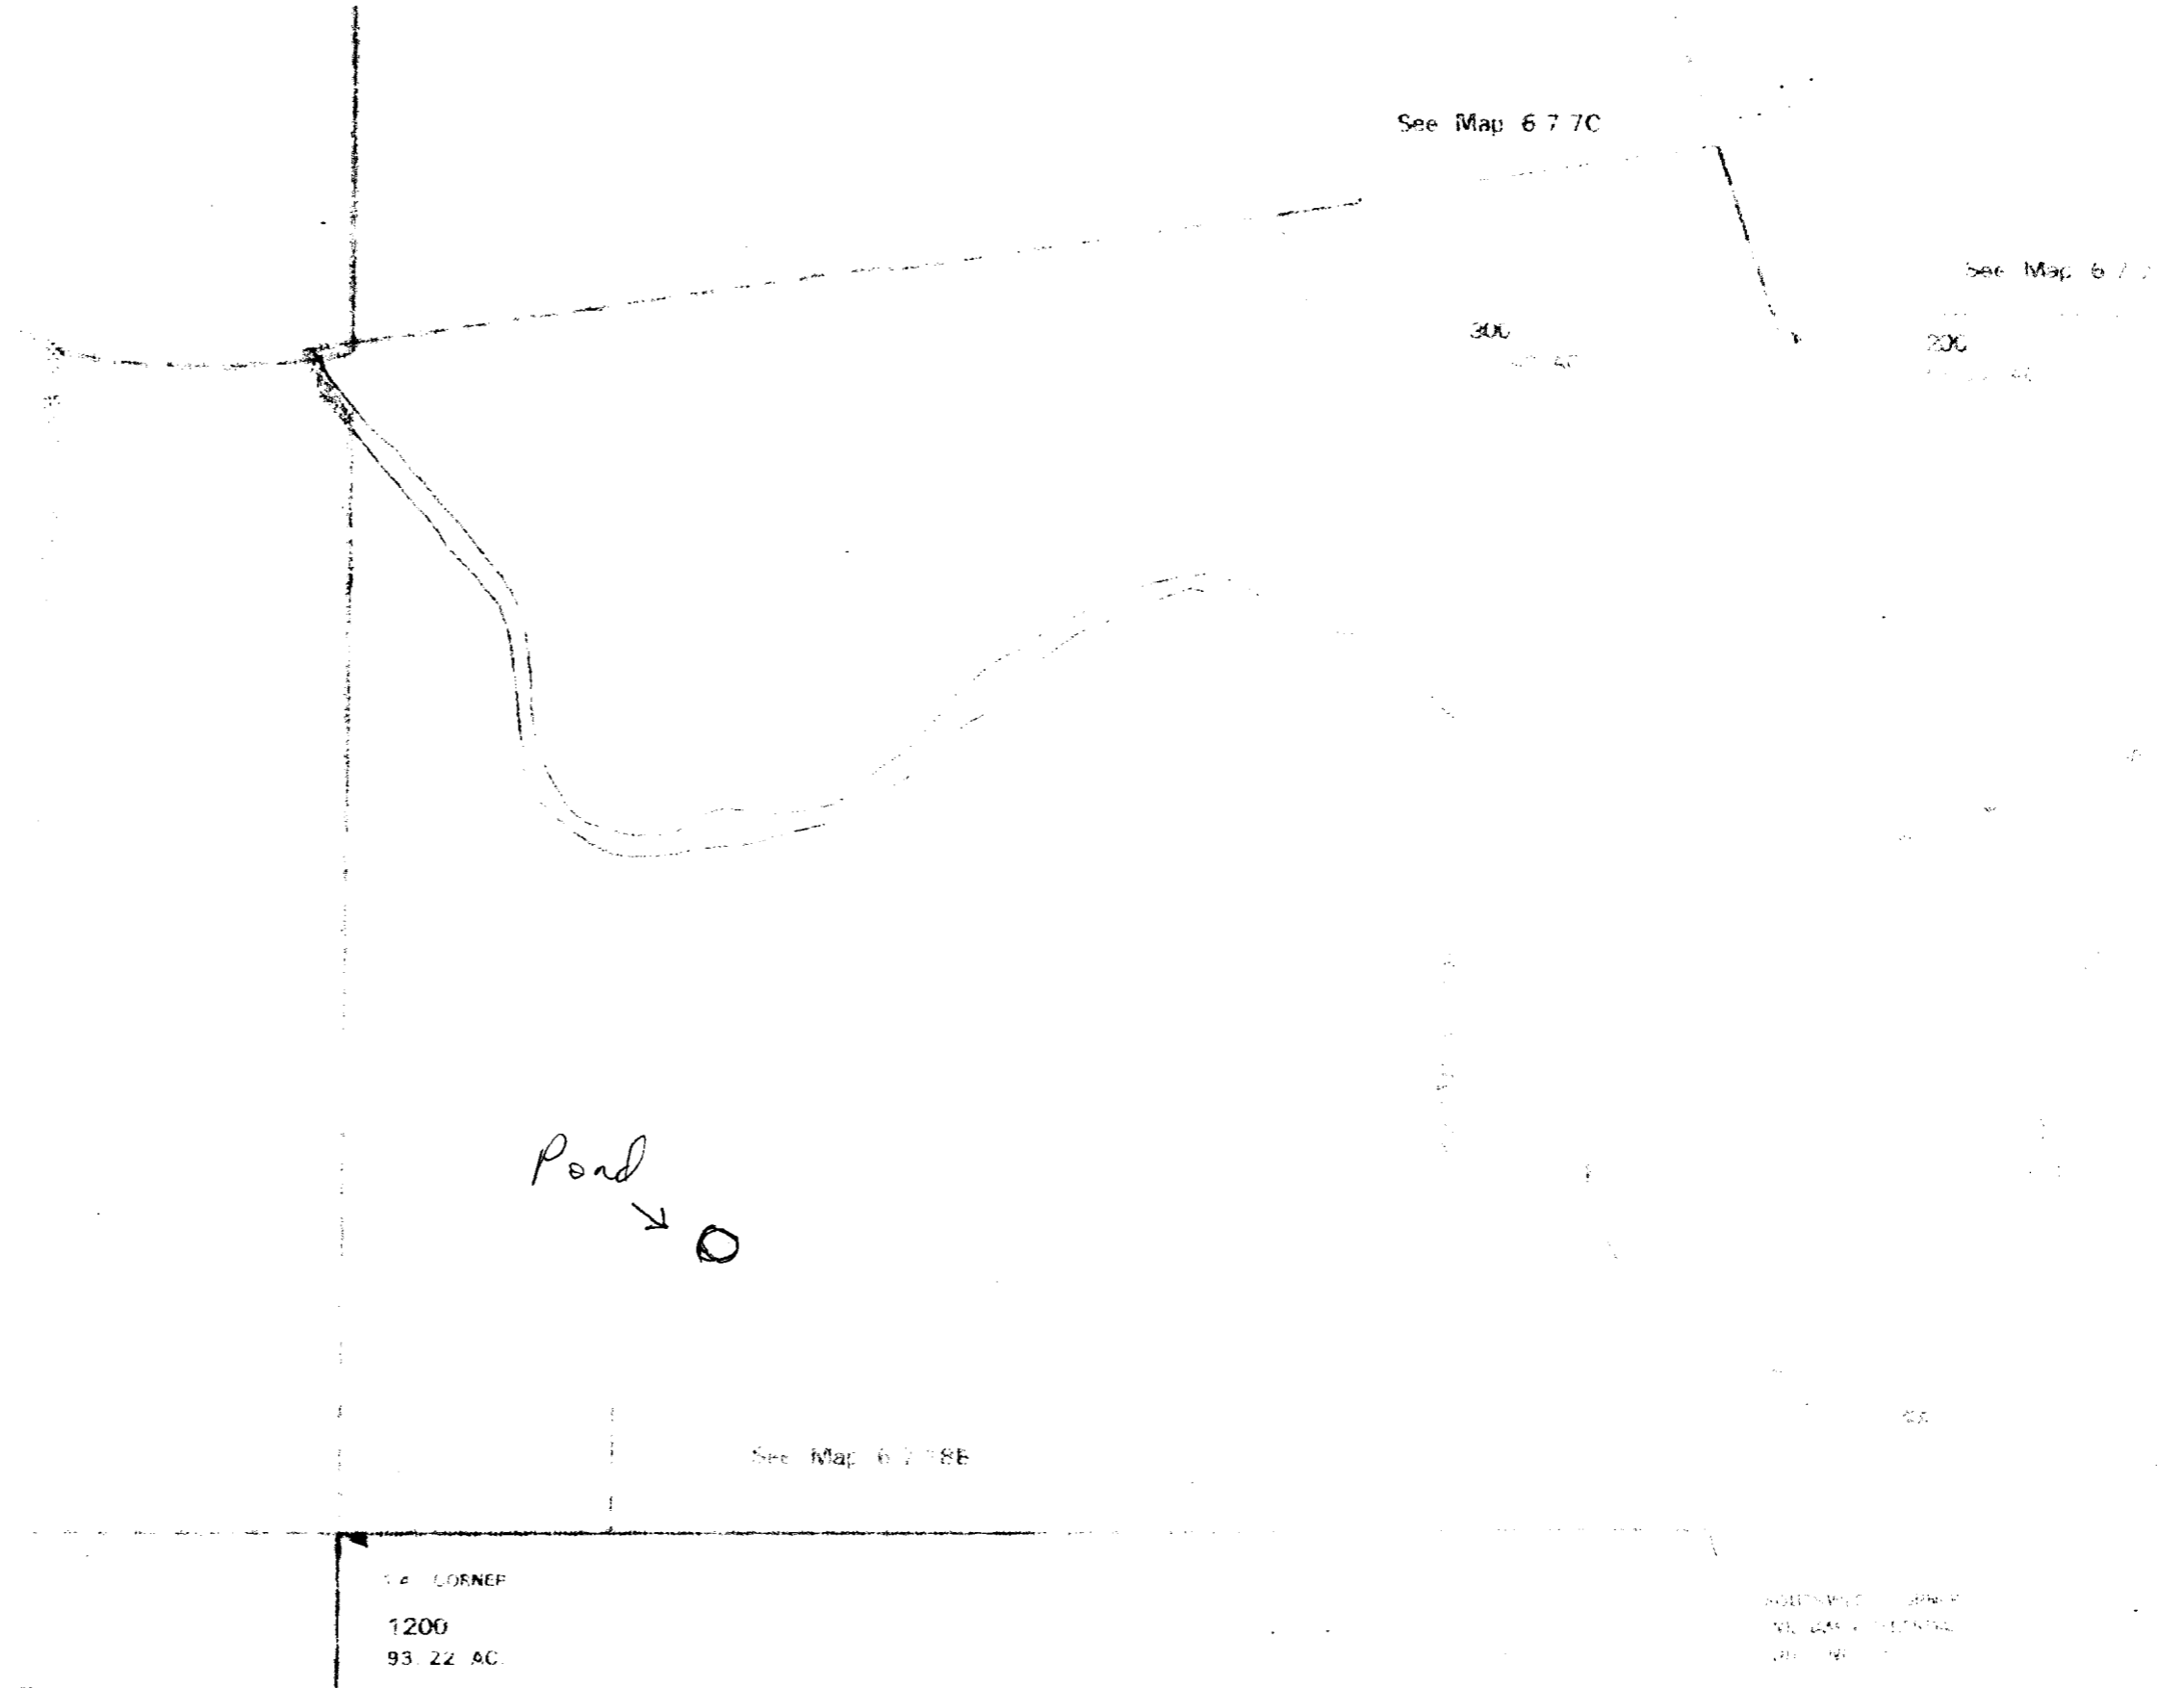

Pond → ○

1/4 CORNER  
1200  
93.22 AC.

See Map 6778E

See Map 6770

See Map 6772


No Final Proof Map available

No Permit Map available