


**IMPORTANT**  
This Map for Assessment  
and Taxation Purposes  
**ONLY**

**SEC.18 T6S R7W WM**  
**POLK COUNTY**  
Scale 1" = 400'

70868  
**Application No. R-76960**  
**Permit No.**

6.7.18

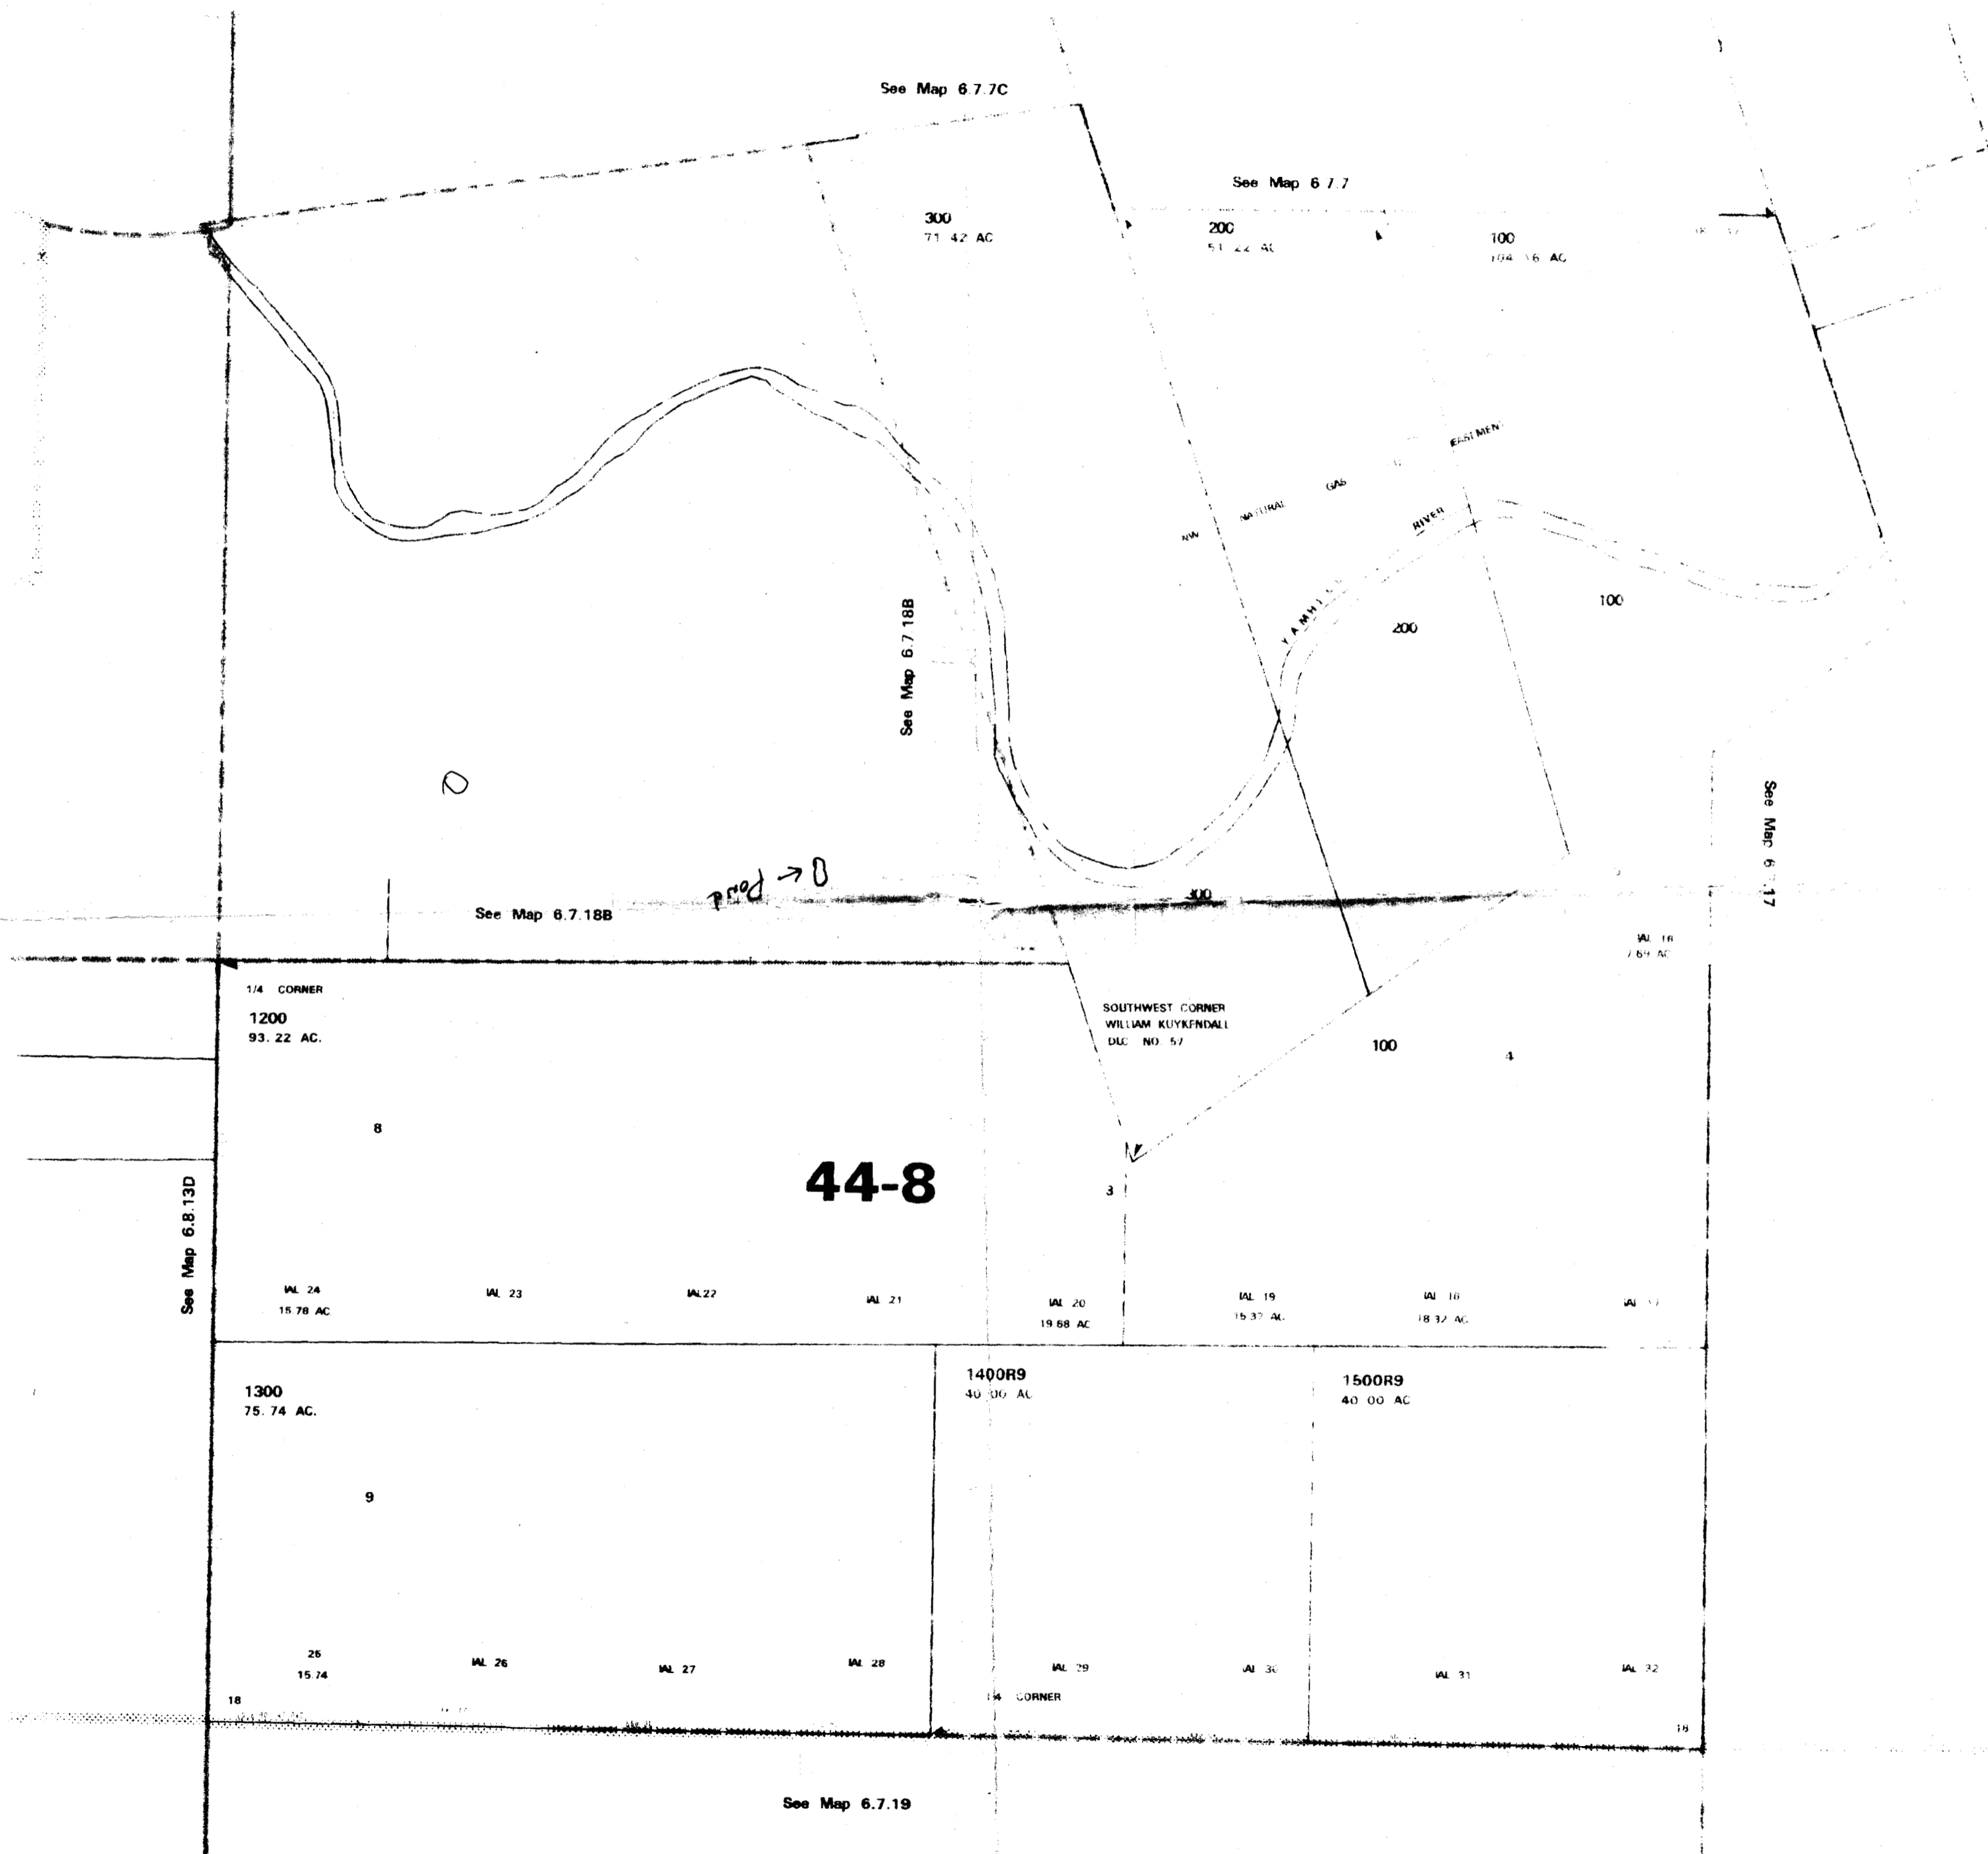

- Canceled No.**
- 400
  - 500
  - 600
  - 602
  - 603
  - 604
  - 605
  - 606
  - 607
  - 608
  - 700
  - 800
  - 900
  - 901
  - 902
  - 903
  - 1000
  - 1100
  - 801

See Map 6.7.19

6.7.18

No Final Proof Map available

No Permit Map available