



ROAD LOCATION MAP
BURNT TABLE TIMBER SALE

T. 38S., R. 3E., WILL. MER.
T. 39S., R. 3E., WILL. MER.

SEE SHEET FOR LEGEND

Application No. R-760960
Permit No.

1870

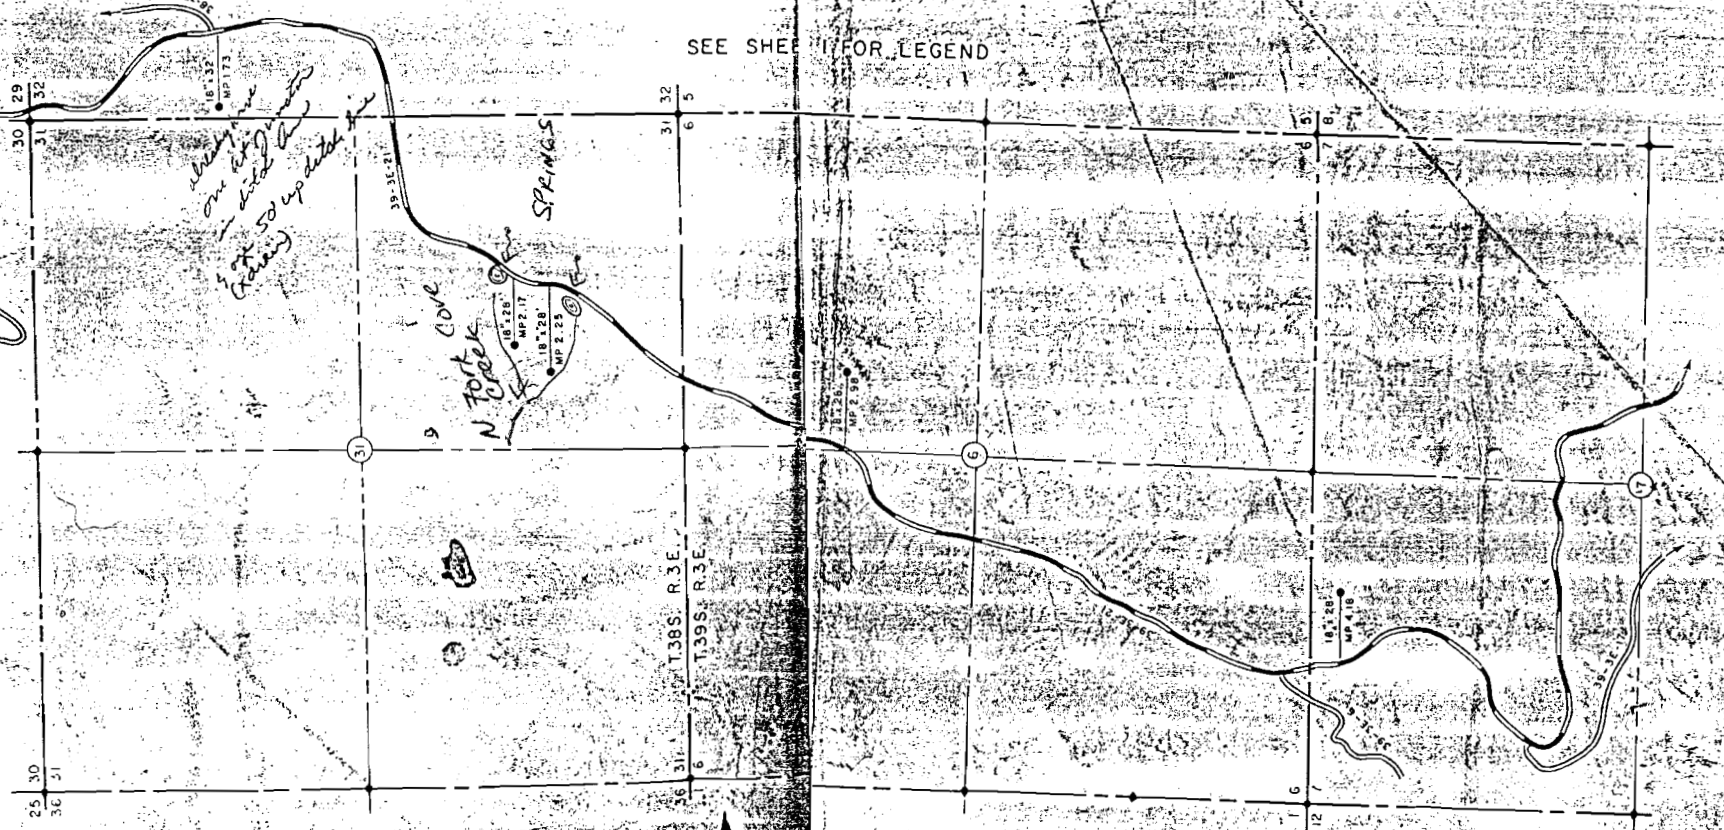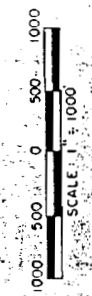

No Final Proof Map available

No Permit Map available