This map was prepared for assessment purpose only.

SECTION 21 T.29S. R. 6 W. W.M.
DOUGLAS COUNTY

1" = 400'

REVISED ON 8-25-94

RECEIVED DEC 23 1994 ... RESOURCES DEP. SALEM, OREGON

29 6 21

CERTIFICATE NO. 70872

Application No. R-76986
Permit No.

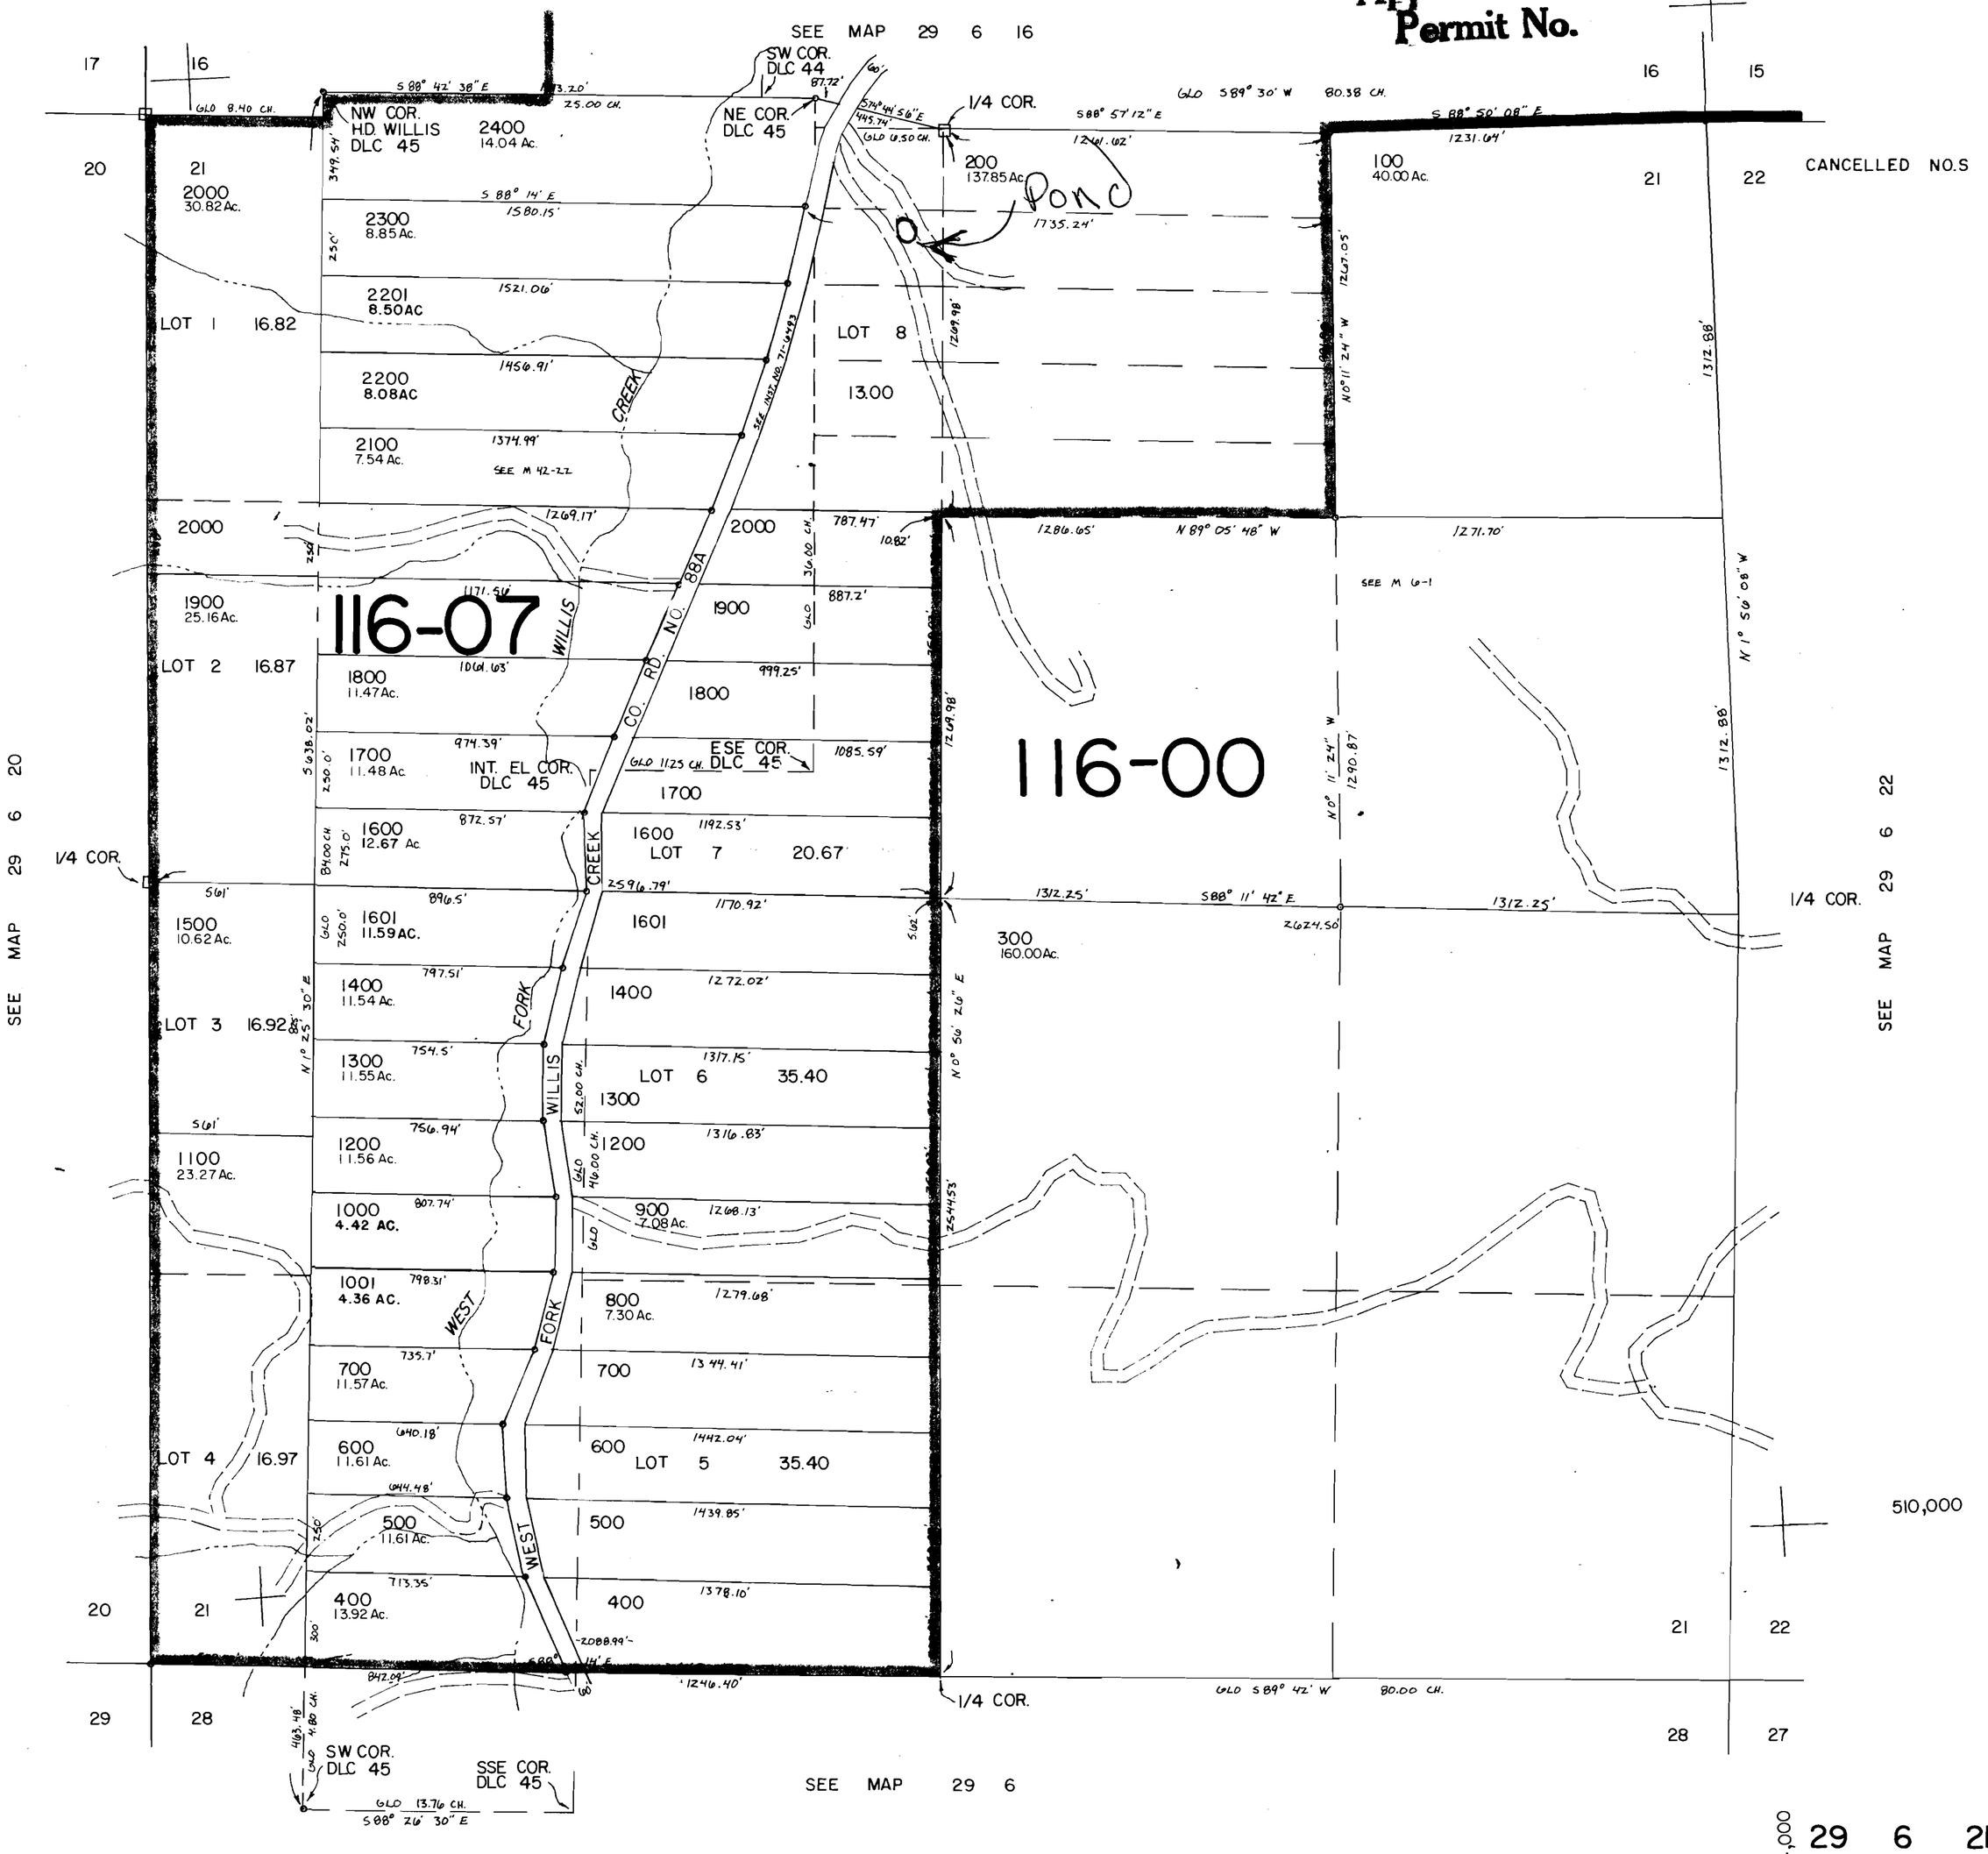

29 6 21