

THIS MAP WAS PREPARED FOR
ASSESSMENT PURPOSE ONLY.

REIVED

29 1994


SOURCES DEP
A, OREGON

70875

1"-400"

Application No. R-76989
Permit No.

"CERTIFICATE NO. ~~SEE MAP 27 41~~

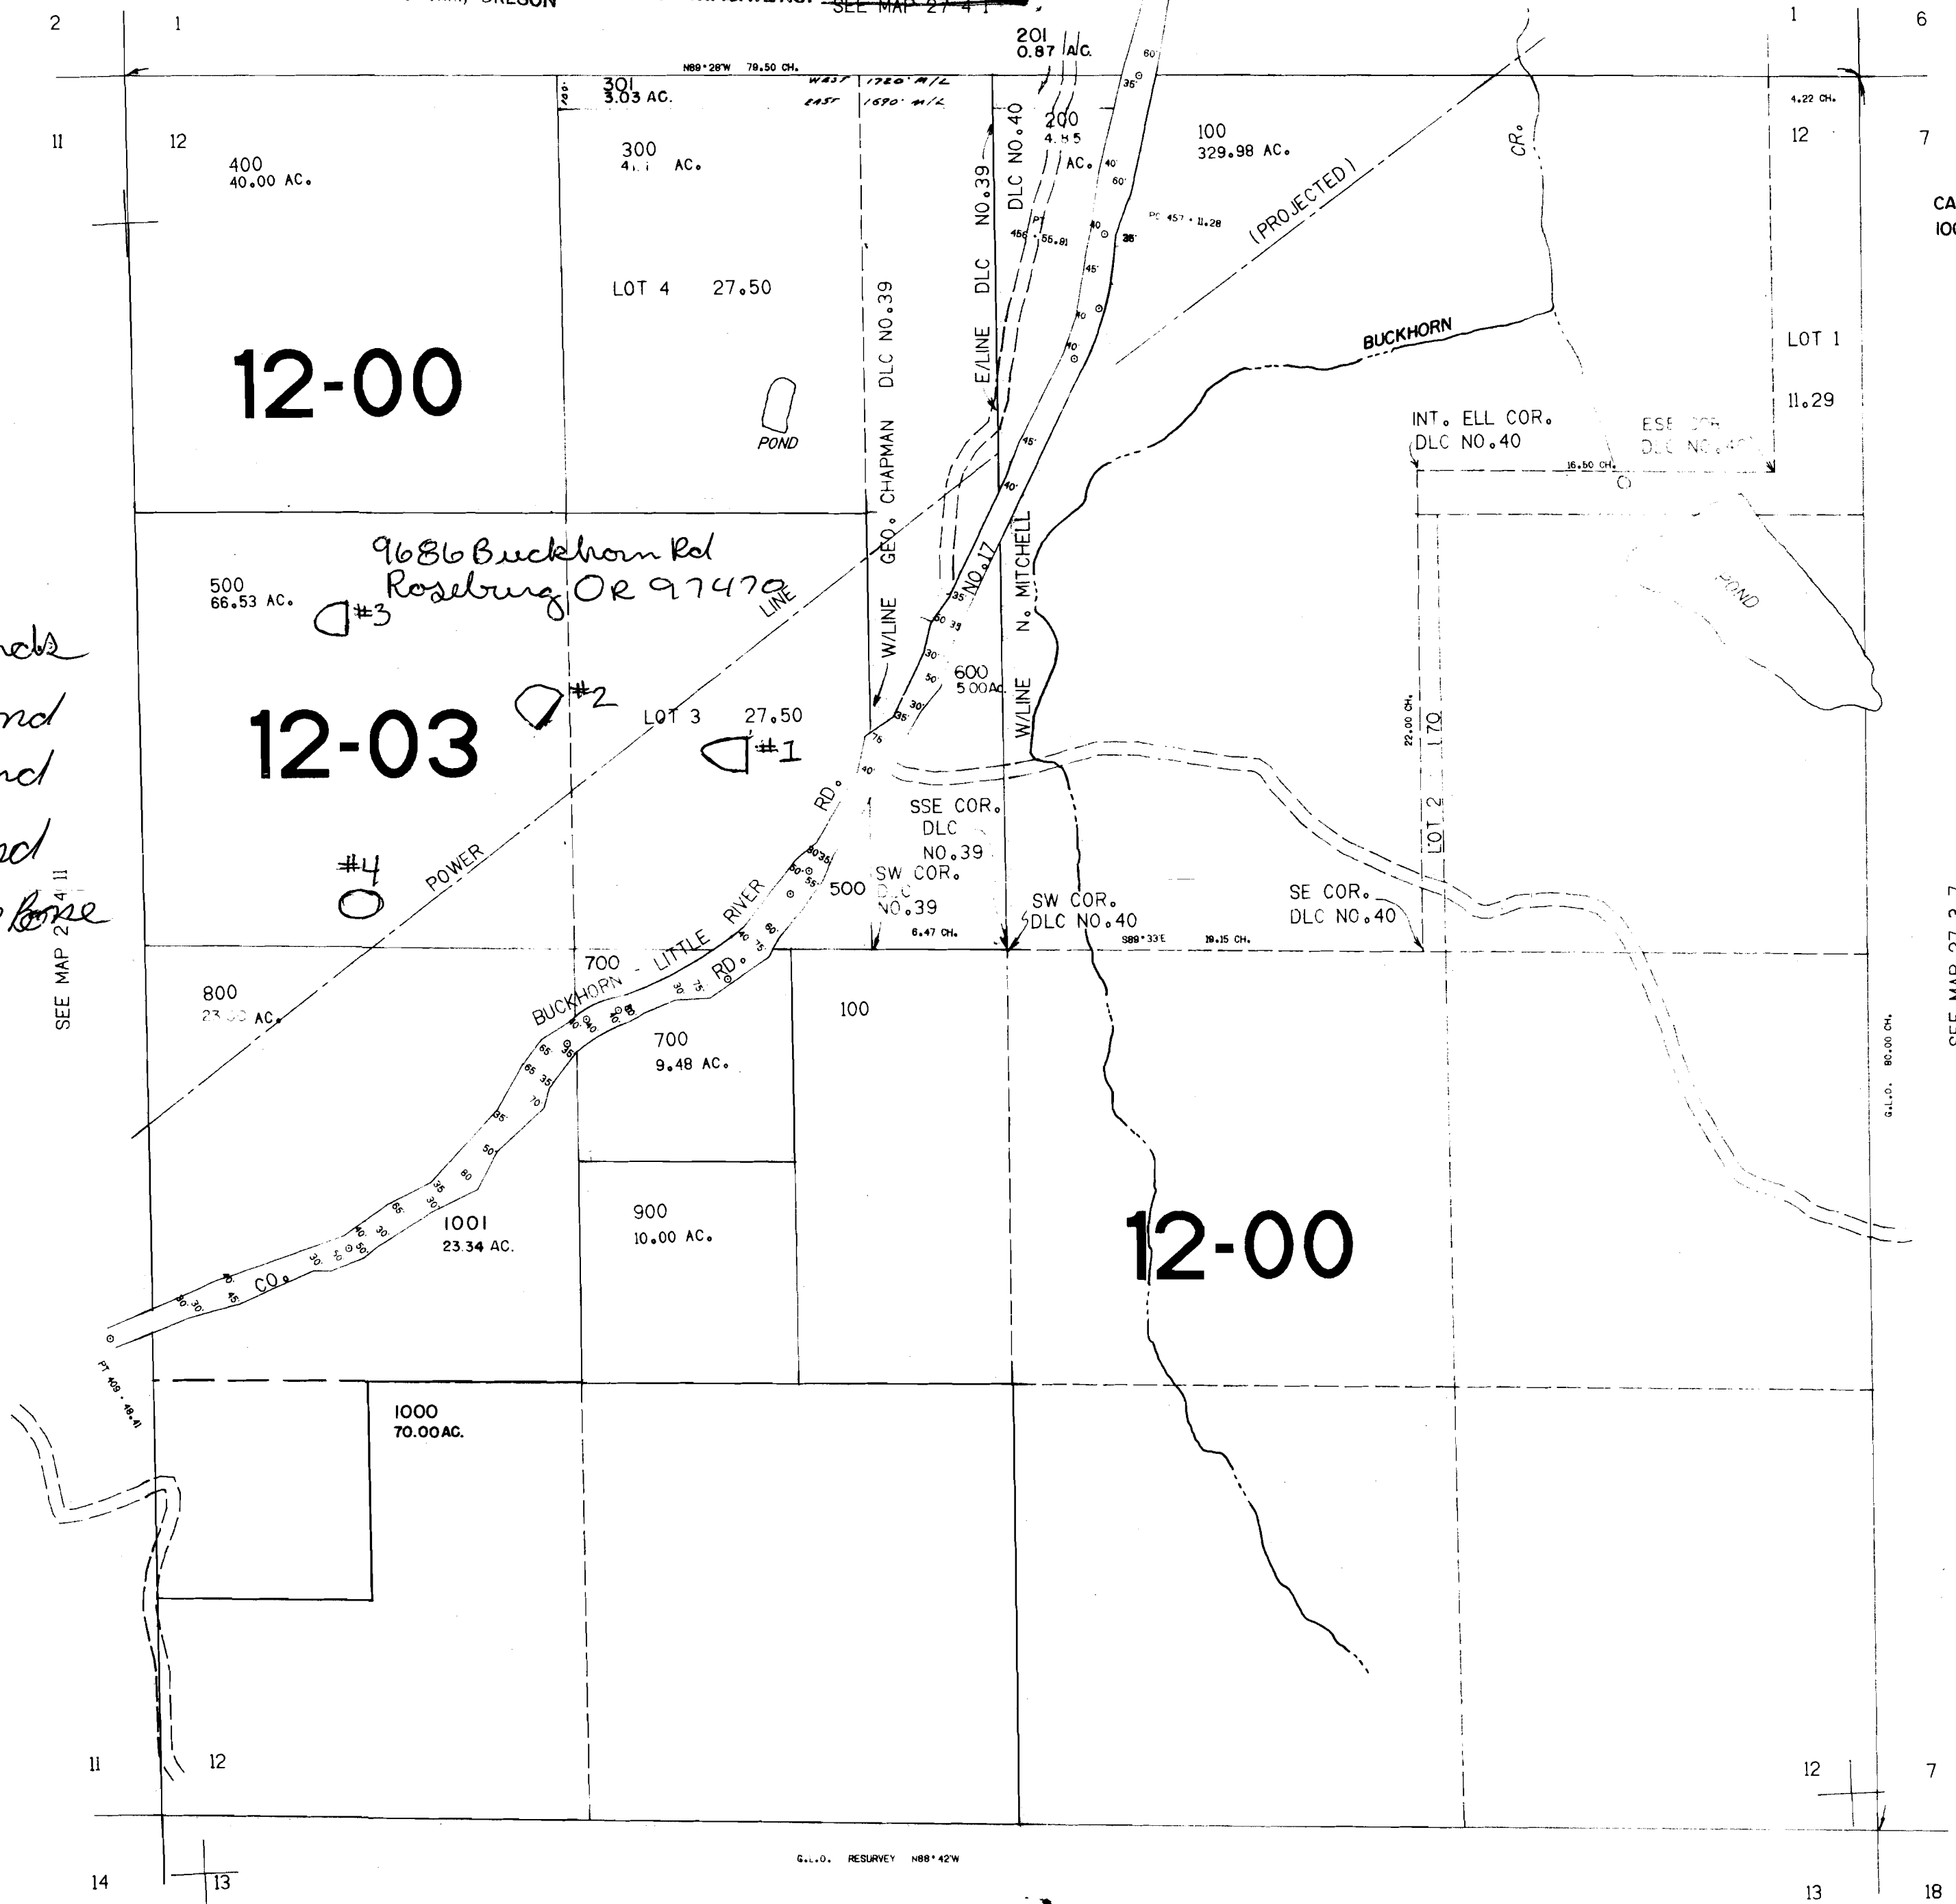

aspen Sheet

names of Ponds

#1 Bonnie Pond

#2 Jean Pond

#3 Glen Pond

Little Buck Pond

CANCELLED NO'S
1002

SEE MAP 27 3 7

80.000

27 4 12

1.305.000

SEE MAP 27 4 13

G.L.O. RESURVEY N88° 42'W

No Final Proof Map available

No Permit Map available